


SUBMAIN 10, W. I. S.

UTILITY CONTRACTORS INC.
JAN. 28, 1965, BK. NO. K-78
PROJ. NO. C22-4

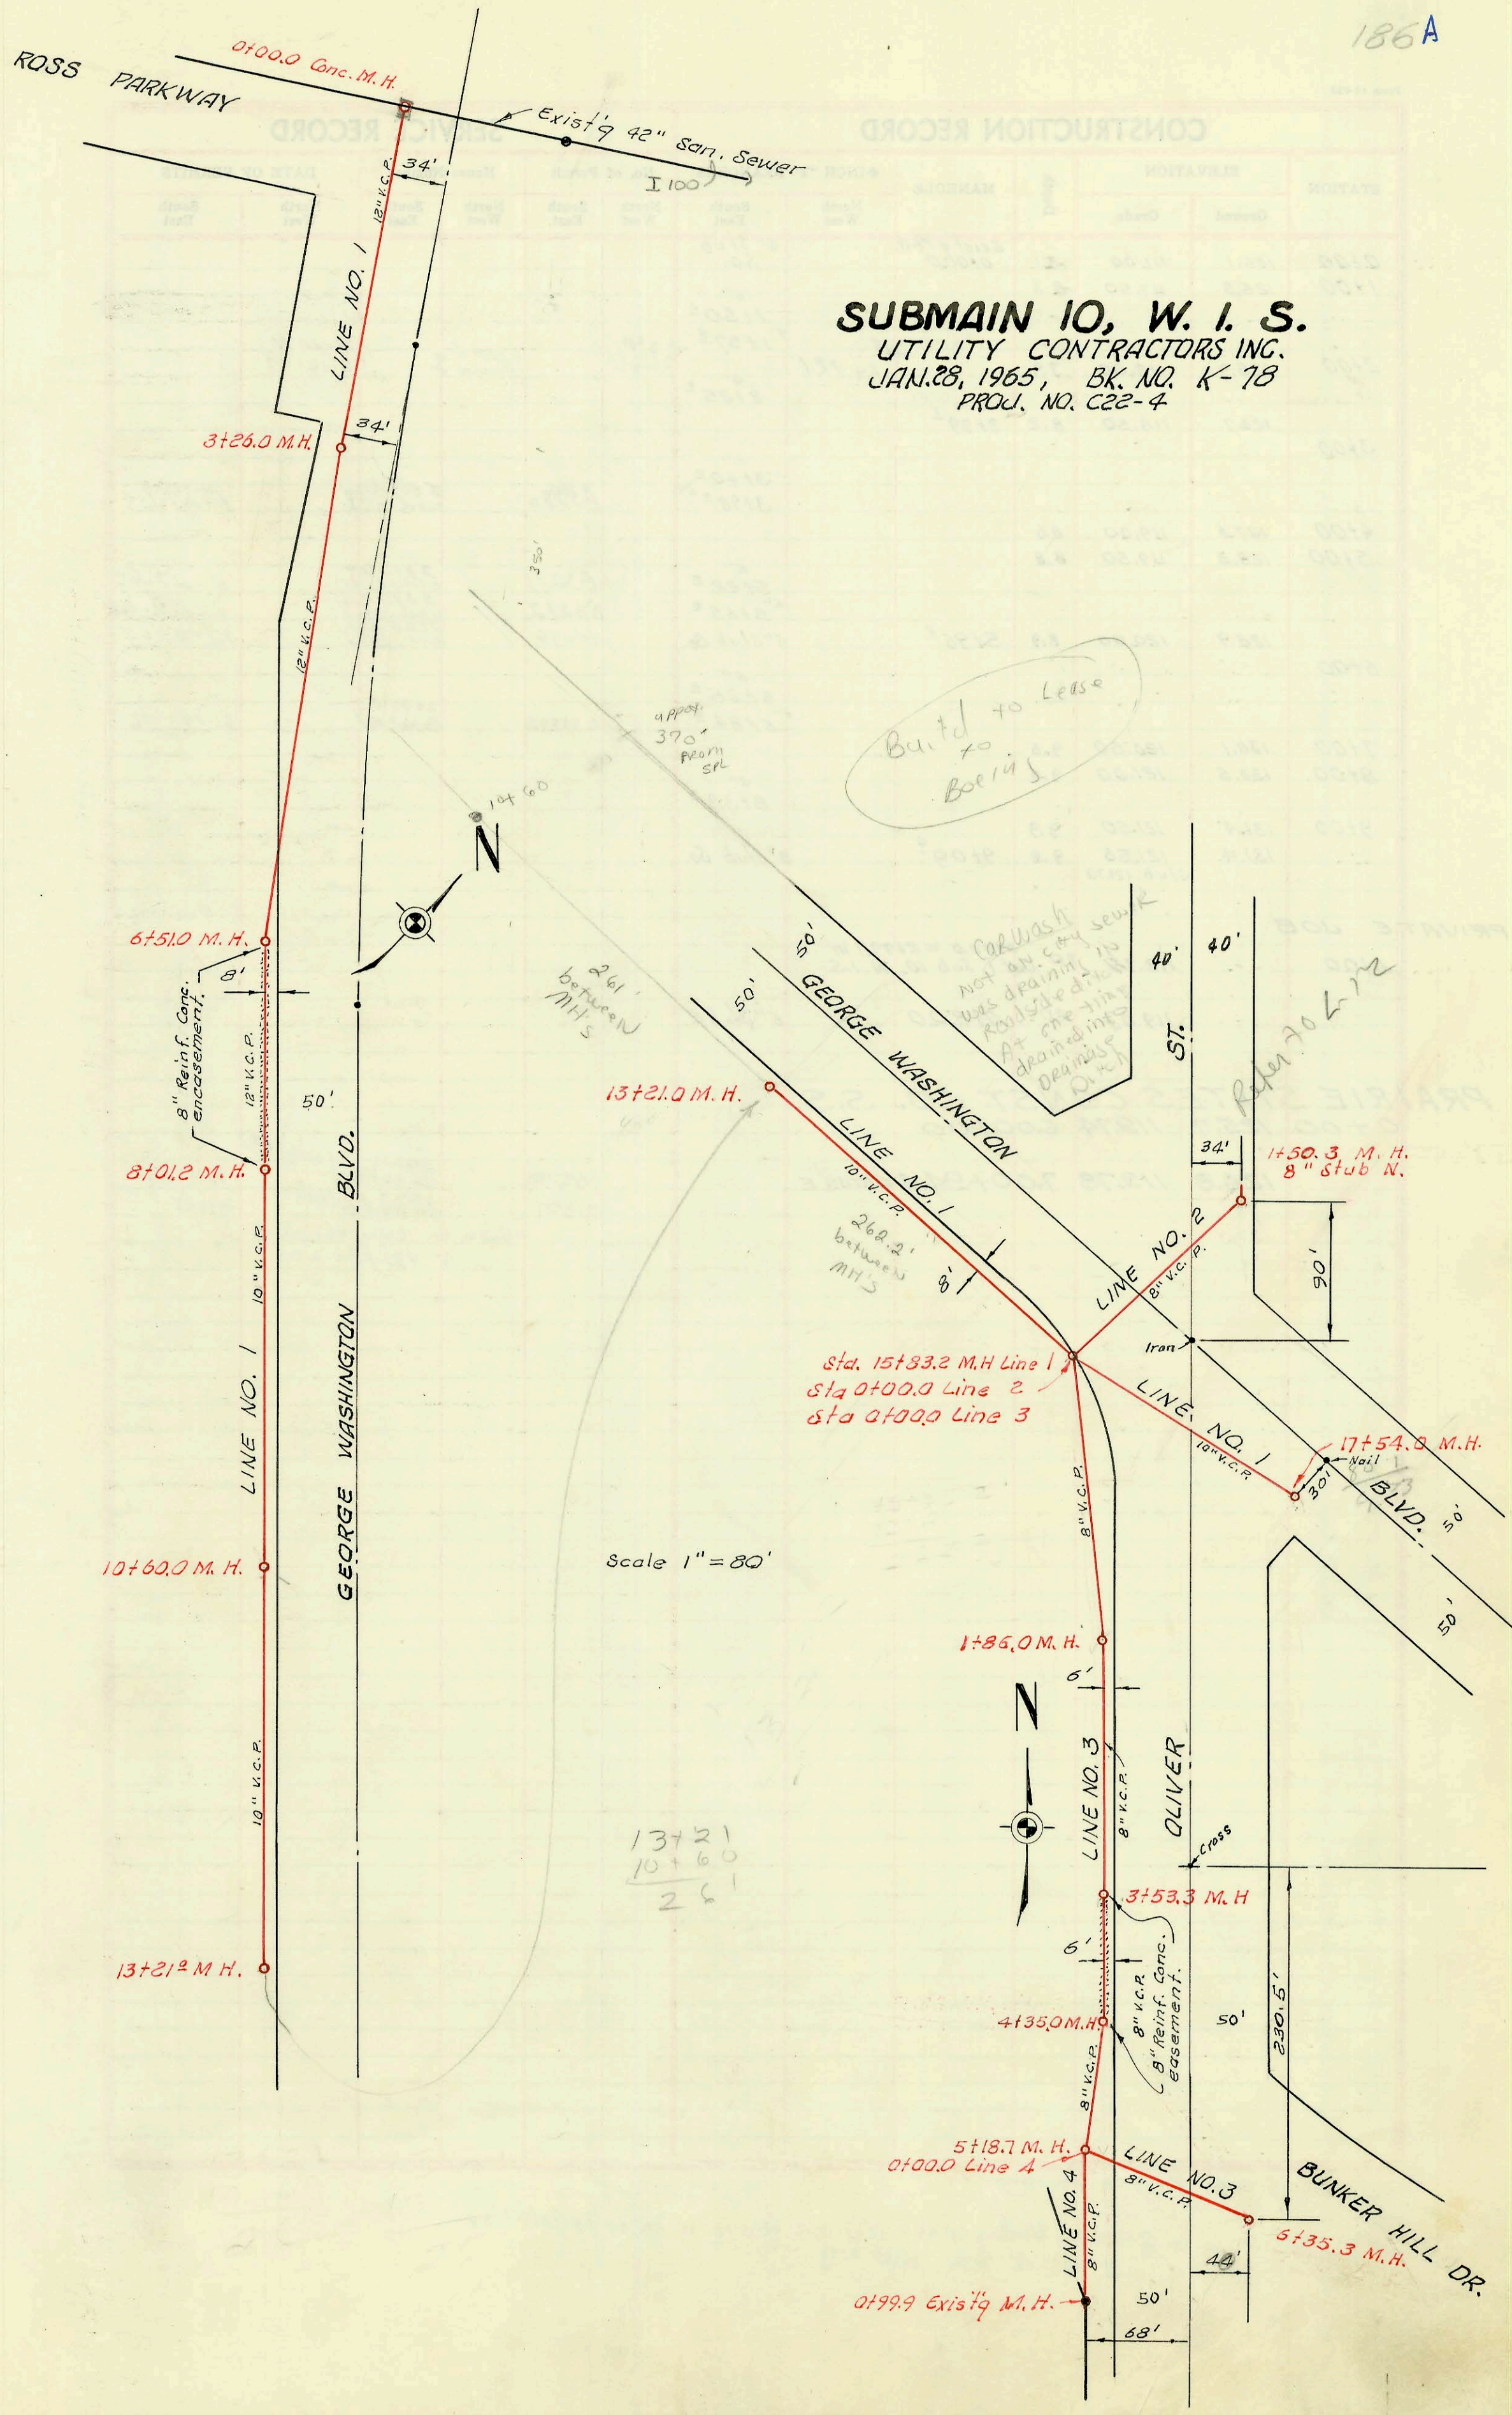

K

13+21
 10+60

 261

CONSTRUCTION RECORD

SERVICE RECORD

STATION	ELEVATION		Depth	MANHOLE	4-INCH "Y" BRANCHES		No. of Permit		House Number		DATE OF PERMITS	
	Ground	Grade			North West	South East	North West	South East	North West	South East	North West	South East
LINE NO. 1	0+00	116.3	104.25	12.0	0+00 ²							
	1+00	116.7	104.41	12.3								
	2+00	118.8	104.57	14.2								
	3+00	119.3	104.73	14.6								
		121.6	104.77	16.8	3+26 ²							
	4+00	118.4	104.89	13.5								
	5+00	117.1	105.05	12.0								
	6+00	115.0	105.21	9.8								
		114.5	105.29	9.2	6+51 ²							
	7+00	113.2	105.37	7.8								
	8+00	114.0	105.53 out	8.5								
		114.0	109.47 in	4.5	8+01 ²							
	9+00	117.2	109.87	7.3								
	10+00	120.2	110.27	9.9								
		117.6	110.51	7.1	10+60 ²							
	11+00	116.5	110.67	5.8								
	12+00	119.0	111.07	7.9								
13+00	120.6	111.47	9.1									
	120.3	111.55	8.7	13+21 ²								
14+00	121.3	111.87	9.4									
15+00	123.2	112.27	10.9									
	124.5	112.60 out	11.9									
		115.25 in	9.2	15+83 ²								
16+00	124.7	115.32	9.4									
17+00	124.0	115.72	8.3									
	125.4	115.94	9.5	17+54 ²								
LINE NO. 2	0+00	124.9	115.40	9.5	0+00 Line 2 = 15+83 ² line 1							
	1+00	123.9	115.80	8.1								
		124.4	116.00	8.4	1+50 ³ 8" stub North							
		116.10 stub N										
LINE NO. 3	0+00	124.9	112.76	12.1	0+00 Line No. 3 = 15+83 ² Line No. 1							
	1+00	127.5	113.16	14.3								
			113.50		1+86 ²							
	2+00	125.8	113.56	12.2								
	3+00	124.0	113.96	10.0								
		122.7	114.16	8.5	3+53 ³							
	4+00	127.4	114.40 out	12.9								
			114.98 in	12.4	4+35 ²							
5+00	127.0	115.26 out	11.7									
	127.1	113.32 out	13.8									
		113.42 in	13.7	5+18 ²								
6+00	126.8	115.76	11.0									
	126.2	115.89	10.3	6+35 ³								
LINE NO. 4	0+00	127.1	119.30	7.8	0+00 line 4 = 5+18 ² line 3							
		133.0	119.70	13.3	Existg M.H. 0+99 ²							

K