


K 194A

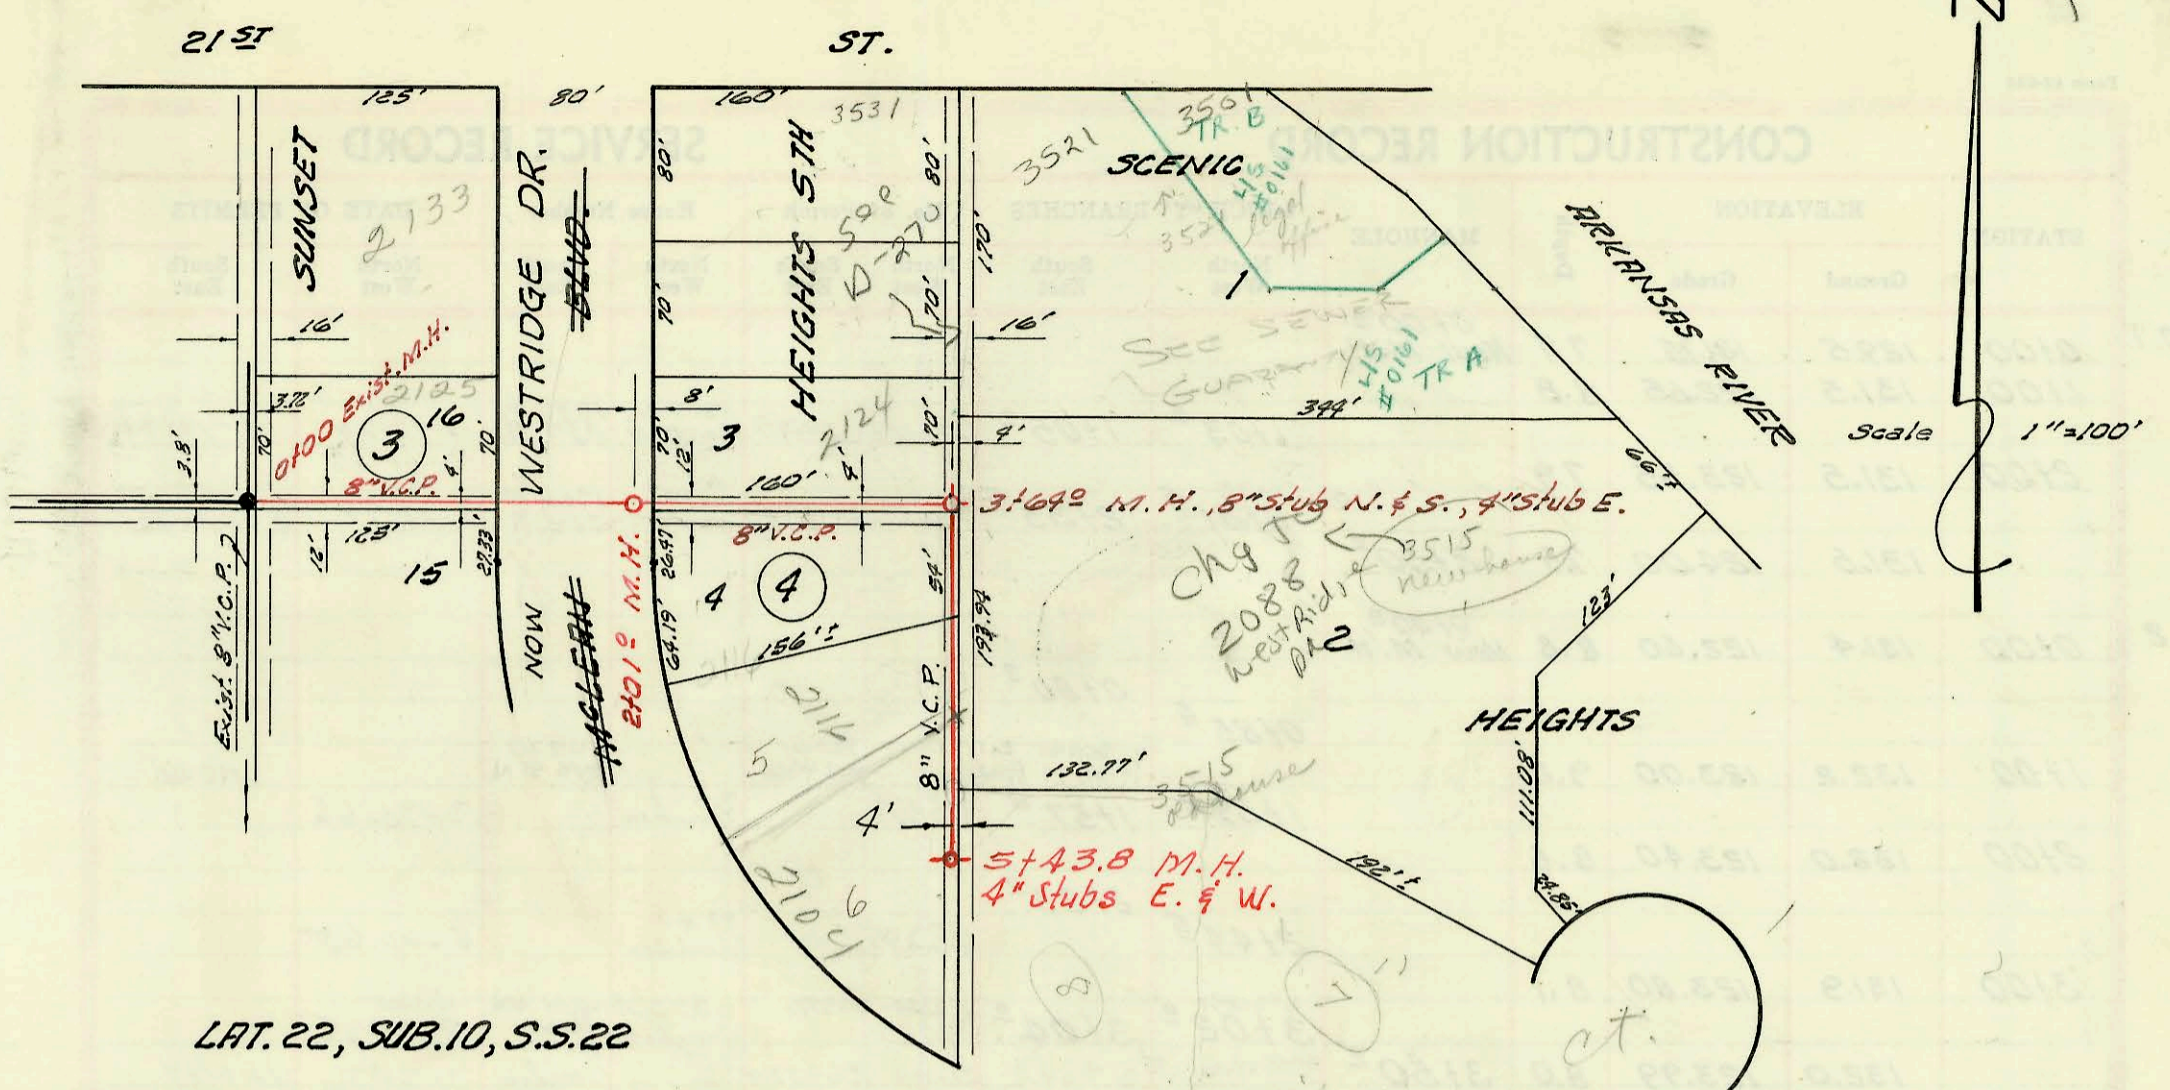

LAT. 22, SUB. 10, S.S. 22

PRIVATE , K-78 , BOOKED 3-12-65
 EXTENSION PRIVATE CONTRACT
 MAR. 10, 1966 BK. NO. K-85
 STA. 3164.0 TO STA. 5143.8

save

X

CONSTRUCTION RECORD						SERVICE RECORD						
STATION	ELEVATION		Depth	MANHOLE	4-INCH "Y" BRANCHES		No. of Permit		House Number		DATE OF PERMITS	
	Ground	Grade			North West	South East	North West	South East	North West	South East	North West	South East
Lat. 22, Sub. 10, S.S. 22												
0+00	131.5	125.28	6.2	Exist. 0+00 ^o								
1+00	130.4	125.48	4.9									
2+00	130.7	125.68	5.0	2+01 ^o	2+84.4		669814		2124 Westridge		12-14-78	
3+00	131.7 132.2	125.88 126.01	5.8 6.2	3+69 ^o	3+18 ^o							
					8" Stub N. & S.	4" Stub E.		B3483		3515 W. 2124		5-25-65
4+00	132.4	126.18	6.2			3+83 ^o						
						4+35 ^o						
5+00	132.7	126.38	6.3		4+51 ^o		043789		2116 Westridge		8-4-74	
						5+25.8 ^o		10080		2104 Westridge		1-31-84
	132.8	126.48	6.3	5+43 ^o	5+18 ^o	4" Stub E & W		B5242		3515 W. 2124 changed 2098 Westridge Ct		3-14-66

Row

K