
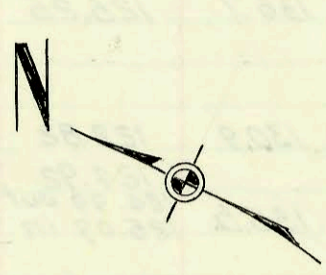


SERVICE RECORD CONSTRUCTION RECORD

STATION	ELEVATION	MARKER	LENGTH TO HEADINGS	NO. OF POINTS	CLASS NUMBER	DATE OF PERMITS
---------	-----------	--------	--------------------	---------------	--------------	-----------------

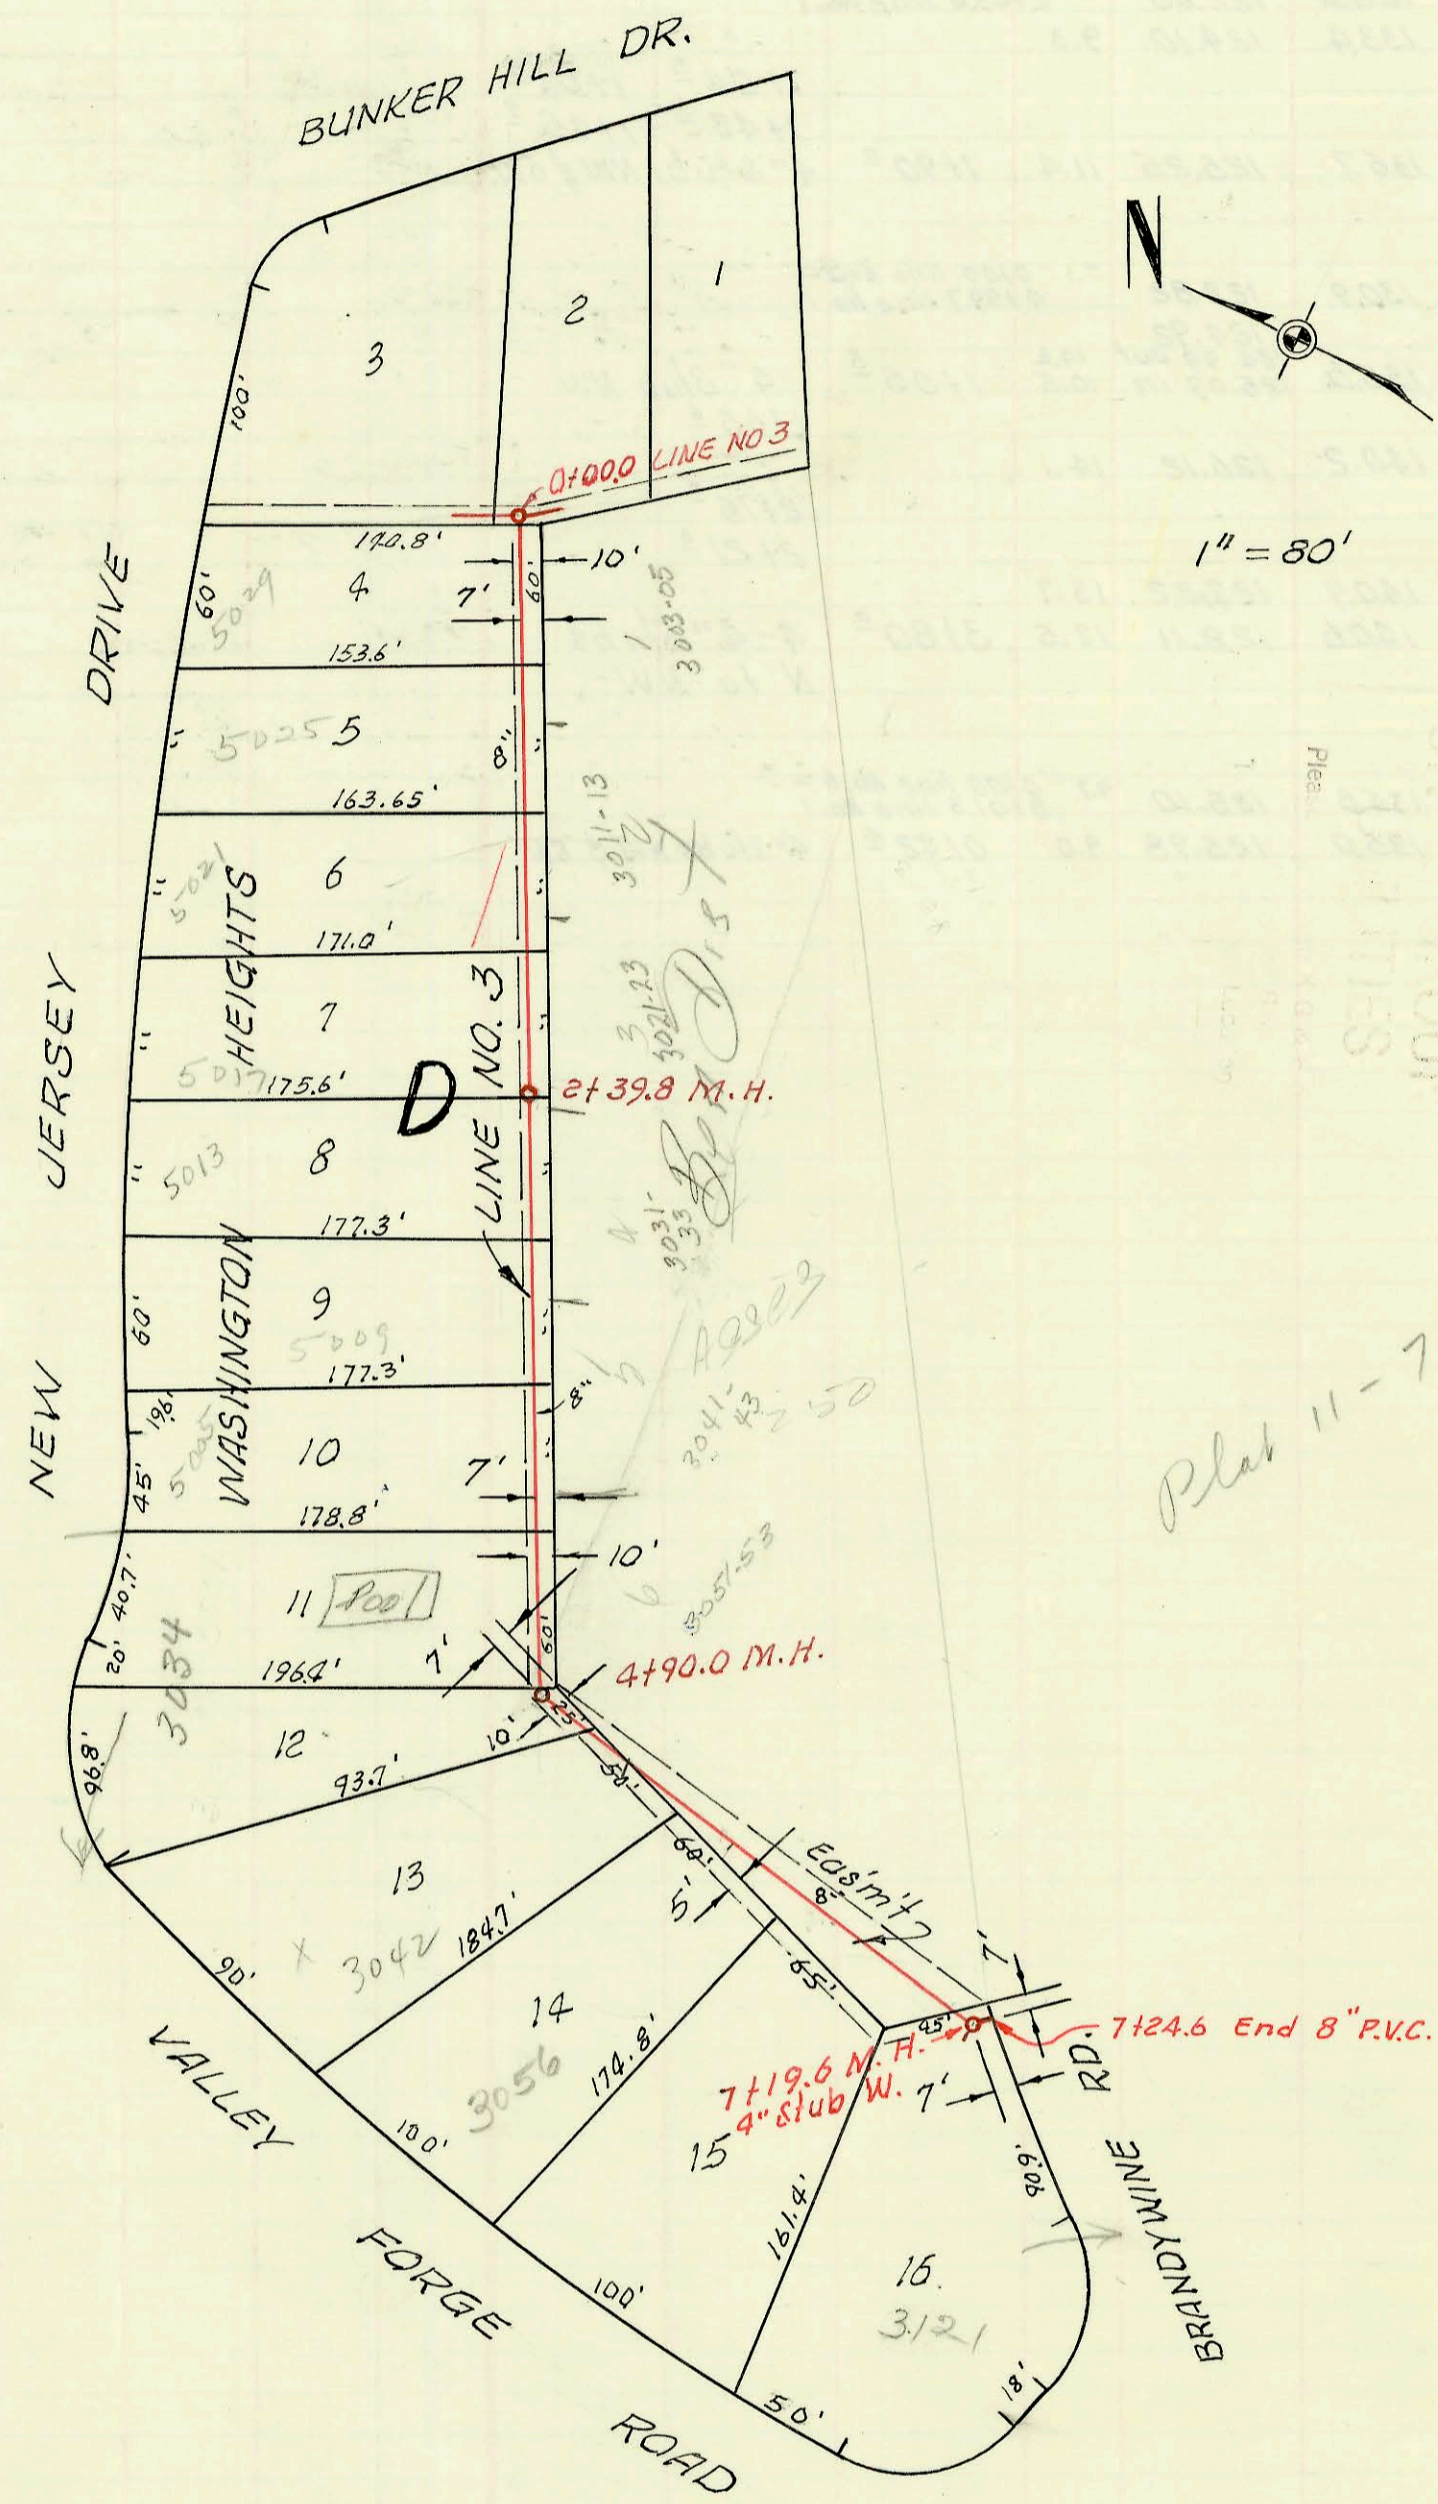

1" = 80'

Plot 11-71

CAUTION
UNDERGROUND
UTILITIES
 Please check with K G & E or
 Southern Bell
 Telephone Co. for Location

CONSTRUCTION RECORD

SERVICE RECORD

LINE NO. 3

STATION	ELEVATION		Depth	MANHOLE	4-INCH "Y" BRANCHES		No. of Permit		House Number		DATE OF PERMITS	
	Ground	Grade			North West	South East	North West	South East	North West	South East	North West	South East
0+00	145.7	136.30	9.7	0+00 Line No. 3 = 2+10.6 Line No. 2	0+32°	0+34°	C2964		5029		5-4-67	
					0+84°	0+86°		C63309	5025			10-3-77
1+00	145.8	136.50	9.3		1+19°	1+29.3	C3306		5021		5-25-67	10-3-77
					1+45°	1+47°	C2963				5-4-67	
2+00	146.7	136.70	10.0		2+05°	2+07°		C63307	5017			10-3-77
	147.4	135.78	10.6	2+39°	2+27°	2+28.8	C3305		5013		5-26-67	
					2+63°	2+65°	C2962	C63306			5-4-67	10-3-77
3+00	148.2	135.90	11.3		3+26°	3+28°			5005		5-4-67	
					3+86°	3+88°	C2961	C61414				6-6-77
4+00	149.0	137.10	11.9		4+45°	4+47°		C61439				6-6-77
	146.4	137.28 out	9.1	4+90°	4+59°	4+59.7			3034		12-5-73	
	146.8	137.38 in	9.0		5+03°	5+05°	C42592					
5+00	146.8	137.40	9.4		5+37°	5+39°	C4245		3042		8-4-67	
					5+90°	5+92°	C2960		3056		9-15-67	
6+00	145.6	137.60	8.0		6+51°	6+53°						
7+00	148.5	137.80	10.7		7+19°	4" stub W	C1708		3121		1-30-67	
	148.7	137.84	10.9									
7+24 ⁶				End 8" PVC								

C 3304 - 5009 New Jersey - Gerald Thompson - 5-26-67 - top (3+47)