


SERVICE RECORD CONSTRUCTION RECORD

CAUTION
UNDERGROUND
UTILITIES
 Please check with K G & E or
 So. Western Bell
 Telephone Co. for Location

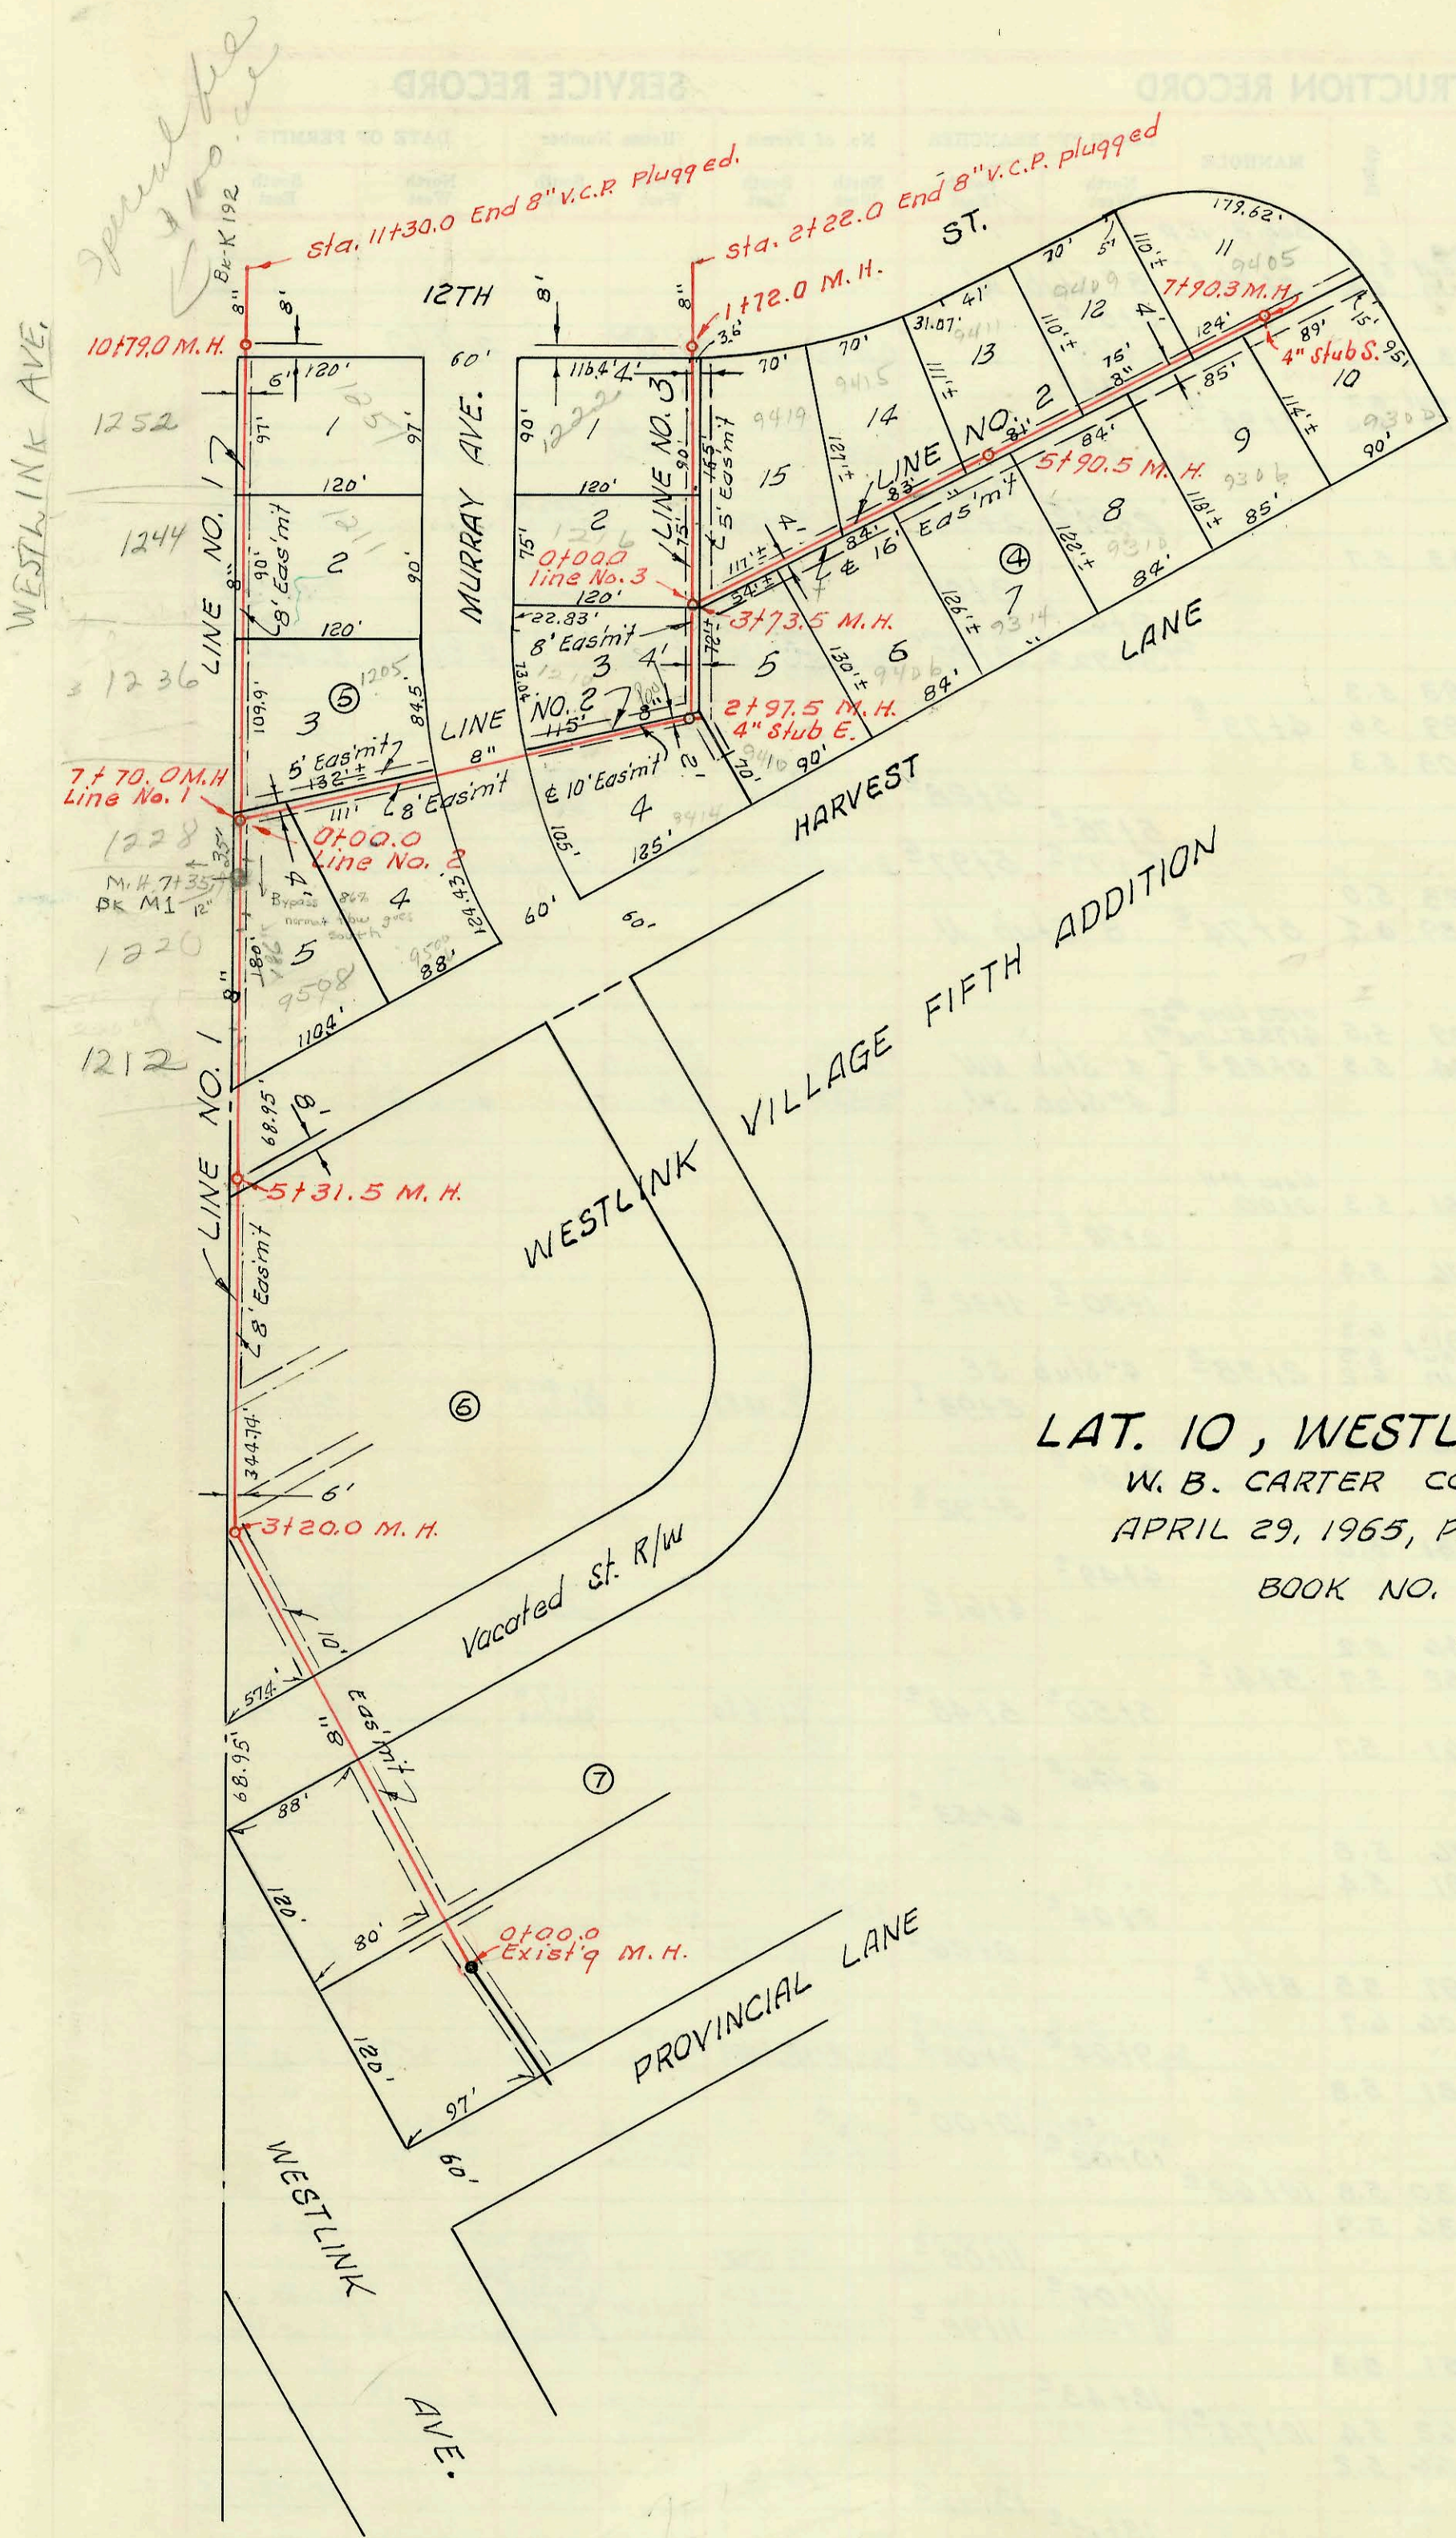

CONSTRUCTION RECORD

SERVICE RECORD

STATION	ELEVATION		Depth	MANHOLE	4-INCH "Y" BRANCHES		No. of Permit		House Number		DATE OF PERMITS	
	Ground	Grade			North West	South East	North West	South East	North West	South East	North West	South East
LINE NO. 1	0+00	149.8	139.14	10.7	0+00 ^o Existg M.H.							
	1+00	149.2	139.43	9.8								
	2+00	148.1	139.73	8.4								
	3+00	147.1	140.03	7.1								
		146.4	140.09 out 140.19 in	6.3 6.2	3+20 ^o							
	4+00	145.7	140.43	5.3								
	5+00	145.8	140.73	5.1								
		146.0	140.82	5.2	5+31 ^o							
	6+00	148.3	141.03	7.3		6+16.5 ^o	7+09 ^o	8804	1212 Westlink		7-26-83	
						6+29 ^o				9508 Harvest		
	7+00	150.5	141.33	9.2	7+35 ^o	7+09.0 ^o		C43024		9508 Harvest		1-16-74
		151.4	141.54	9.9	7+70 ^o	7+44.0 ^o		C24769				6-7-71
	8+00	151.4	141.63	9.8		8+01 ^o		B4150		1205 Murray		9-22-65
	9+00	151.3	141.93	9.4		9+04 ^o		B3902		1251 Murray		8-3-65
						9+98 ^o		3599				6-16-65
	10+00	150.2	142.23	8.0								
		149.7	142.47	7.2	10+79 ^o							
	11+00											
	11+30.0		142.62		End 8" V.C.P. plugged							
LINE NO. 2	0+00	151.0	141.70	9.3	0+00 Line No. 2= 7+70.0 Line No. 1	0+42 ^o	0+40 ^o	B3352		9500 Harvest		5-7-65
	1+00	151.7	141.90	9.8								
	2+00	152.1	142.10	10.0		2+43 ^o	2+45 ^o	B4692		9412 Harvest		12-1-65
		154.0	142.30 out 142.40 in	11.7 11.6	2+97 ^o	4" stub E.				9410 Harvest		4-18-66
	3+00	154.2	142.45	11.7		3+27 ^o		B5459				
		154.4	142.55 out 143.70 in	11.8 11.7	3+73 ^o							
	4+00	154.7	143.80	10.9		4+17 ^o						
						4+55 ^o		B4493		9406 Harvest		11-5-65
	5+00	156.0	144.20	11.8		5+16 ^o	5+38 ^o	C2586 B4876	9415 1212	9314 Harvest	4-6-67	1-4-66
		155.5	144.56	10.9	5+90 ^o							
	6+00	155.5	144.60	10.9		6+01 ^o	6+23 ^o	B3117 B4691	9411 1212	9310 Harvest	5-17-67	12-1-65
						6+80 ^o		4492	9409 1212		11-5-65	
	7+00	154.8	145.00	9.8		7+40 ^o	7+07 ^o	B4410 B5458	9405 1212	9306 Harvest	10-25-65	4-18-66
		154.7	145.36	9.3	7+90 ^o	4" stub S.		B4840		9300 Harvest		12-28-65
LINE NO. 3	0+00	154.4	142.65	11.7	0+00 Line No. 3= 3+73.5 Line No. 2	0+21 ^o	0+50 ^o	C2104 B3408	1216 Murray	9419 1212	3-2-67	10-18-65
						0+82 ^o			1222 R Murray		8-16-66 5-13-65	see below
	1+00	153.4	142.85	10.5		1+72 ^o						
	2+00	153.0	143.05	10.0								
	2+22.0	153.0	143.09	9.9	End 8" V.C.P. plugged							

R-0000-01844 - Turbo-Wichita Exc - 4" 50440 1 twin CO installed
 B5124 - 1210 Murray - 2-23-66 - Moon & Son Bly - top (2+77.1)
 C-28622 1252 Westlink (Jay Souter) 10-19-71 special assessment #100.00 Rec # 106393 (10+06.6)
 C 28720 1244 Westlink (Dorrell Thompson) 10-26-71 " " 100.00 Rec # 106406 (9+60.0)
 C 32147 1222 Westlink (Jay Souter) 5-11-72 " " 100.00 Rec # 117812 (7+94.0)
 C 32148 1236 Westlink (Jay Souter) 5-11-72 " " 100.00 Rec # 117813 (8+35.0)
 C 32230 1212^{1/2} Westlink (Dunnie Moon) 5-15-72 " " 100.00 Rec # 117832 (6+34.0)
 C 35439 1220 Westlink (Dunnie Moon) 10-17-72 " " 100.00 Rec # 114145 (9+10.5)