


MOVING AND ADJUSTING PIPE LINES
IN CONNECTION WITH IMPROVEMENT OF
HIGHWAY K-15
HYDRAULIC AVE. TO GILBERT ST.
MID-STATES CONST. CO. INC.
MAY 14, 1965 PROJECT NO. C6-5

Note bk. No. K-76

NOTE: This project booked
on pages 201 thru 203 incl.

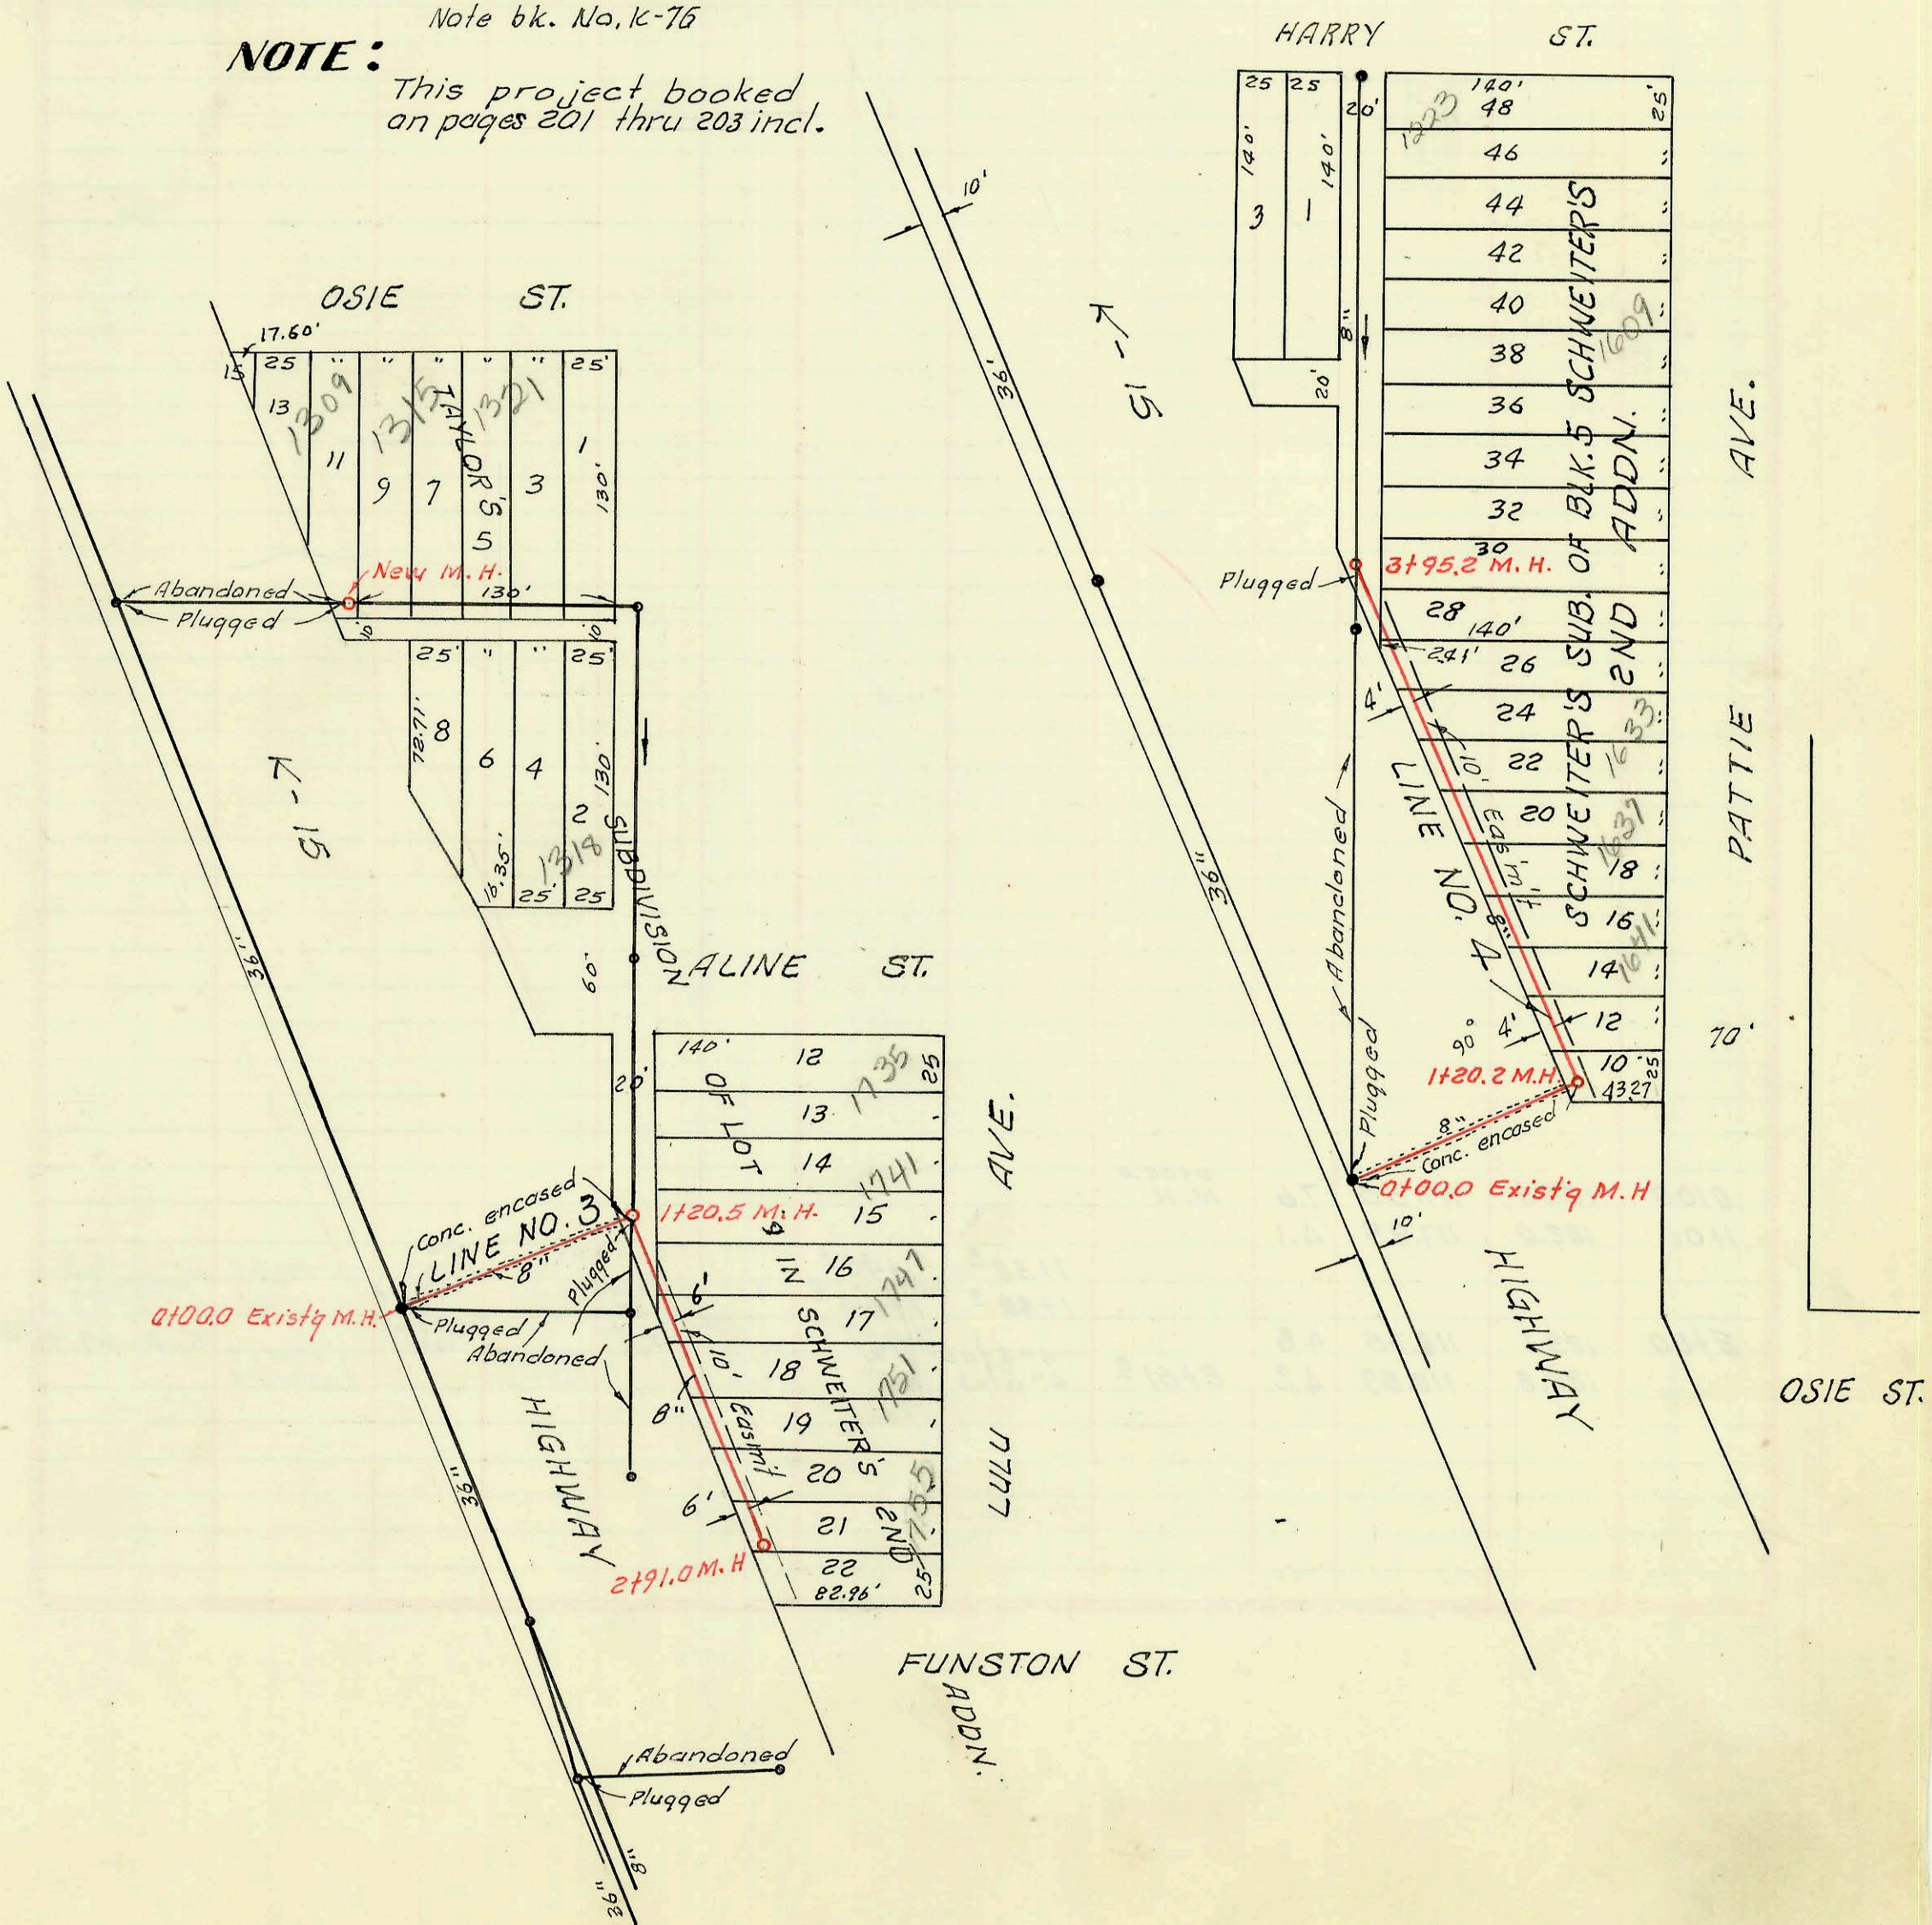

9-M.H.
20-p

K

CONSTRUCTION RECORD							SERVICE RECORD					
STATION	ELEVATION		Depth	MANHOLE	4-INCH "Y" BRANCHES		No. of Permit		House Number		DATE OF PERMITS	
	Ground	Grade			North West	South East	North West	South East	North West	South East	North West	South East
LINE NO. 1	0+00	101.7	95.00	6.7	0+00.0 New M.H.							
						0+21 ^o		97-15136 ^o	2021 B Greenwood		9-29-64	10-2-64
						0+77 ^o			2027 "		10-2-64	
	1+00	101.1	95.40	5.7		1+35 ^o			2031		10-2-64	
						1+88 ^o			2037		10-2-64	
	2+00		95.80			4" stub			2041		10-2-64	
		101.1	95.85	5.2	2+12 ^o	2+12 ^o & 4" stub		94-1184-7	" (B)		11-8-94	
LINE NO. 2	0+00	101.2	90.90	10.3	0+00.0 Exist'g M.H.							
	1+00	100.8	91.30	9.5					1915 Ellis		10-13-64	
		101.0	91.48 out 91.58 in	9.4	1+44 ^o	1+44 ^o						
	2+00	100.8	91.80	9.0		2+41 ^o		22247	19078 R Ellis		12-19-88	10-13-64
						2+73 ^o		# 4026	19018 "		10-13-64	8-27-81
	3+00	100.7	92.20	8.5								
		100.7	92.39	8.3	3+41 ^o							
LINE NO. 3	0+00	98.4	90.00	8.4	0+00.0 Exist'g M.H.							
	1+00	98.1	90.40	7.7								
		98.1	90.48 out 90.72 in	7.3	1+20 ^o	1+55 ^o				1745 Lulu		
	2+00	98.1	93.00	5.1		2+00 ^o			1751 Lulu			
						2+60 ^o			1755 Lulu			
		98.1	93.56	4.5	2+91 ^o							
					New MH	S. of Osie & E of K-15			1309 E. Osie		10-20-64	
LINE NO. 4	0+00	98.2	91.20	7.0	0+00.0 Exist'g M.H.							
	1+00	100.2	91.60	8.6								
		100.2	91.68 out 93.55 in	6.6	1+20 ^o	1+92 ^o				1641 Fattie		10-23-64
	2+00	99.4	93.90	5.5		2+45 ^o			1637		"	
						2+93 ^o			1633		"	
	3+00	98.8	94.30	4.5		3+72 ^o			1627		"	
		98.9	94.70	4.2	3+95 ^o							

K

9