


CAUTION
UNDERGROUND
UTILITIES
 Please check with K G & E or
 Southwestern Bell
 Telephone Co. for Location

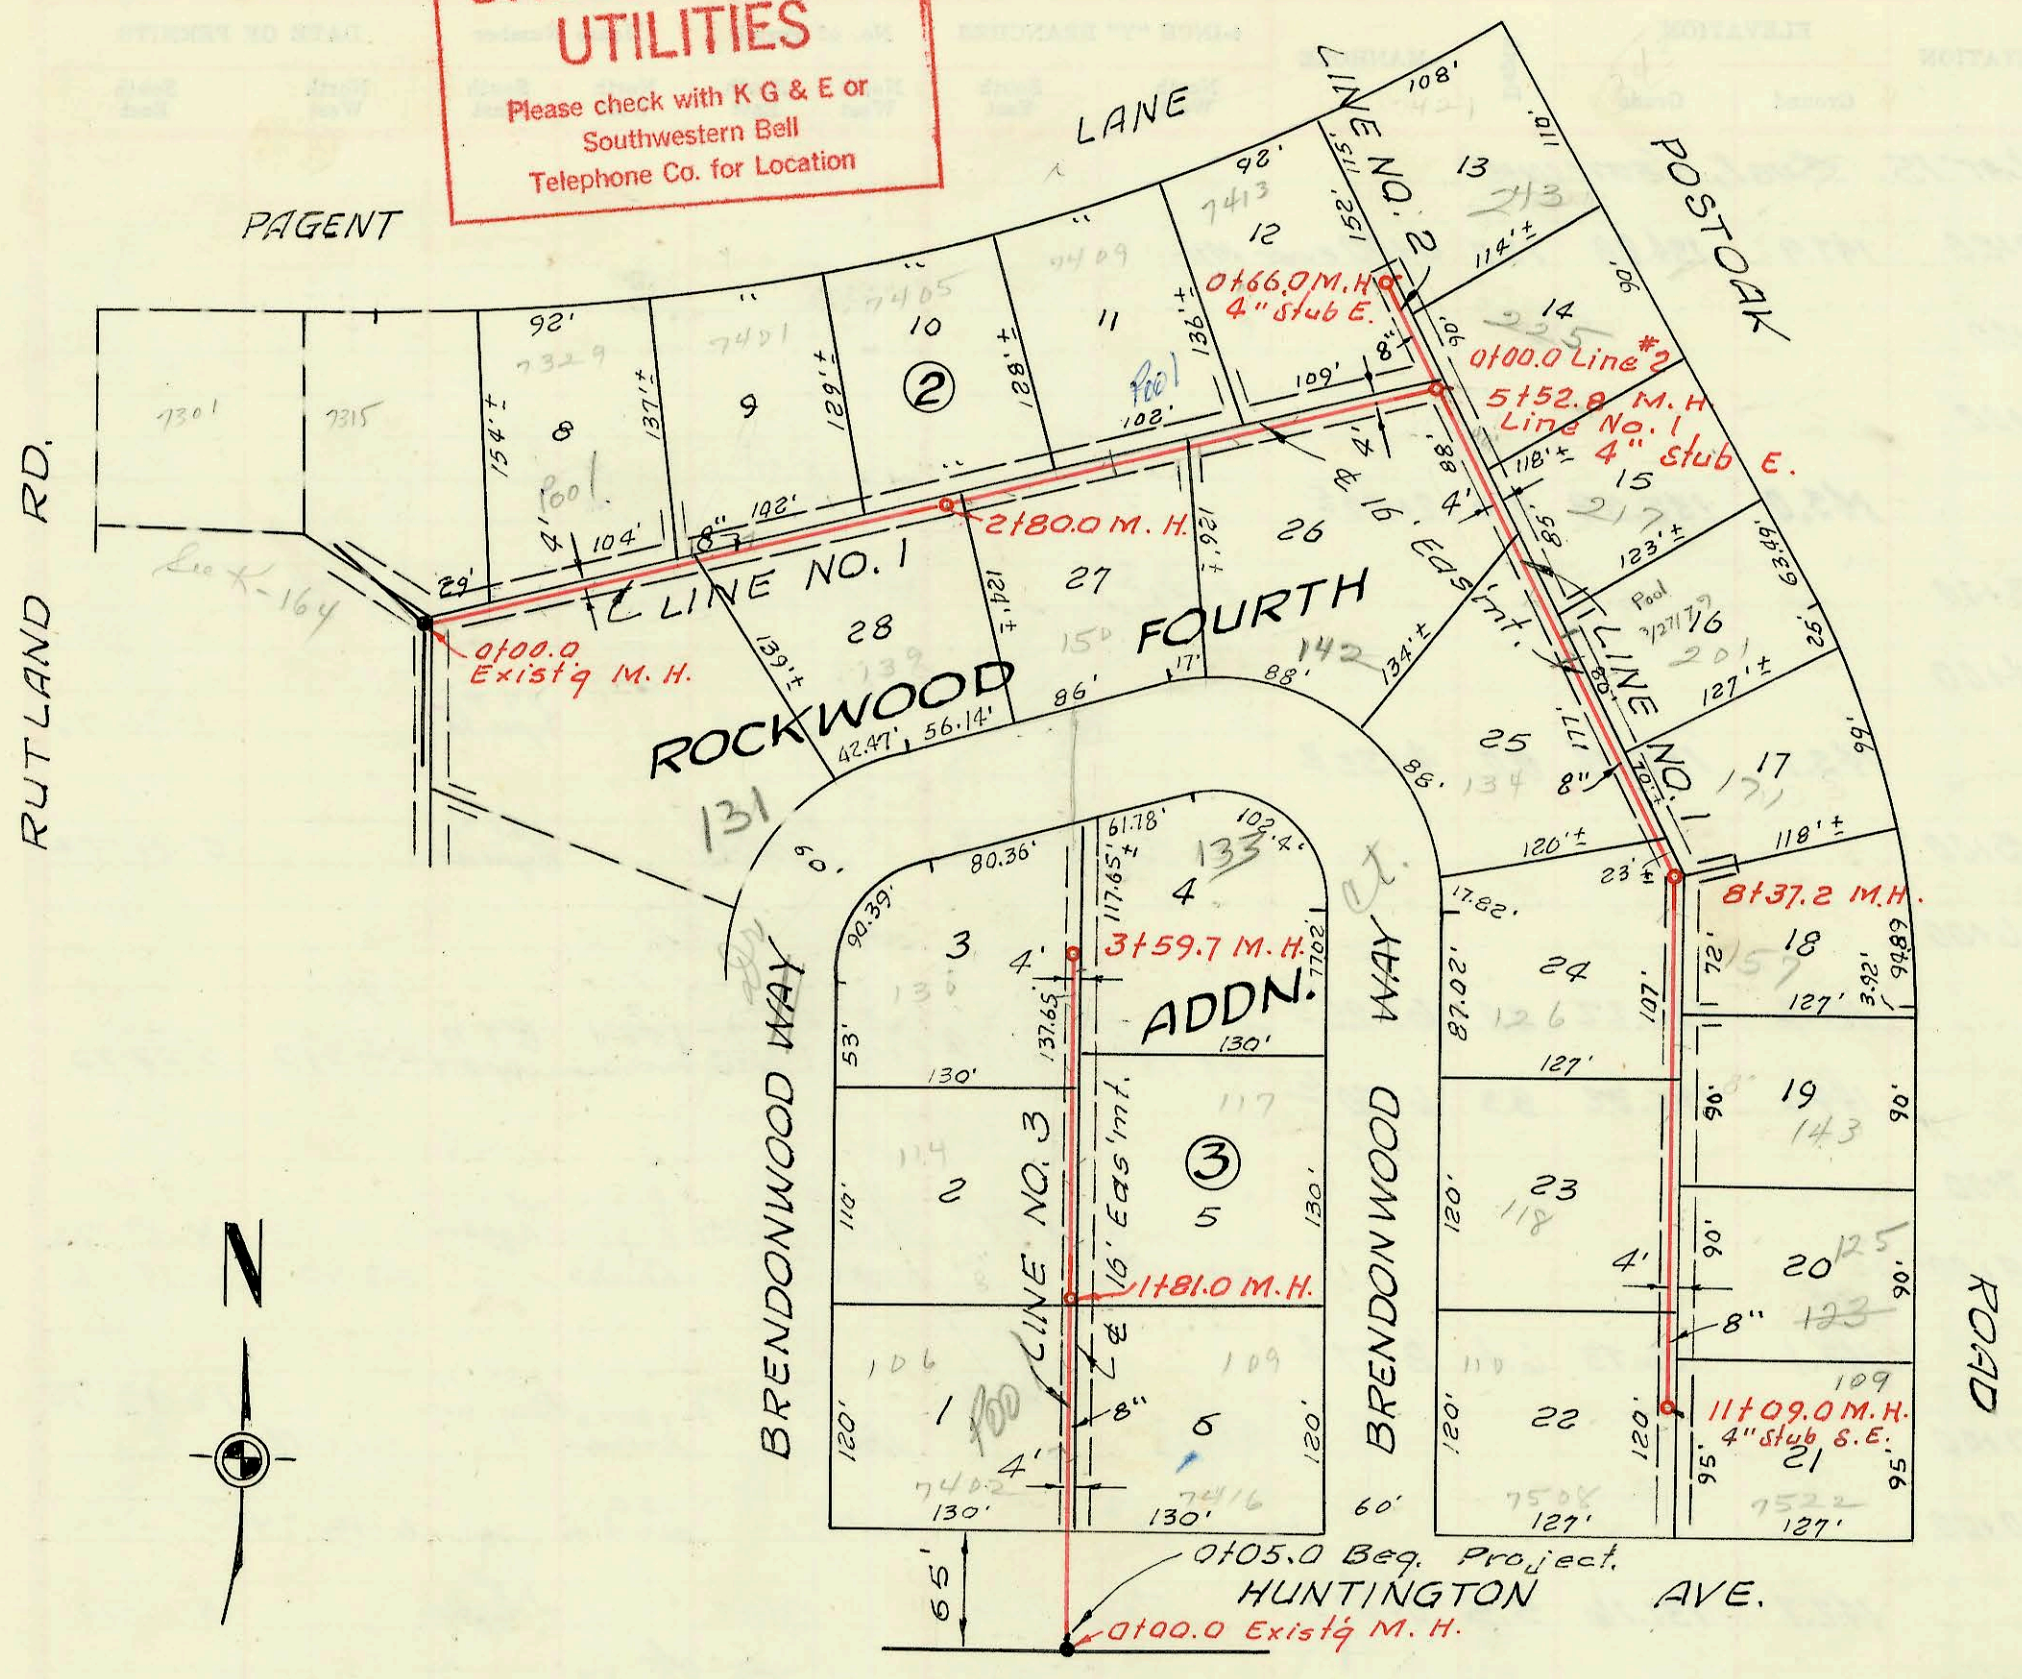

1" = 100'

LAT. 27, SUB. 5-A, W. 1. S.
 MID - STATES CONST. CO. INC.
 MAY 1965, PROJ. NO. C25-3
 BK. NO. K-71

CONSTRUCTION RECORD

SERVICE RECORD

STATION	ELEVATION		Depth	MANHOLE	4-INCH "Y" BRANCHES		No. of Permit		House Number		DATE OF PERMITS	
	Ground	Grade			North West	South East	North West	South East	North West	South East	North West	South East
0+00	173.3	158.45	14.8	0+00.0 Exist'g M.H.		0+23°						
1+00	173.3	158.75	14.5		0+45° 0+90° 1+47°							
2+00	173.0	159.05	14.0			1+54°						
	172.8	159.29	13.5	2+80°	2+46°	2+57	C5223	B4614	7405 139	139	10-11-67	11-23-65
3+00	173.0	159.35	13.6		3+51°	3+49.5						
4+00	172.0	159.65	12.3		3+74.5	4+22°	C4247		7409 150	150	8-4-67	
5+00	173.1	159.95	13.1		4+50°	4+95.6						
6+00	173.2	160.10 out 160.20 in	13.1	5+52°	4+95.6	4" stub East	B3866		7413 225	225	7-27-65	3-18-66
7+00	172.3	160.65	11.6		6+06° 6+68° 7+11.6	6+11° 6+58° 7+00° 7+77°	C5054		142 217	217	9-29-67	
8+00	171.6	160.95 out 161.06 in	10.6				21443 C735	B5211 C6128	134 B 121	121	9-8-68	3-8-66
9+00	171.6	161.35	10.2	8+37°	8+51°	8+53°	B4597	B5405	126 157	157	11-19-65	4-7-66
10+00	171.2	161.65	9.5		9+61° 9+86°	9+23°		B4733	143	143	12-9-65	
11+00	170.5	161.95	8.5		10+79°	10+17°	2066-04958 B4078		118 R 5094	125	4-12-66	9-7-65
	170.4	161.98	8.4	11+09°		4" stub S. E.	B6236		110	110	3-14-66	
0+00	173.3	162.50	10.8	0+00 = 5+528 Line No. 1		4" stub east						
0+00	173.2	163.80	9.4	0+66°								
0+00	170.2	159.61	10.6	0+00° Exist'g M.H.								
0+03.0		Req. 8" PVC										
1+00	170.7	160.41	10.3		0+82°	0+80°						
2+00	171.1	161.05	10.0	1+81°	1+11°	1+09°	B4445	B5093	106 109	109	10-29-65	2-15-66
3+00	171.7	162.01	9.7		2+05° 2+21°	2+03° 2+34°	C1639		117	117	1-23-67	
	172.2	162.49	9.7	3+59°	3+10° 3+35° 3+51°	3+33° 3+51°	B4800		130 133	133	12-21-65	11-23-65

LINE NO. 1

LINE NO. 2

LINE NO. 3