
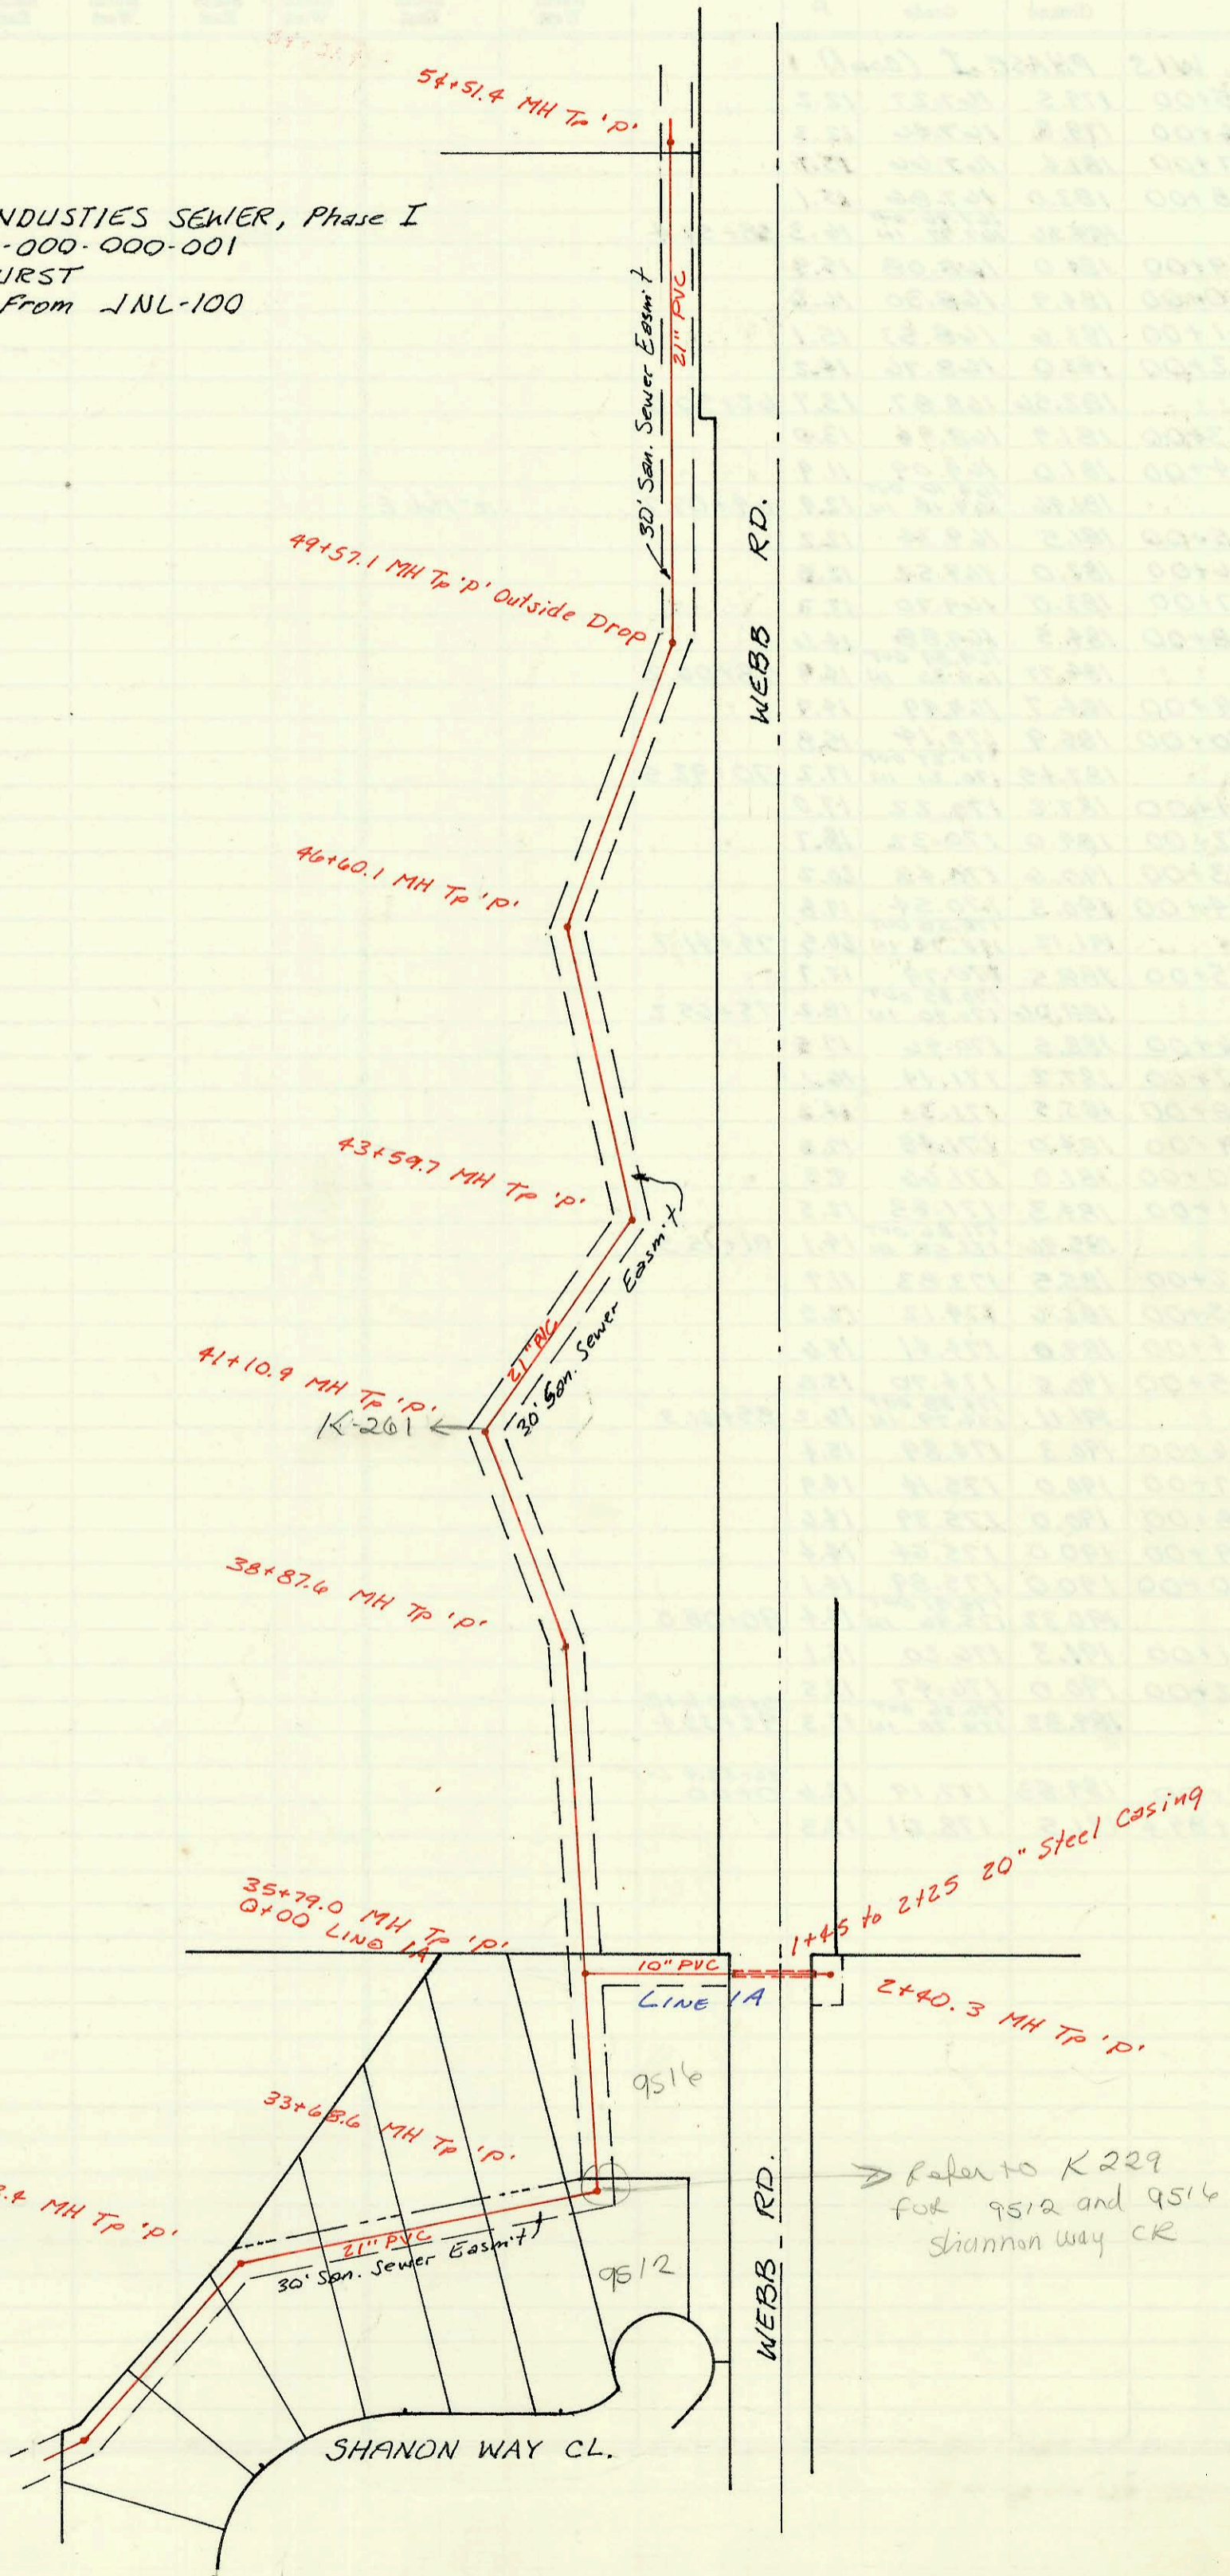


MAIN 24, WAR INDUSTRIES SEWER, Phase I
468-76-245-81477-000-000-001
Built By B.A. DURST
Booked 10-87 From JNL-100

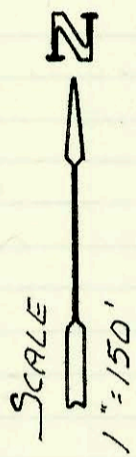

WEBB RD.

WEBB RD.

SHANON WAY CL.

LINE 1A

Refer to K 229
for 9512 and 9516
Shannon way CR

10" PVC

9516

9512

K-261

30' San. Sewer Easmt.
21" PVC

30' San. Sewer Easmt.
21" PVC

30' San. Sewer Easmt.
21" PVC

30' San. Sewer Easmt.

10" PVC

LINE 1A

9516

9512

41+10.9 MH TP 'P'

43+59.7 MH TP 'P'

46+60.1 MH TP 'P'

49+57.1 MH TP 'P' Outside Drop

54+51.4 MH TP 'P'

38+87.6 MH TP 'P'

35+79.0 MH TP 'P'

33+48.6 MH TP 'P'

30+12.4 MH TP 'P'

27+86.7 MH TP 'P'

Faint grid lines and text from the reverse side of the paper are visible through the page.

CONSTRUCTION RECORD

SERVICE RECORD

MAIN 24, W15
LINE 1 (CONT)

STATION	ELEVATION		Depth	MANHOLE	4-INCH "Y" BRANCHES		No. of Permit		House Number		DATE OF PERMITS	
	Ground	Grade			North West	South East	North West	South East	North West	South East	North West	South East
31+00	166.5	153.12	13.4									
32+00	165.9	153.39	12.5									
33+00	166.0	153.66	12.3									
	172.10	153.85 OUT 153.95 IN	18.3	33+68.6	4" stub		91-21469-7		9612-401 SHAWMUT CR		8-29-91	
34+00	165.0	154.02	11.0									
35+00	170.6	154.25 154.43 OUT	16.4	0+00 L-1A 35+79.0								
	170.38	154.53 IN	16.0									
36+00	165.0	154.58	10.4									
37+00	164.5	154.84	9.7									
38+00	166.5	155.09	11.4									
	168.06	155.31 OUT 155.47 IN	12.8	38+87.6								
39+00	167.5	155.50	12.0									
40+00	165.4	155.73	9.7									
41+00	165.5	155.96	9.5									
	167.67	155.99 OUT 156.15 IN	11.7	41+10.9								
42+00	166.6	156.40	10.2									
43+00	167.5	156.68	10.8									
	169.15	156.85 OUT 156.92 IN	12.3	43+59.7								
44+00	168.9	157.03	11.9									
45+00	166.5	157.32	9.2									
46+00	168.4	157.60	10.8									
	170.93	157.77 OUT 157.78 IN	13.2	46+60.1								
47+00	173.5	157.91	15.6									
48+00	175.2	158.24	17.0									
49+00	170.0	158.56	11.4									
	175.05	158.75 OUT 160.00 IN	16.3	49+57.1								
50+00	177.0	166.09	10.9									
51+00	179.9	166.31	13.6									
52+00	180.0	166.53	13.5									
53+00	181.7	166.75	15.0									
54+00	181.1	166.97	14.1									
	180.72	167.08 OUT 167.17 IN	13.6	54+51.4								
LINE 1A 0+00	170.38	158.42	12.0	35+79.0 L-1 0+00								
1+00	175.0	158.80	16.2									
2+00	171.5	159.30	12.2									
	172.32	159.43	12.9	2+40.3								

CENTRAL
JULY 1981