

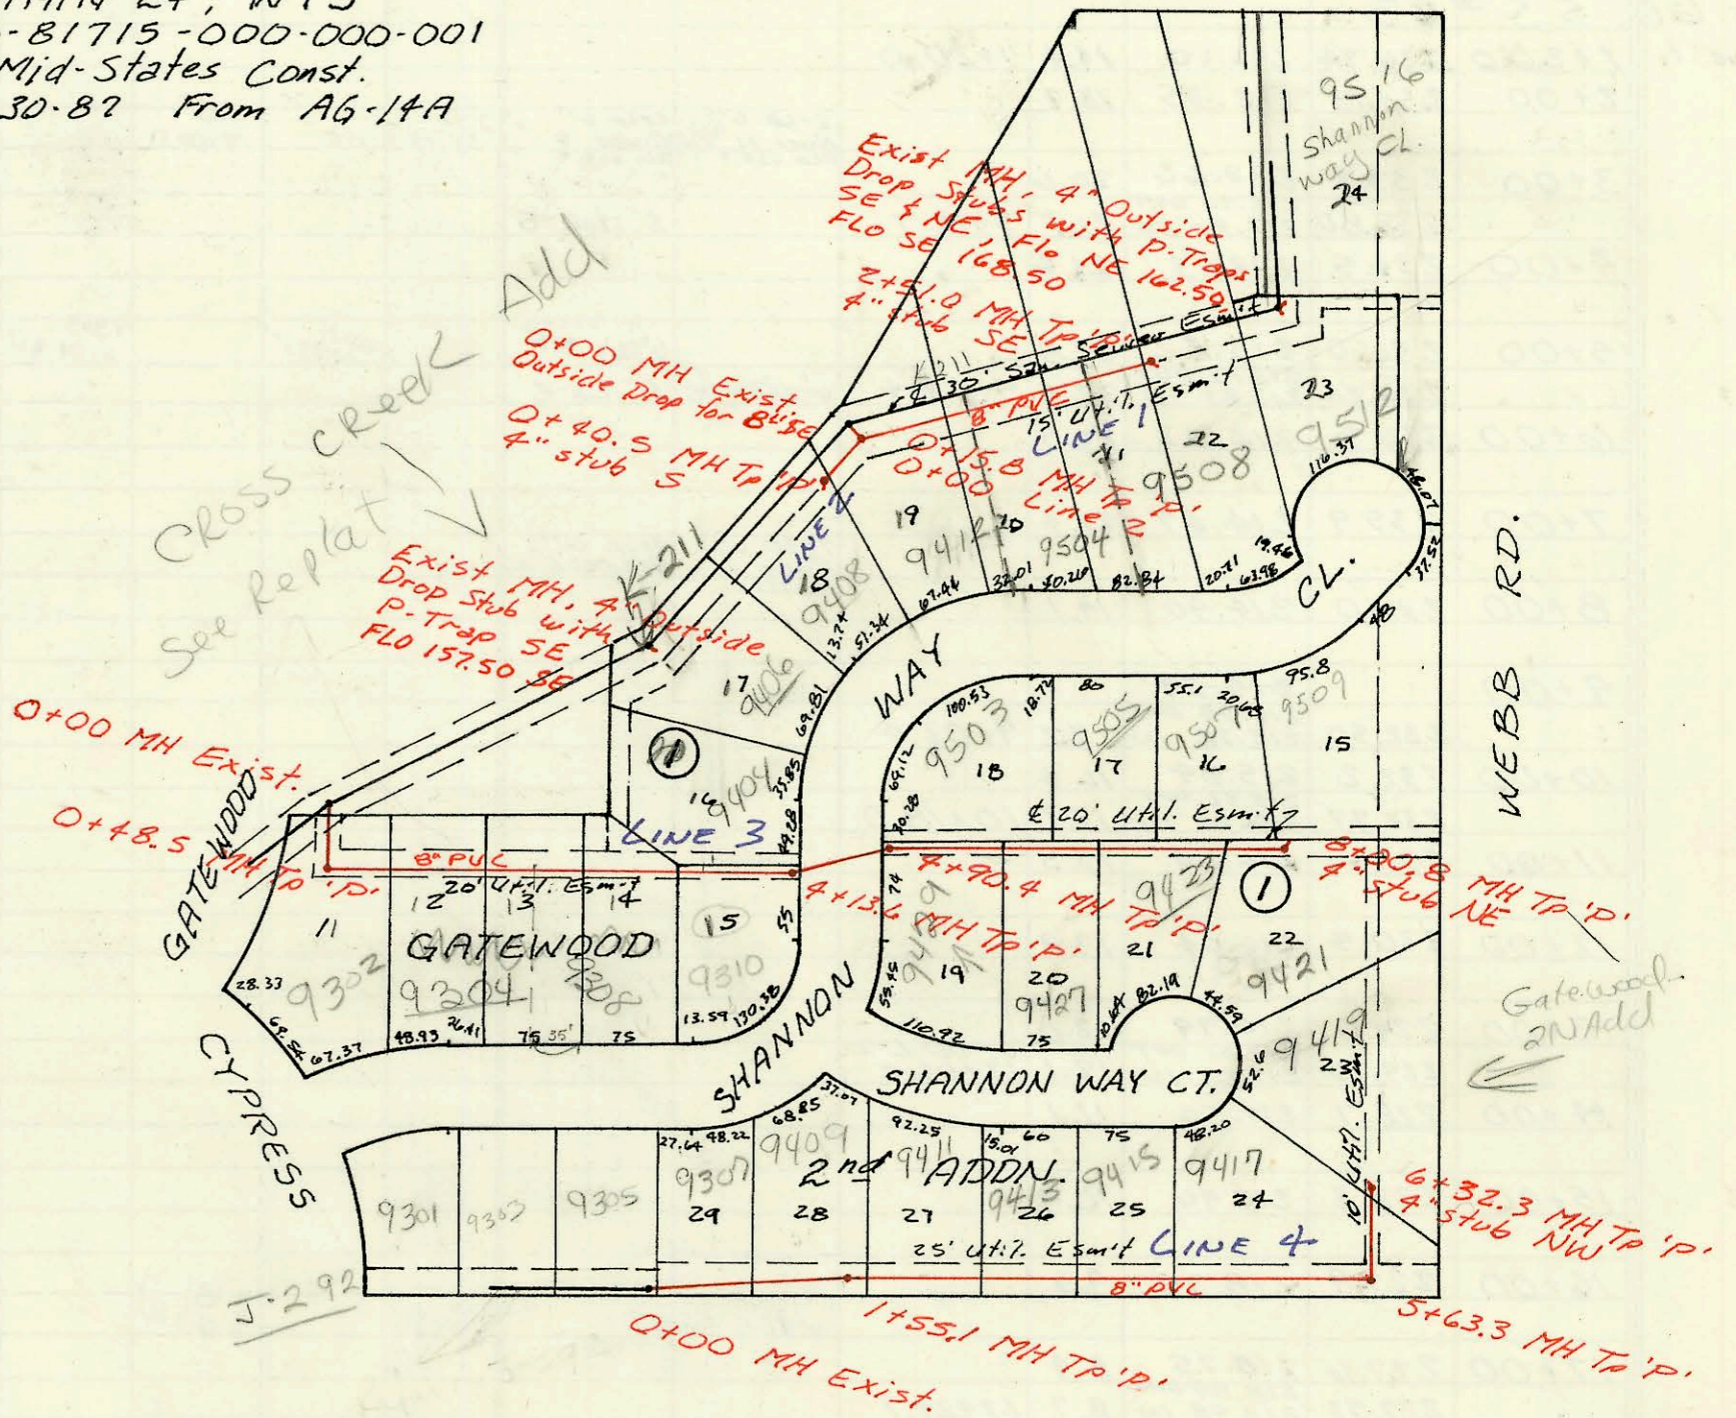
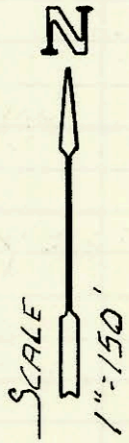


LAT 10, MAIN 24, W15  
468-76-245-81715-000-000-001  
Built By Mid-States Const.  
Booked 12-30-87 From AG-14A

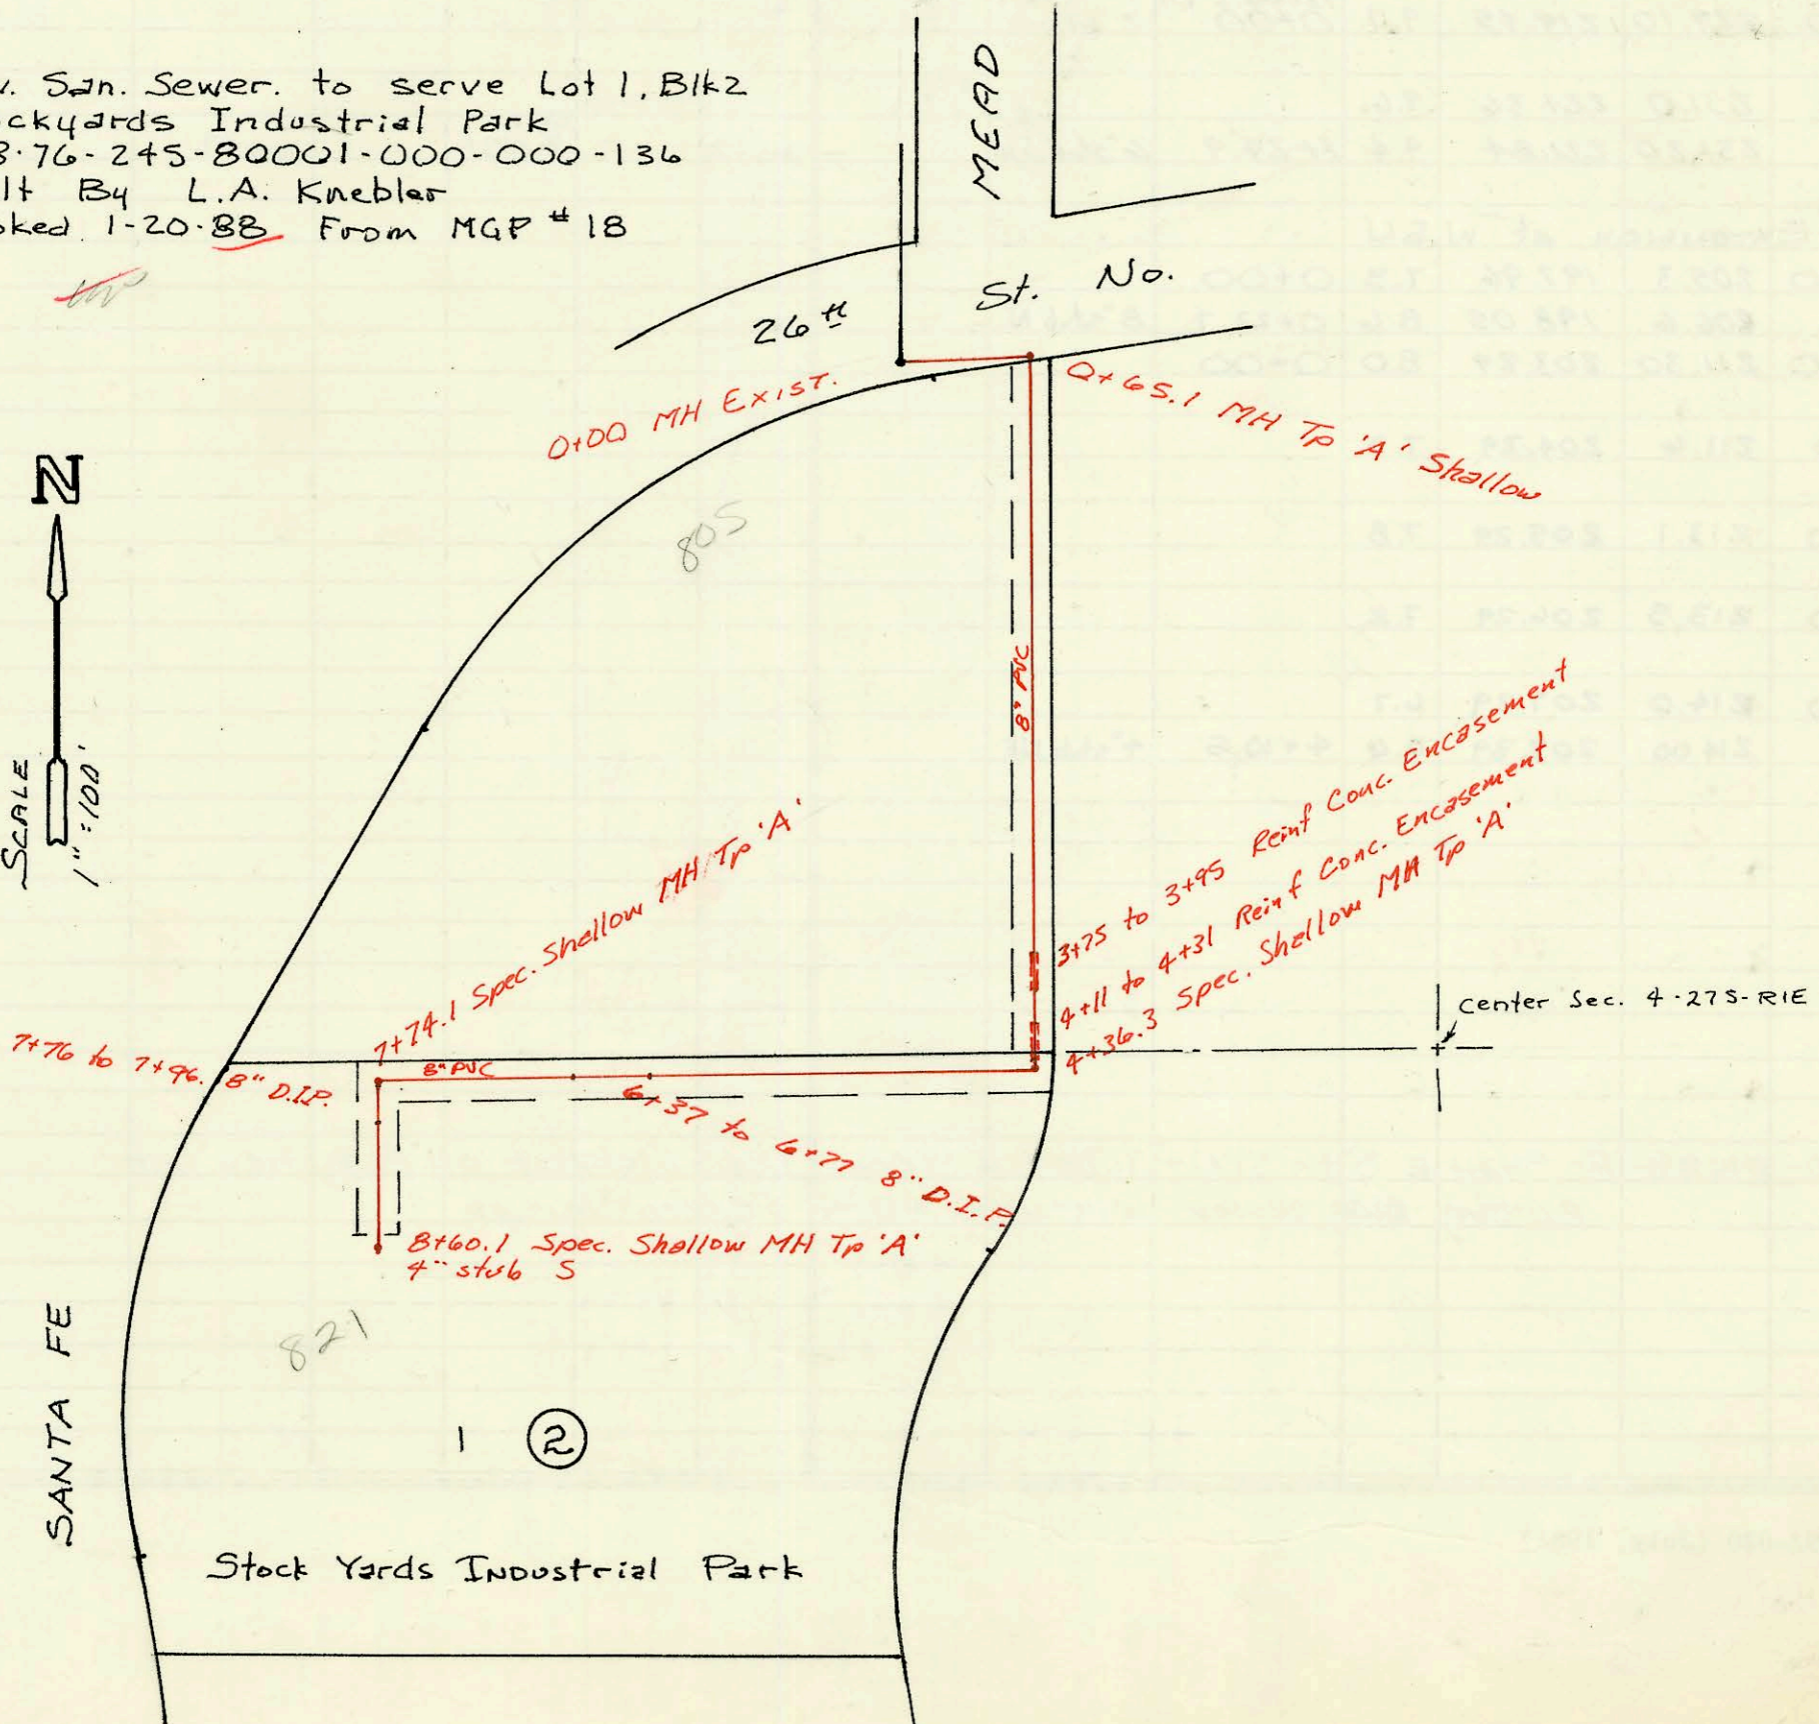

Priv. San. Sewer. to serve Lot 1, Blk 2  
Stockyards Industrial Park  
468-76-245-80001-000-000-136  
Built By L.A. Knebler  
Booked 1-20-88 From MGP # 18

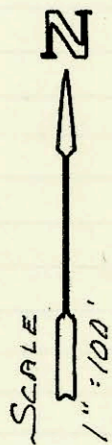

CONSTRUCTION RECORD							SERVICE RECORD					
STATION	ELEVATION		Depth	MANHOLE	4-INCH "Y" BRANCHES		No. of Permit		House Number		DATE OF PERMITS	
	Ground	Grade			North West	South East	North West	South East	North West	South East	North West	South East
LAT 10	MAIN 24, WIS											
LIN 1	0+00	169.19	158.84	10.4	EXIST							
		169.79	159.09	10.7	0+00 L-2							
	1+00	168.9	160.10	8.8	0+15.8							
	2+00	169.0	161.30	7.7		0+25.8 TAP	23567		9472			7-20-89
		170.33	161.91	8.4	2+51.0	1+82.8 TAP	24428		9504			12-5-89
LIN 2	0+00	169.79	159.09	10.7	0+00 L-1	2+36.0 TAP	24475		9508			12-19-89
		170.07	159.56	10.5	0+40.5	4" stub SE						
LIN 3	0+00	165.87	154.77	11.1	EXIST	4" stub S	21358		9408			8-24-88
		167.94	157.23	12.7	0+48.5	0+72.5 TAP	22521		9262			2-1-89
	1+00	166.3	157.75	8.6		1+22.5 TAP	22500		9301			1-25-89
	2+00	168.3	158.77	9.5		2+29.5 TAP	22456		9303			1-23-89
	3+00	169.0	159.78	9.2		3+37.6 TAP	24191		9404			10-27-89
		170.64	160.93	9.7	4+13.6	(3+43.1 TAP)	26323		9370			3-22-88
	4+00	169.0	160.79	8.2								
		170.51	161.80	8.7	4+90.4							
	5+00	168.5	161.89	6.6								
	6+00	170.0	162.84	7.2		5+56.4 TAP	20264	21072	9503	9469		7-14-88
						6+46.8 TAP	20690	25048	9505	9421		4-3-90
						6+73.8 TAP	20437		9423			5-17-88
	7+00	173.0	163.79	9.2		7+85.8 TAP	24631		9421			4-6-90
	8+00	176.68	164.74	11.9	8+00.8	4" sch 40 pipe	26724		9507			5-26-88
LIN 4	0+00	177.23	164.15	13.1	EXIST	4" stub NE	19932		9307			1-5-88
					0+66.0							
	1+00	176.6	164.81	11.8								
		176.90	165.17	11.7	1+55.1	1+49.1 TAP	19951		9409			1-14-88
	2+00	176.0	165.53	10.5		2+40.0 TAP	23968		9411			8-17-89
	3+00	176.5	166.34	10.2		3+03.1 TAP	20059		9436			2-3-88
	4+00	178.2	167.16	11.0		4" PVC HO	91-3885-7		9445			11-26-91
						3+89.3 top	25134		9477			4-13-90
	5+00	179.4	167.97	11.4		4+73.3 TAP						
		180.45	168.48	12.0	5+63.3							
	6+00	179.7	168.73	11.0								
		180.27	168.95	11.3	6+32.3	4" stub NW	26791		9496			12-14-90
							22907					4-12-89
Priv. S.	S. to Serve Lot 1, Bldg 2, Stock Yards Industrial Park											
	0+00	125.22	120.00	5.2	EXIST							
		125.7	120.20	5.5	0+65.1							
	1+00	125.3	120.40	4.9								
	2+00	123.5	120.71	2.8								
	3+00	123.3	121.01	2.3								
	4+00	123.4	121.31	2.1								
		124.35	121.42	2.9	4+36.3							
	5+00	124.0	121.71	2.3								
	6+00	124.4	122.01	2.4								
	7+00	124.8	122.31	2.5								
		125.7	122.53	3.2	7+74.1							
	8+00	125.0	122.71	2.3								
		126.0	122.87	3.1	8+60.1	4" stub S						

Form #192-020 (July, 1981)

#91-31469-7 8/29/91 - 9512 E. Shannon way CR- McCallough - (MH stub 33+68.6 (K-211) 4" sch 40 pipe)

#91-32893-7 9/19/91 - 9419 E. Shannon way CR- McCallough - (tying into House to Bldg line)