



see N63

LAT 260 SW INTERCEPTOR
468-76-245-81774-000-000-001
Built By Utility CONTR.
Booked 4-14-88 from MGP-28

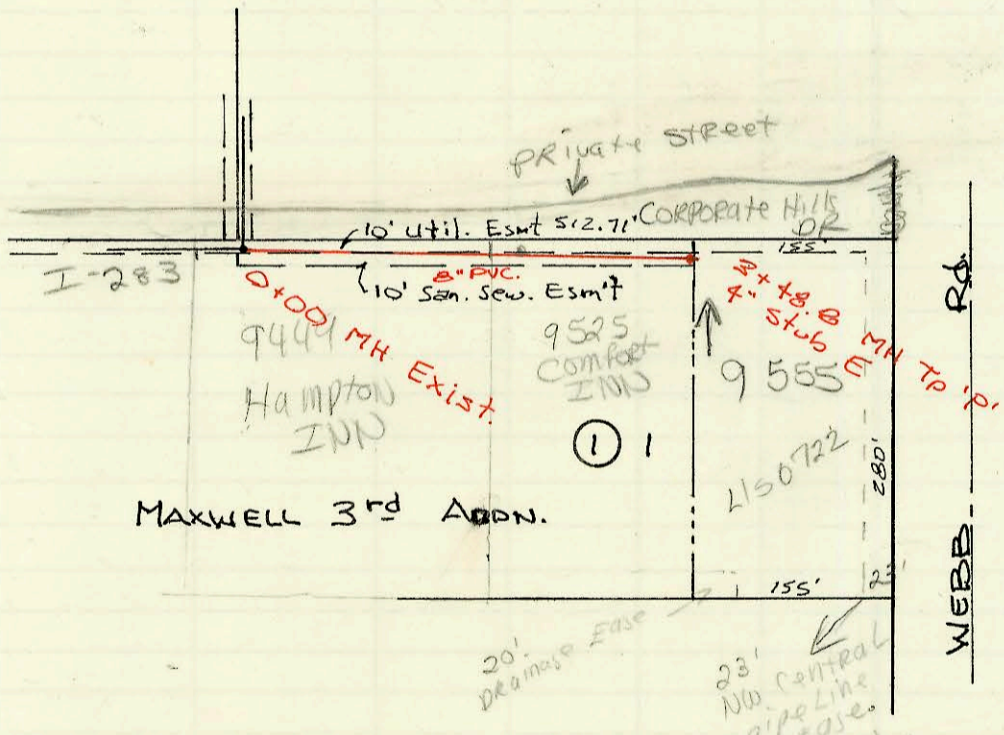


LAT 18, MAIN 13, W15
468-76-245-81764-000-000-001
Built By NOWAK CONST.
Booked 6-2-88 From AG-19

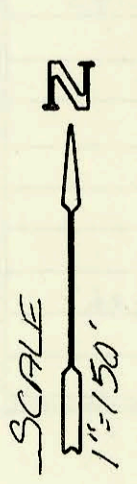

Priv. San. Sewer for Lots 5, 4, & Part of 3
Blk 1, Frank & Johnny's Addn.
468-76-245-80001-000-000-152
Built By Utility Contr.
Booked 6-2-88 from As-Built Plan.

Note: NO fee in Lieu
of Due on Tract A Bonds
as long as they can
make suitable
connection to
this sewer
who crossing off
lot outside of
utility easement
6-5-85
BK
PER G-RAH

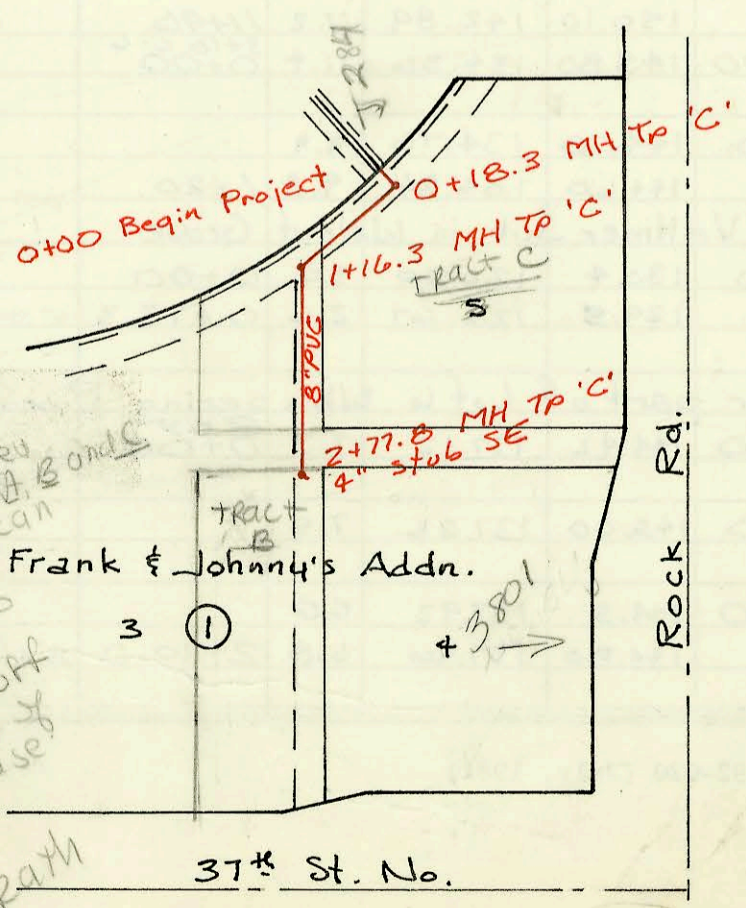

CONSTRUCTION RECORD

SERVICE RECORD

STATION	ELEVATION		Depth	MANHOLE	4-INCH "Y" BRANCHES		No. of Permit		House Number		DATE OF PERMITS	
	Ground	Grade			North West	South East	North West	South East	North West	South East	North West	South East
LAT 260, SWI												
LINE 1 0+00	147.33	136.32	11.0	0+00		4" SDR35 0+19.0		9576217		11015 W. HARVEST		5-22-95
1+00	151.4	136.90	14.5			4" PVC 40 1+09.0		95115607		11019 W. HARVEST		9-12-95
2+00	153.2	137.48	15.7									
	153.59	137.60 OUT 141.57 IN	16.0 12.0	0+00 L-4 2+21.3								
3+00	154.1	142.45	11.7									
	154.64	142.77 OUT 142.96 IN	11.9	3+28.5		3+52.5 TAP		23063		11014 W. 11th Ct		5-2-89
4+00	154.5	143.23	11.3									
						4+72.9 TAP		23720		11010 W. 11th Ct		8-7-89
5+00	154.6	143.61	11.0									
	154.76	143.76 OUT 143.81 IN	11.0	5+38.9								
6+00	154.6	144.08	10.5			4" SDR35 6+32.6 TAP		9120067		11006 W. 11th Ct		3-29-91
7+00	155.0	144.52	10.5									
	156.10	144.62 OUT 144.73 IN	11.5	0+00 L-2 1/2 7+24.6		7+99.6 TAP	7+89.6 TAP	24479 24041	1124 Manchester	10982 W. 11th	12-19-89	10-5-89
8+00	155.5	145.03	10.5									
						8+74.8 TAP	4" SDR35 8+94.6 TAP	21354 93-20877	1121 Manchester	10911 W. 11th	9-24-88	8-5-93
9+00	155.8	145.13	10.4									
						9+42.8 TAP	4" PVC 40 10+20.8 TAP	23540	1125 Manchester	10910 W. 11th	7-14-89	11-2-93
10+00	156.6	145.82	10.8			10+20.8 TAP	4" PVC 40 10+37.3	2254597 12-2672-7	1125 Manchester	10910 W. 11th	4-16-92	11-2-93
	157.04	146.07	11.0	10+61.8 7+24.6 L-1		4" stub NE	4" stub SE	91-28687 92-14472-7	1121 Manchester	10908 W. 11th	7-29-91	7-21-92
LINE 2 0+00	156.10	145.10	11.0	0+00								
	156.22	145.44	10.8	0+25.6 7+24.6 L-1			4" stub S	23744		11002 W. 11th Ct		8-11-89
LINE 3 0+00	156.10	145.04	11.1	0+00								
1+00	155.0	145.47	9.5									
	154.66	145.77 OUT 145.89 IN	8.9	1+70.6								
2+00	154.5	146.00	8.5									
	154.10	146.35	7.8	2+90.4 2+21.3 L-1								
LINE 4 0+00	153.59	137.77	15.8	0+00								
1+00	154.0	138.19	15.8									
	154.11	138.55 OUT 138.61 IN	15.6	1+85.8								
2+00	154.0	138.66	15.3									
3+00	154.3	139.04	15.3									
	155.00	139.11 OUT 142.90 IN	14.8 11.0	3+17.6		4" SDR35 3+51.2 TAP	8" stub SE	93-41207	11011 W. 11th		2-25-93	
4+00	156.0	144.21	11.8			4" SDR35 4+05.2 TAP	4" sch 40 3+96.6	92-41631-7 94-15674-7	11057 W. 11th	1104 N Manchester Ct	12-9-92	9-27-94
	158.55	145.72 OUT 145.87 IN	12.8	4+95.2		4+61.2 TAP		24142	11003 W. 11th		10-18-89	
5+00						4" SDR35 5+05.2 TAP		93-12205-7	10915 W. 11th		5-18-93	
						4" sch 40 PVC 5+71.2		92-28135-9 94-01560-7	10911 W. 11th	1111 N Cr. Manchester	9-11-92	9-26-94
6+00	158.5	146.29	12.2			6+61.0 TAP	6+21.0	23812 94-14913-7	10907 W. 11th	1113 N Manchester Ct	8-28-89	9-14-94
	157.62	146.64	11.0	6+89.0		4" stub NE	4" stub SE	24040 94-14917-7	10903 W. 11th	1115 Manchester	10/05/89	9-14-94
LAT 18, MAIN 13, WIS												
0+00	166.70	151.90	14.8	0+00								
1+00	165.2	152.32	12.9									
2+00	164.8	152.74	12.1									
3+00	166.0	153.16	12.8									
	166.25	153.36	12.9	3+48.8		4" stub E		20671		4855 CORPORATE		5-12-88
Priv. San Sew for Frank & Johnny's												
0+00	203.0											
	202.7	194.09 OUT 194.35 IN	8.6	0+18.3								
1+00	203.0	194.76	8.2									
	203.24	194.84	8.4	1+16.3								
2+00	203.8	195.20	8.6									
	204.39	195.53	8.9	2+77.8			4" stub SE	22881		3801 ROCK RD	500 Below	4-7-89

20704 (5-14-88) 3801 N. Rock Rd Temp Bank facilities (T&E, W&R) connected to MH 2+77.8 stub - sealed 2' s. of MH 2+77.8