



13th St. No.



13-43

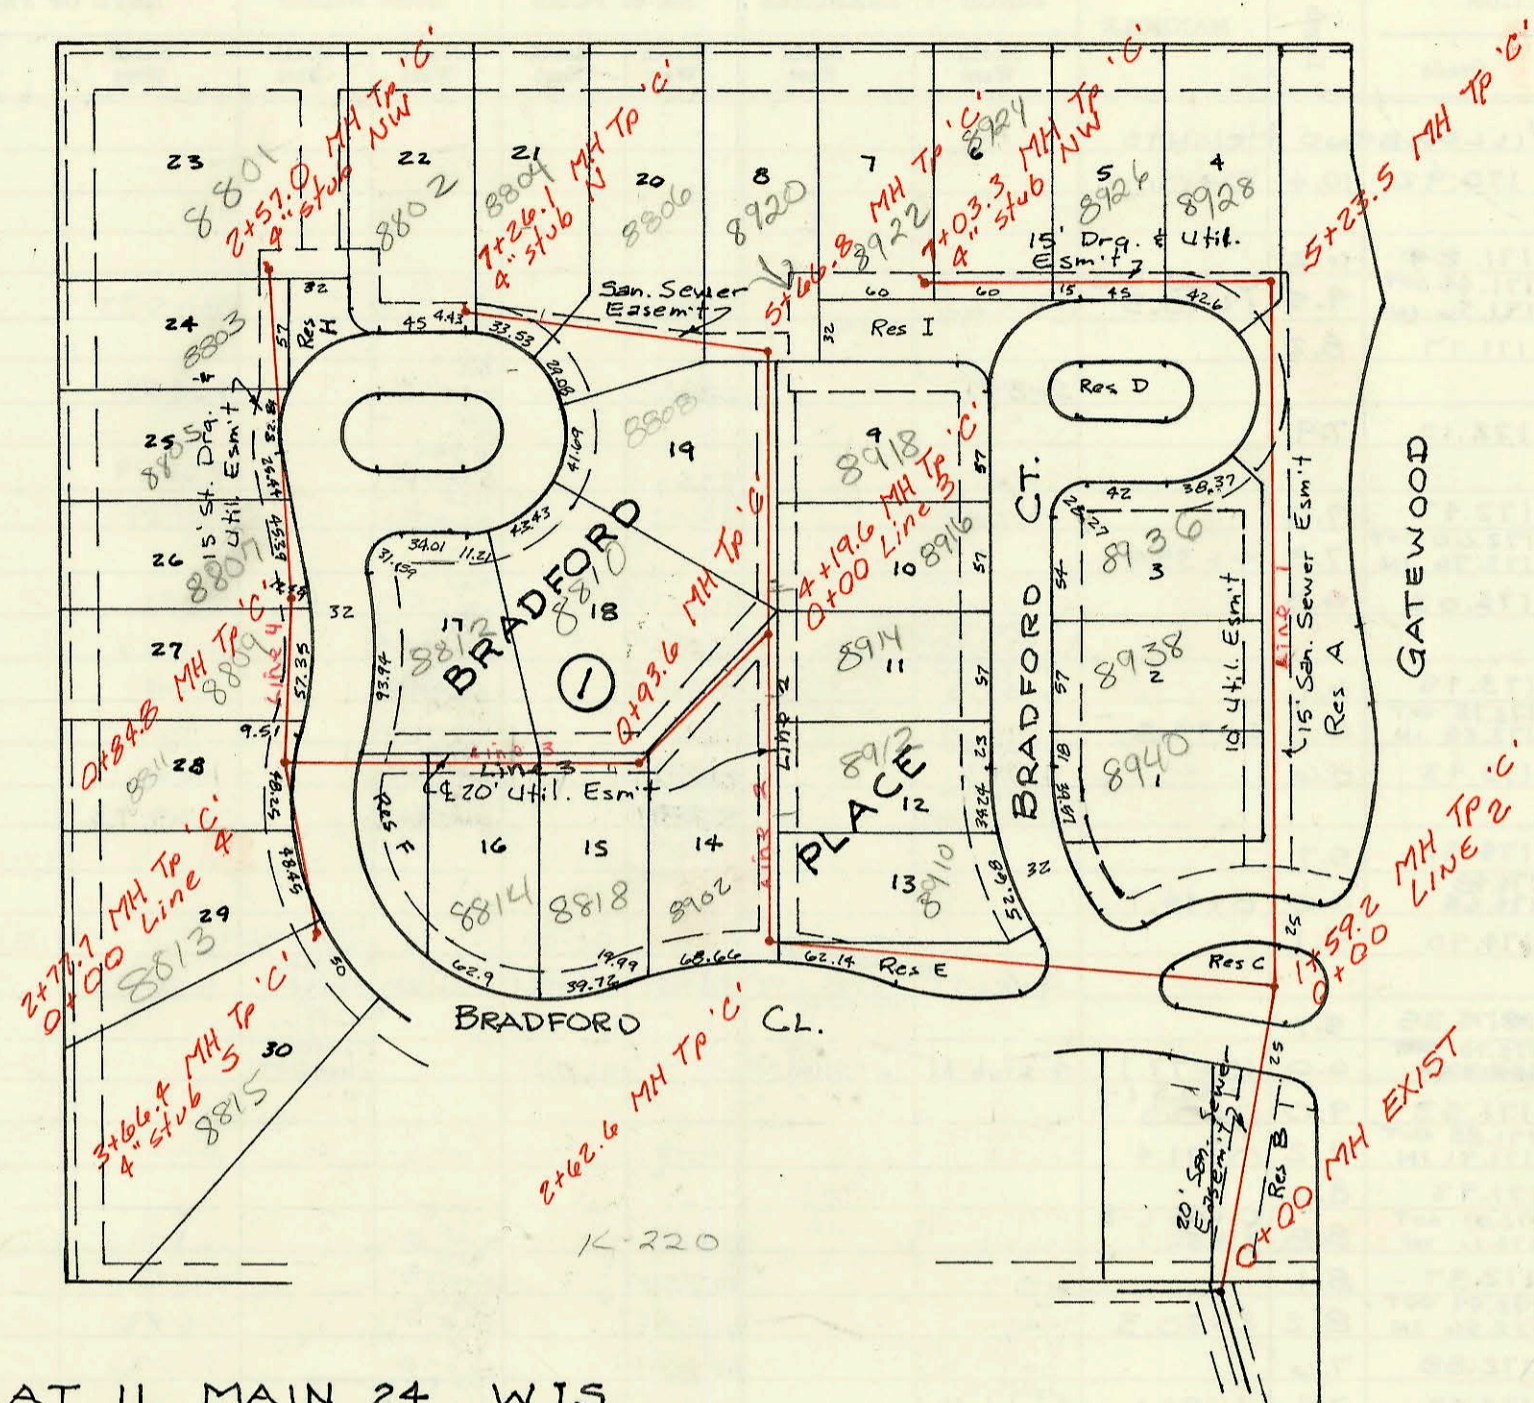

LAT 11, MAIN 24, WIS.  
 468-76-245-81781-000-000-001  
 Built By Utility CONTR.  
 Booked 4-27-88 From TCD-39

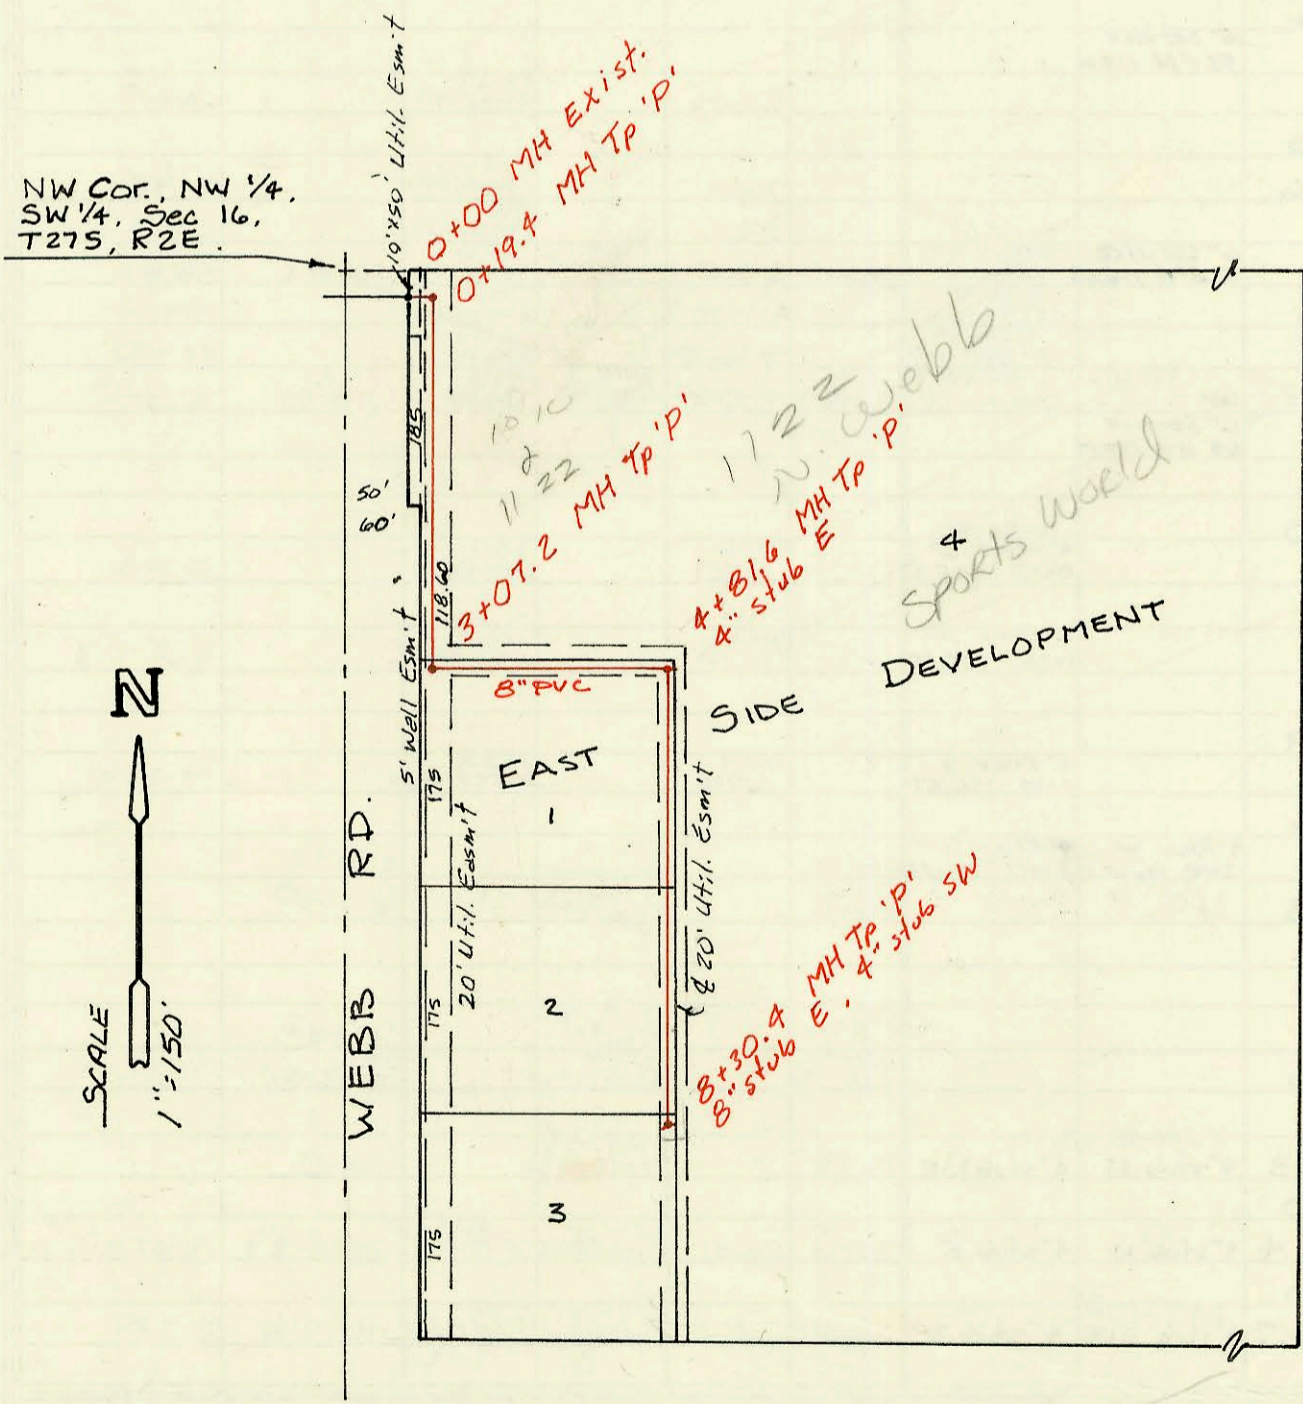

Priv. San. Sewer for East Side Development  
 468-76-245-80001-000-000-158  
 Built By Stannard Const.  
 Booked 5-10-88 From As Built Plan



CONSTRUCTION RECORD							SERVICE RECORD					
STATION	ELEVATION		Depth	MANHOLE	4-INCH "Y" BRANCHES		No. of Permit		House Number		DATE OF PERMITS	
	Ground	Grade			North West	South East	North West	South East	North West	South East	North West	South East
LAT 11, LINE 1	Main 24, W 15											
0+00	193.91	177.86	16.1	EXIST. 0+00								
1+00	194.0	178.97	15.0									
	195.45	179.62 OUT 185.55 IN	15.8	0+00 L-2 1+59.2								
2+00	194.4	185.72	8.7									
3+00	196.2	186.14	10.1		2+61.2 TAP		21952		8445 Bradford		11-10-88	
					3+43.2 TAP		20869		8758 Bradford		6-13-88	
4+00	197.9	186.56	11.3		3+78.2 TAP		20868		8736 Bradford		6-13-88	
5+00	198.0	186.98	11.0									
	198.33	187.08 OUT 187.23 IN	11.3	5+23.5	5+48.5 TAP		23259		8728 Bradford		8-1-88	
6+00	197.5	187.55	10.0									
7+00					6+28.0 TAP		24310		8726 Bradford		11-16-89	
					6+59.3 TAP		24311		8727 Bradford		11-16-89	
LINE 2	198.05	187.98	10.1	7+03.3 1+59.2 L-1 0+00	4" stub NW		9373407		8722 Bradford		4-2-93	
1+00	194.6	179.97	14.6									
2+00	196.2	180.24	16.0									
	196.65	180.40 OUT 180.48 IN	16.3	2+62.6	2+78 4" Riser E 187.12		20866		8710 Bradford		6-13-88	
3+00	197.0	180.62	16.4		3+30 4" Riser E 187.24		20867		8712 Bradford		6-13-88	
					3+87 4" Riser E 187.45		25569		8714 Bradford		6-15-90	
4+00	197.4	180.98	16.4									
	197.62	181.05 OUT 183.38 IN	16.6	0+00 L-3 4+19.6	4+42 4" Riser E 187.54		91-222427		8716 Bradford		5-15-91	
5+00	196.8	183.79	13.0		4+48 4" Riser W 187.07		26121	21490	8808 4 Bradford	8718 Bradford	9-13-90	9-15-88
	196.28	184.13 OUT 184.28 IN	12.2	5+66.8	4" PVC 40 5+76.8 TAP		91-31477-7		8722 Bradford		8-29-91	
6+00	195.8	184.39	11.4		6+34.1 TAP		26128		8800 Bradford		10-30-90	
7+00	194.9	184.74	10.2		7+14.1 TAP		25568		8804 Bradford		6-15-90	
	194.65	184.83	9.8	7+26.1	4" stub VN		91-37303-7		8808 Bradford		11-13-91	
LINE 3	197.62	181.47	16.2	4+19.6 L-2 0+00	0+35 4" Riser NW 187.56		21489	91-21330-7	8810 Bradford	8702 E Bradford	8-1-88	4-26-91
	197.15	181.70 OUT 181.75 IN	15.5	0+93.6								
1+00	196.8	181.77	15.0		1+09 4" Riser S 186.78		24193		8812 Bradford		10-27-89	
					1+62 4" Riser N 185.42		22371	22359	8812 Bradford	8814 Bradford	1-9-89	3-1-88
2+00	194.4	182.02	12.4									
	193.43	182.21 OUT 184.23 IN	11.2	0+00 L-4 2+77.7	2+68.4 TAP		25951		8811 Bradford		8-13-90	
3+00	194.2	184.43	9.8		3+15.4 TAP		21953		8813 Bradford		11-10-88	
	195.82	185.64	10.2	3+66.4	4" stub S		21491		8815 Bradford		9-15-88	
LINE 4	193.43	182.40	11.0	2+77.7 L-3 0+00	4" PVC 40 6+77.8 TAP		91-31477-7		8817 Bradford		8-29-91	
	192.15	182.81 OUT 182.87 IN	9.3	0+84.8	0+92.0 TAP		24312		8807 Bradford		11-16-89	
1+00	192.1	182.98	9.1									
2+00	193.2	183.73	9.5		4" PVC 40 1+83.0 TAP		921146-7		8805 E Bradford		1-28-92	
	193.73	184.15	9.6	2+57.0	2+43.5 TAP		91-20501-7		8802 Bradford		4-16-91	
Priv. San	Sewer for East Side Development											
0+00	172.38	160.45	11.9	0+00								
	174.75	160.52 162.95	14.2	0+19.4								
1+00	177.4	163.41	14.0									
2+00	176.5	163.97	12.5									
3+00												
	179.45	164.58 OUT 164.75 IN	14.9	3+07.2								
4+00	178.7	165.31	13.4									
	178.57	165.81 165.91	12.8	4+81.6	4" stub E		20607		1122 N Webb		5-4-88	
5+00	178.0	166.03	12.0									
6+00	180.0	166.67	13.3									
7+00	181.8	167.32	14.5									
					4" PVC 40 7+65.6 TAP		91-18941-1		950 N Hobby Rd	(Sports World Club to Hobby Golf Club)		2-26-91
8+00	182.0	167.96	14.0									
	182.51	168.16	14.4	8+30.4	4" stub SW	8" stub E						