

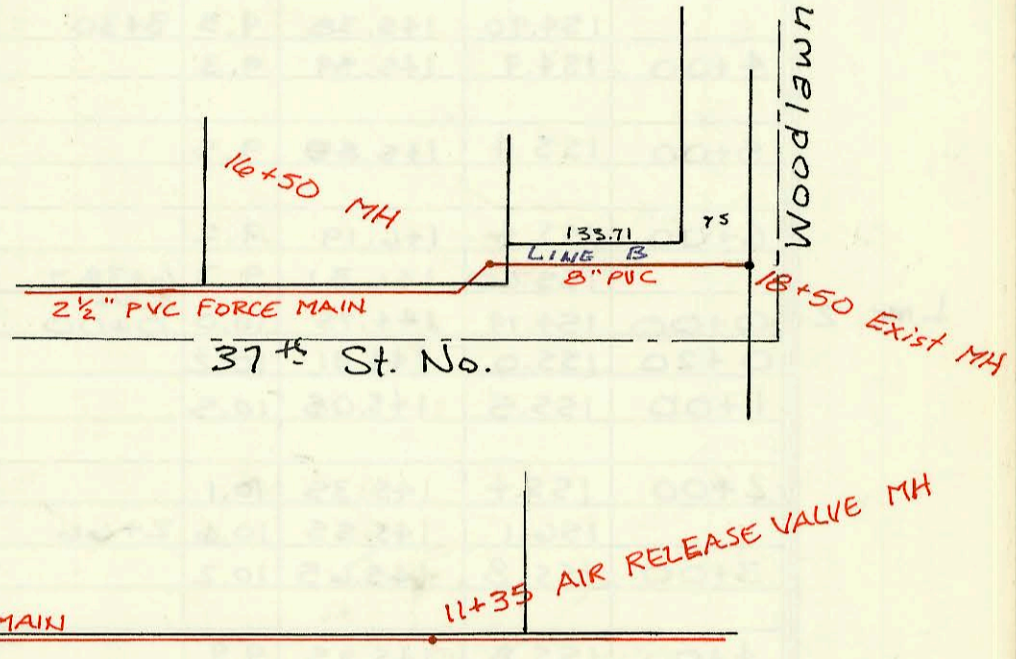


Priv. S.S. for COZY HOMES ADDN. (Bel-Aire)
 468-76-245-80001-000-000-153
 Built By Nowak Const
 Booked 6-13-88 from As Built Plan



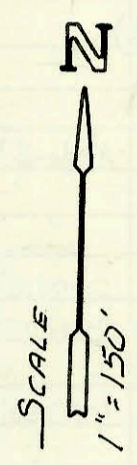


off Septic
 5730

37th St. No.

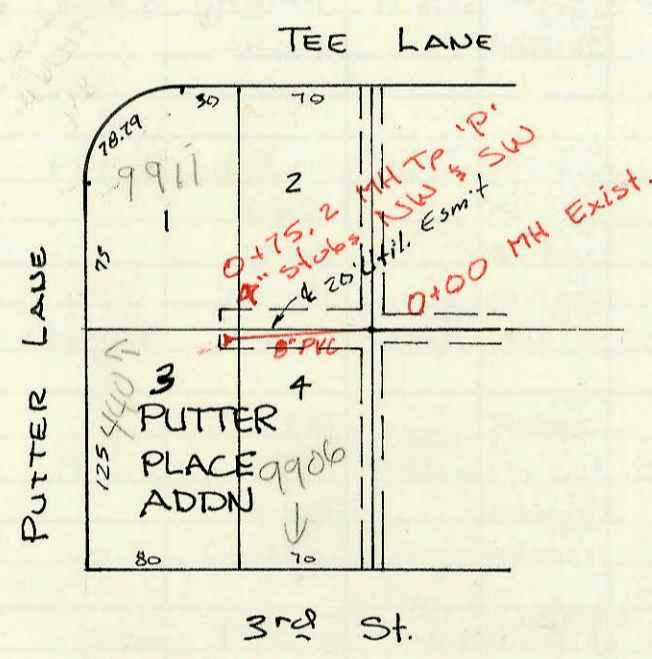


Priv. SAN. SEW. FOR LOTS 1-4 PUTTER PLACE ADDN.
 448-76-245-80001-000-000-154
 Built By McCullough Excavating.
 Booked 8-8-88 from BR-18

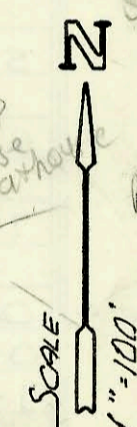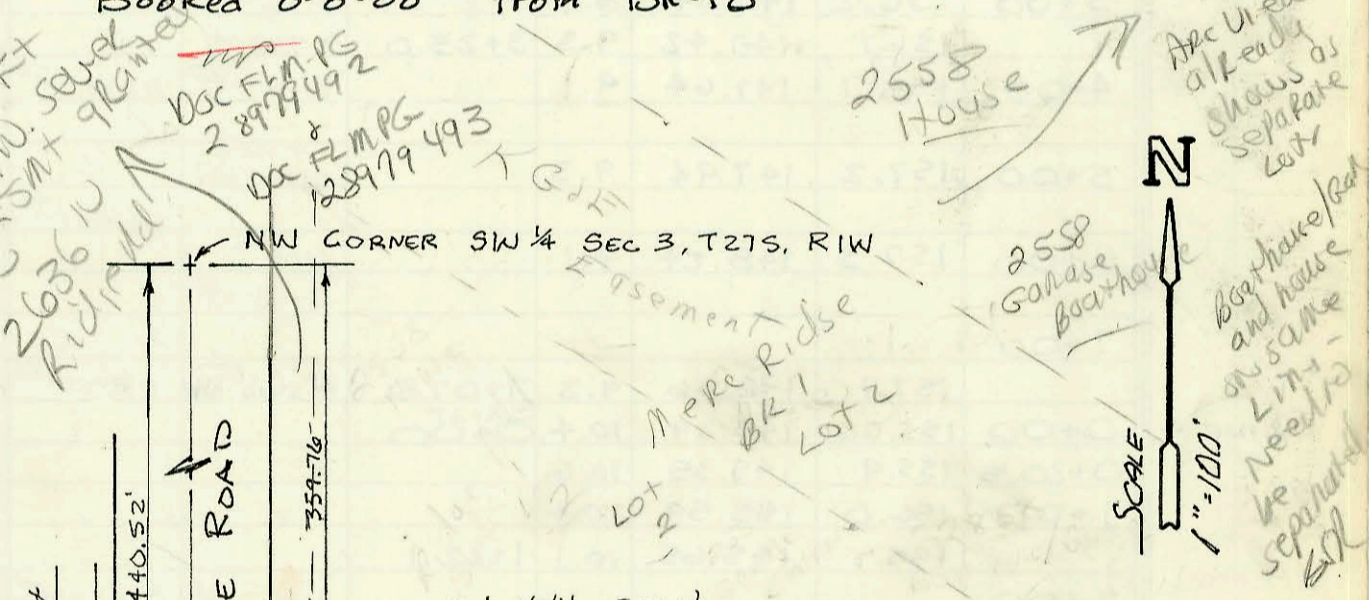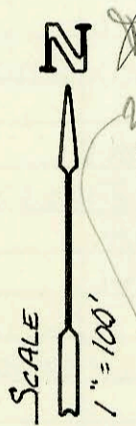

Priv. San. Sewer for ECK RESIDENCE
 468-76-245-80001-000-000-168
 Built By Utility Contr.
 Booked 8-9-88 from As Built Plan.



634

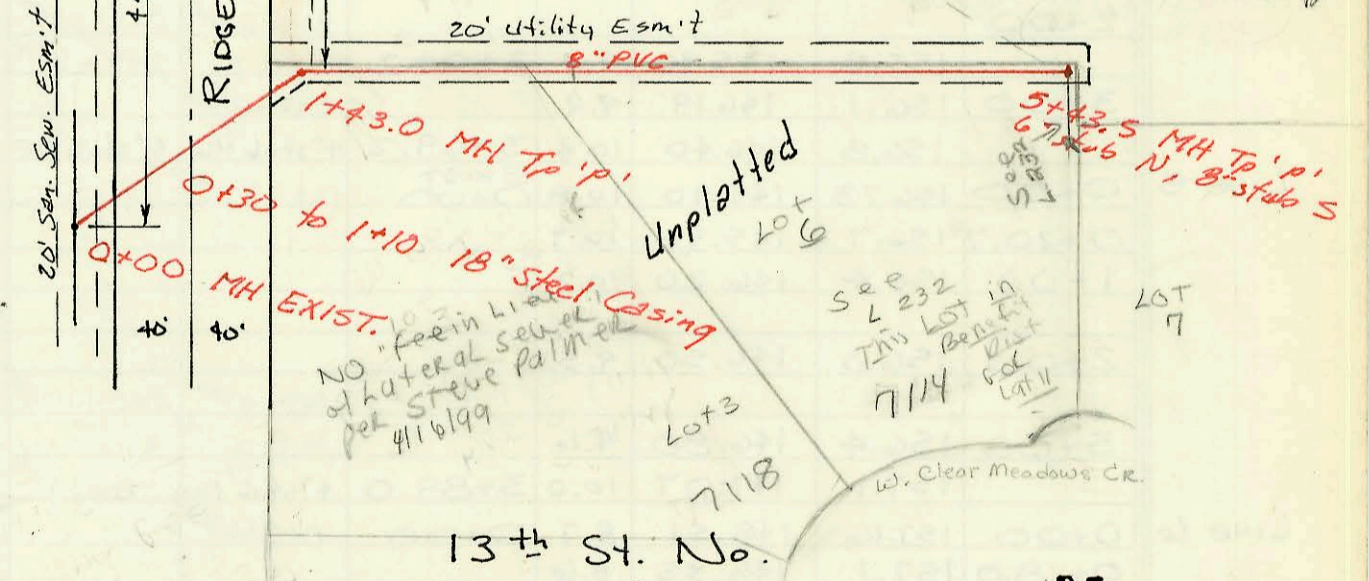

Priv. San. Sewer for part of
 Lot 27, Blk 1, Williamsburg Addn.
 468-76-245-80001-000-000-169
 Built By Stannard Const
 Booked 8-9-88 from As Built Plan

2636 N Ridge Rd - paid \$4,300
 Fee in lieu of Lateral Assess.
 on plan 108 Recp# 442008-174

OLIVER

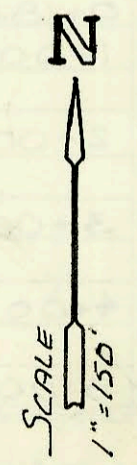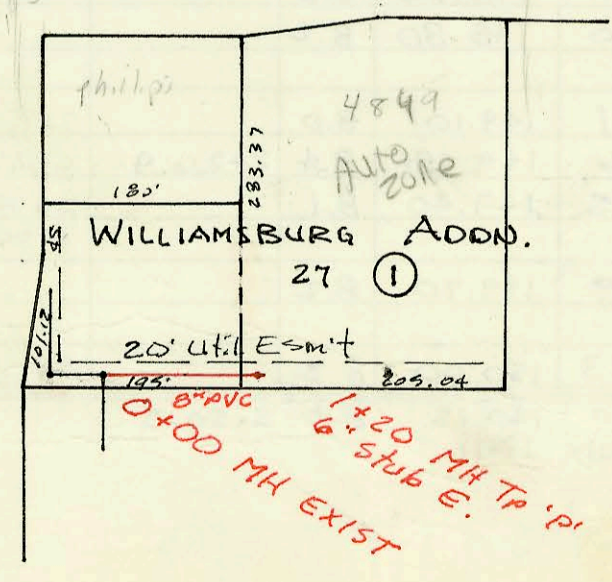

Prop. Lot split 11861
 App Util. already shows as separate lot
 2558 House
 2558 Garage Boothouse
 Boothouse/Bat and house on 59th Ave
 Need to be separate lot

CONSTRUCTION RECORD							SERVICE RECORD					
STATION	ELEVATION		Depth	MANHOLE	4-INCH "Y" BRANCHES		No. of Permit		House Number		DATE OF PERMITS	
	Ground	Grade			North West	South East	North West	South East	North West	South East	North West	South East
Priv. S.S. for Cozy Homes Addn.												
LINE 1 0+00	192.90	184.10	8.8	0+00 L-A		0+08.0 TH		20944		5900 37TH		6-24-88
1+00	193.7	184.50	9.2									
2+00	194.2	184.91	9.3		1+98.0 TH		2351		3817 Cozy LN		8-3-88	
3+00	194.1	185.03	9.1	2+30		2+96.0 TH		20945		3820 Cozy LN		6-24-88
4+00	194.8	185.36	9.4	3+10	4+12.5 TH		26722		3901 Cozy LN		1-24-91	
5+00	192.8	185.73	8.4		4+76.0 TH		21243		3911 Cozy LN		8-1-88	
6+00	192.0	186.55	5.4									
	191.7	186.63	5.1	6+20	6+12.0		2674		3921 Cozy LN		6-9-94	
LINE A 0+00	192.9	185.10	7.8	0+00 L-1								
1+00	193.3	186.57	6.7									
2+00	193.4	188.04	5.4		4" SDR35 1+77.3 MP		#1331		3874 Cozy		10-22-91	
	193.3	188.53	4.8	2+33.3	4" SDR35 EXIST		2494 2658		5730 A E 37TH		4-1-98 4-13-94	
LINE B 18+50	186.40	174.60	11.8	18+50								
18+00	186.21	175.71	10.5									
17+00	188.44	177.94	10.5									
16+50	189.85	179.05	10.8	16+50								
Priv. S.S. for Lots 1-4, Putter Place Addn.												
0+00	156.7	148.90	7.8	EXIST 0+00								
	157.1	149.20	7.9	0+75.2	4" stub NW	4" stub SW	25394 22701	21249	9911 Teer LN	9916 470 3rd Putter Pl	5-21-90 3-13-89	8-1-88
Priv. San. Sewer for Eck Residence												
0+00	140.21	130.49	9.7	EXIST 0+00								
1+00	138.0	130.79	7.2									
	138.84	130.91 out 131.01 in	7.9	1+43.0								
2+00	139.5	131.19	8.3				99-8576-7		7118 Clem Meadows Ct		5-7-99	
3+00	140.6	131.49	9.1									
4+00	140.0	131.79	8.2									
5+00	139.5	132.09	7.4		Tied House and Det'd Bathhouse to 6" stub N	8" stub S	93-3880-7 21586		6558 House Ridge Rd 2568 Ridge Rd 2538 N Ridge	7114 W Clem Meadows Ct	9-27-88 7-20-88	2-23-93
	139.43	132.21	7.2	5+43.5	6" stub N	8" stub S	2128 2000-00486		2568 Ridge Rd 2538 N Ridge	STORMAGE BLDG	2-23-00	
Priv. S.S. for Part of Lot 27, Blk 1, WILLIAMSBURG												
0+00	205.82	193.56	12.3	EXIST 0+00								
1+00	205.4	194.06	11.3									
	205.50	194.16	11.3	1+20		6" stub E	99-19711-7 23263		4844 B E 13TH		11-6-97 8-13-88	

NOTE: 2558 N. Ridge Rd - House and Det'd Bathhouse Tied together with one line connecting into MT stub.