

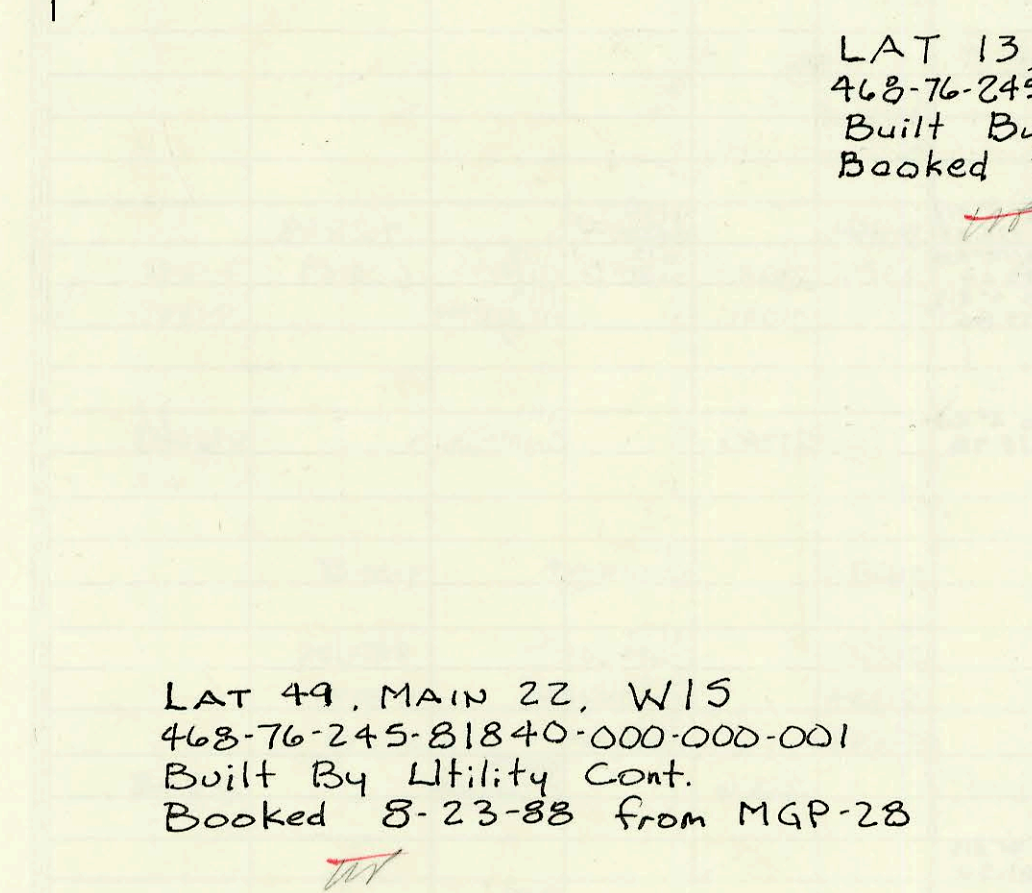
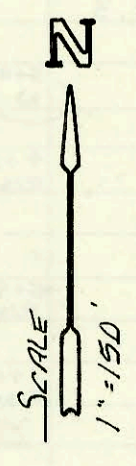




LAT 1, MAIN 15, S.W. INTERCEPTOR
 468-76-245-81738-000-000-001
 Built By Stannard Const.
 Booked 7-21-88 from JLA # 9

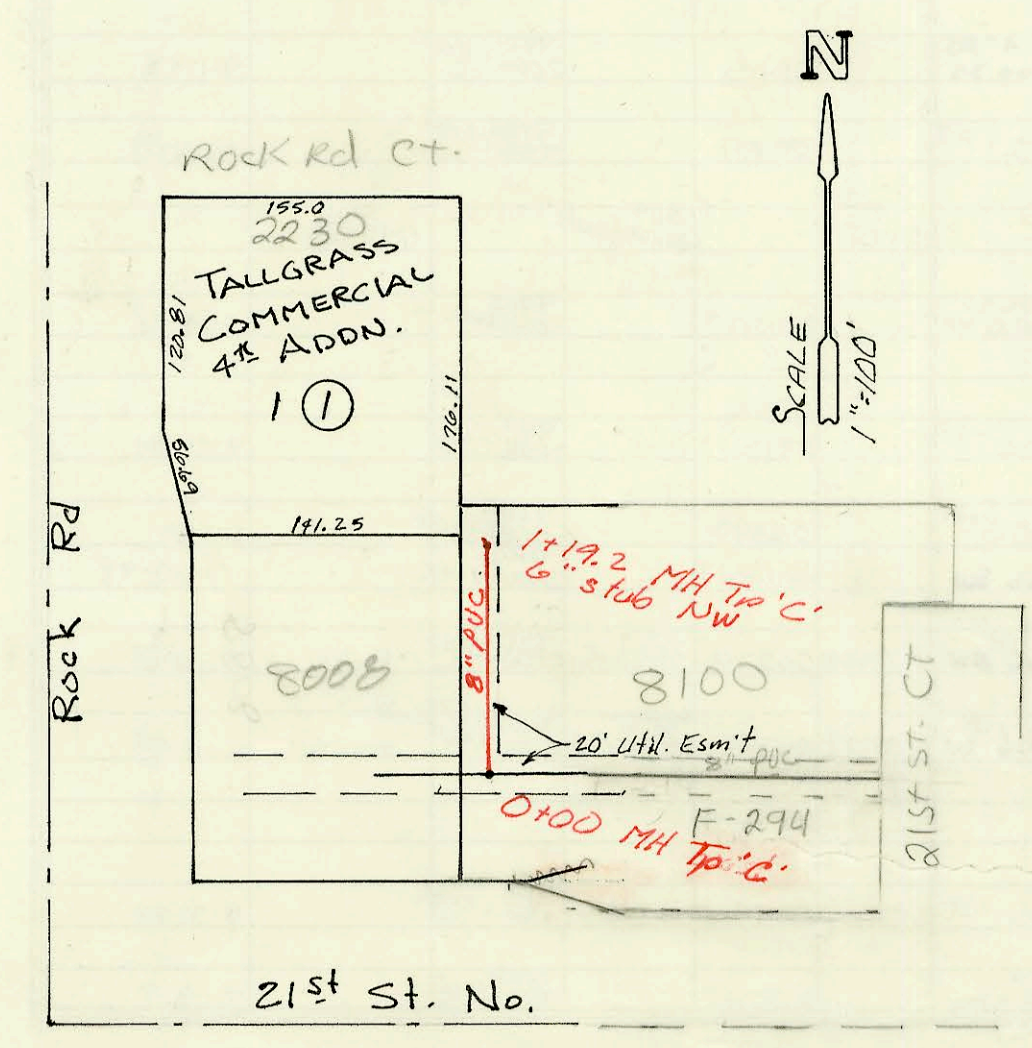

LAT 13, MAIN 9, SW I
 468-76-245-81817-000-000-001
 Built By Stannard Const.
 Booked 7-22-88 from DK-1

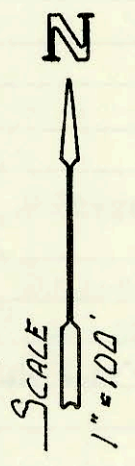

LAT 49, MAIN 22, W15
 468-76-245-81840-000-000-001
 Built By Utility Cont.
 Booked 8-23-88 from MGP-28

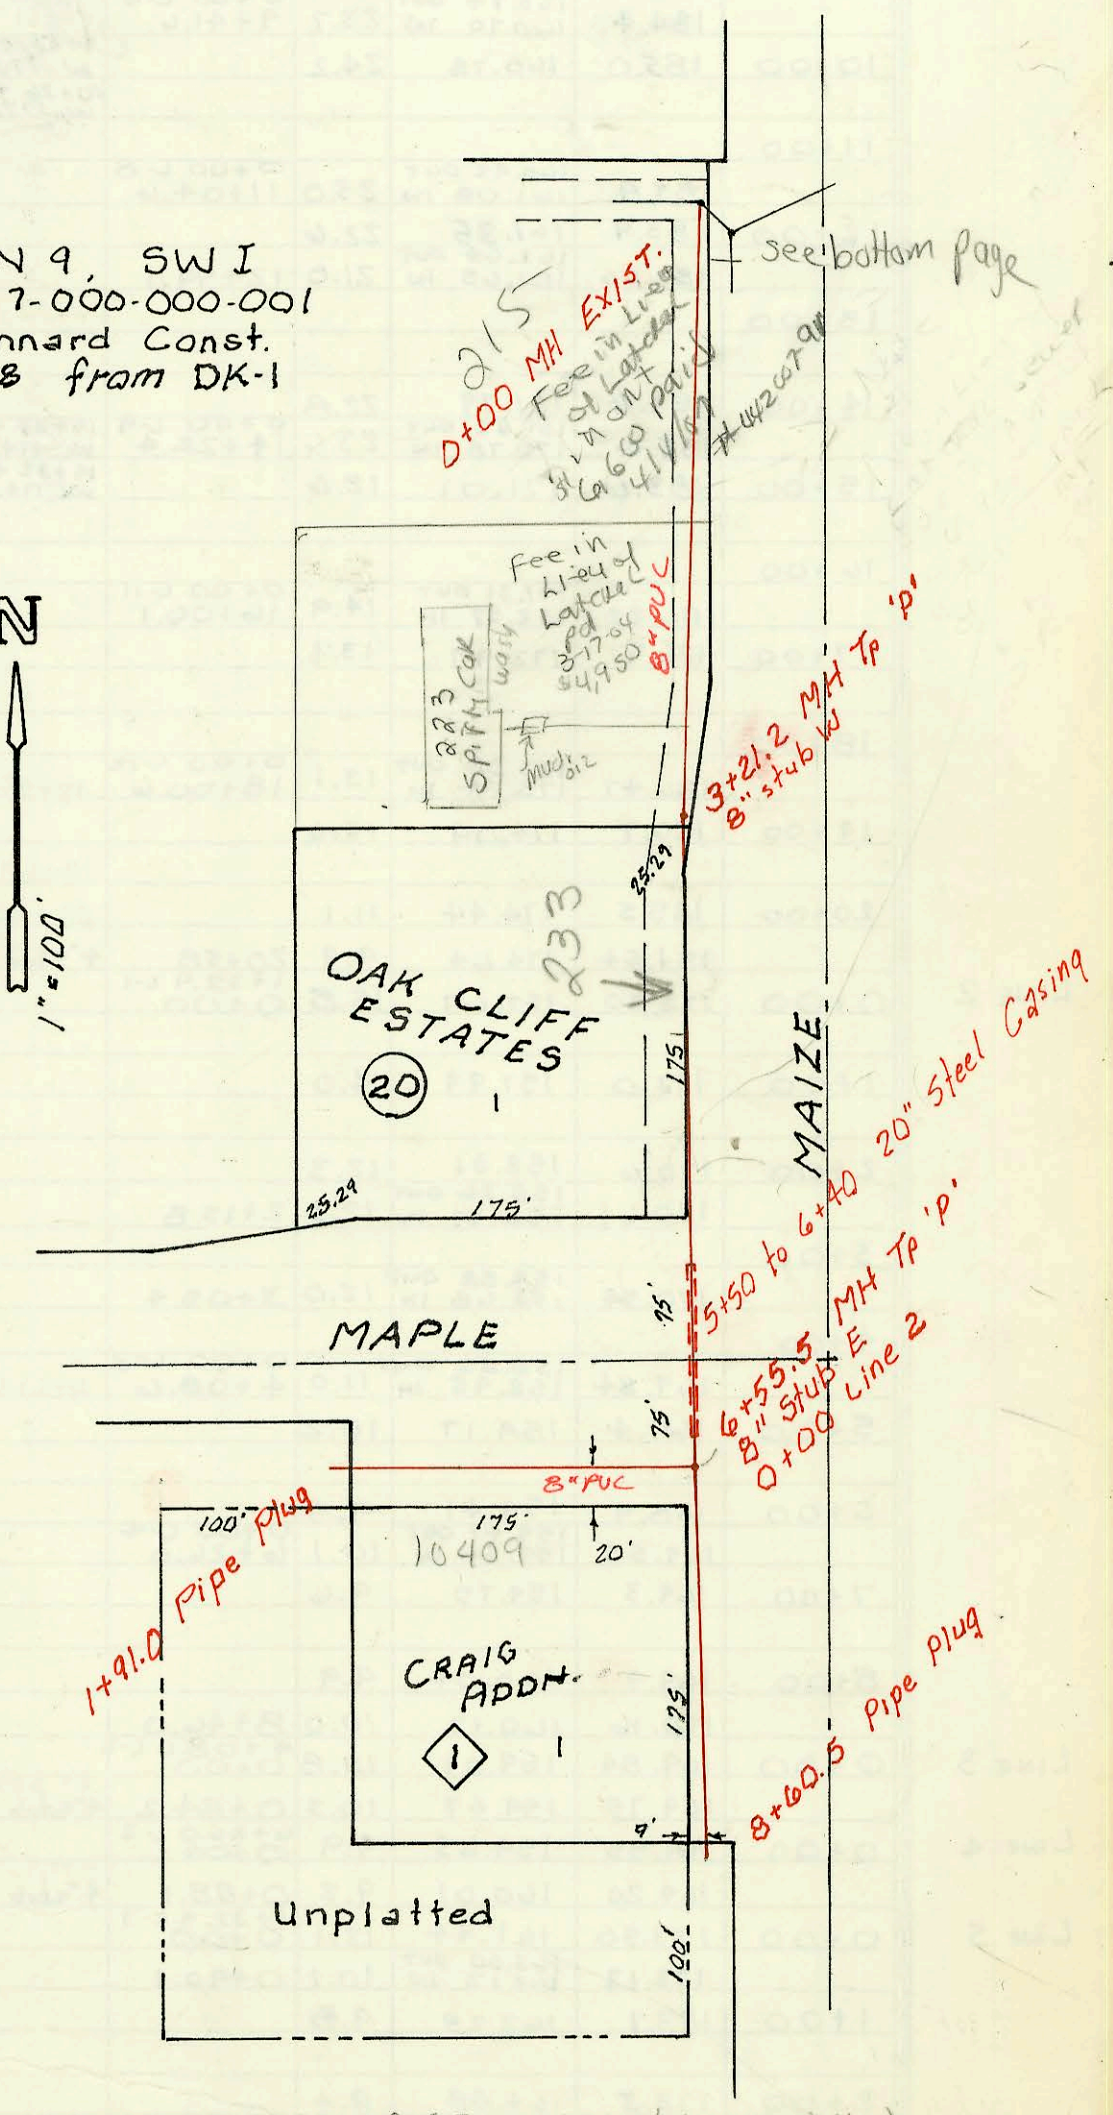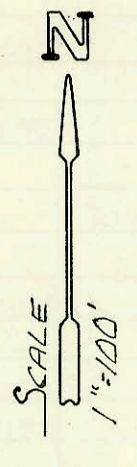

SWR2007-00845-215 S Maize - 45' Noring (mil) (tap)

