


MAIN 15, SW1 (Phase II)
468-76-245-81618-000-000-001
Standard Const. Built
Booked 7-27-88 from TCD-60

No Bldg Connections
to 15" Main

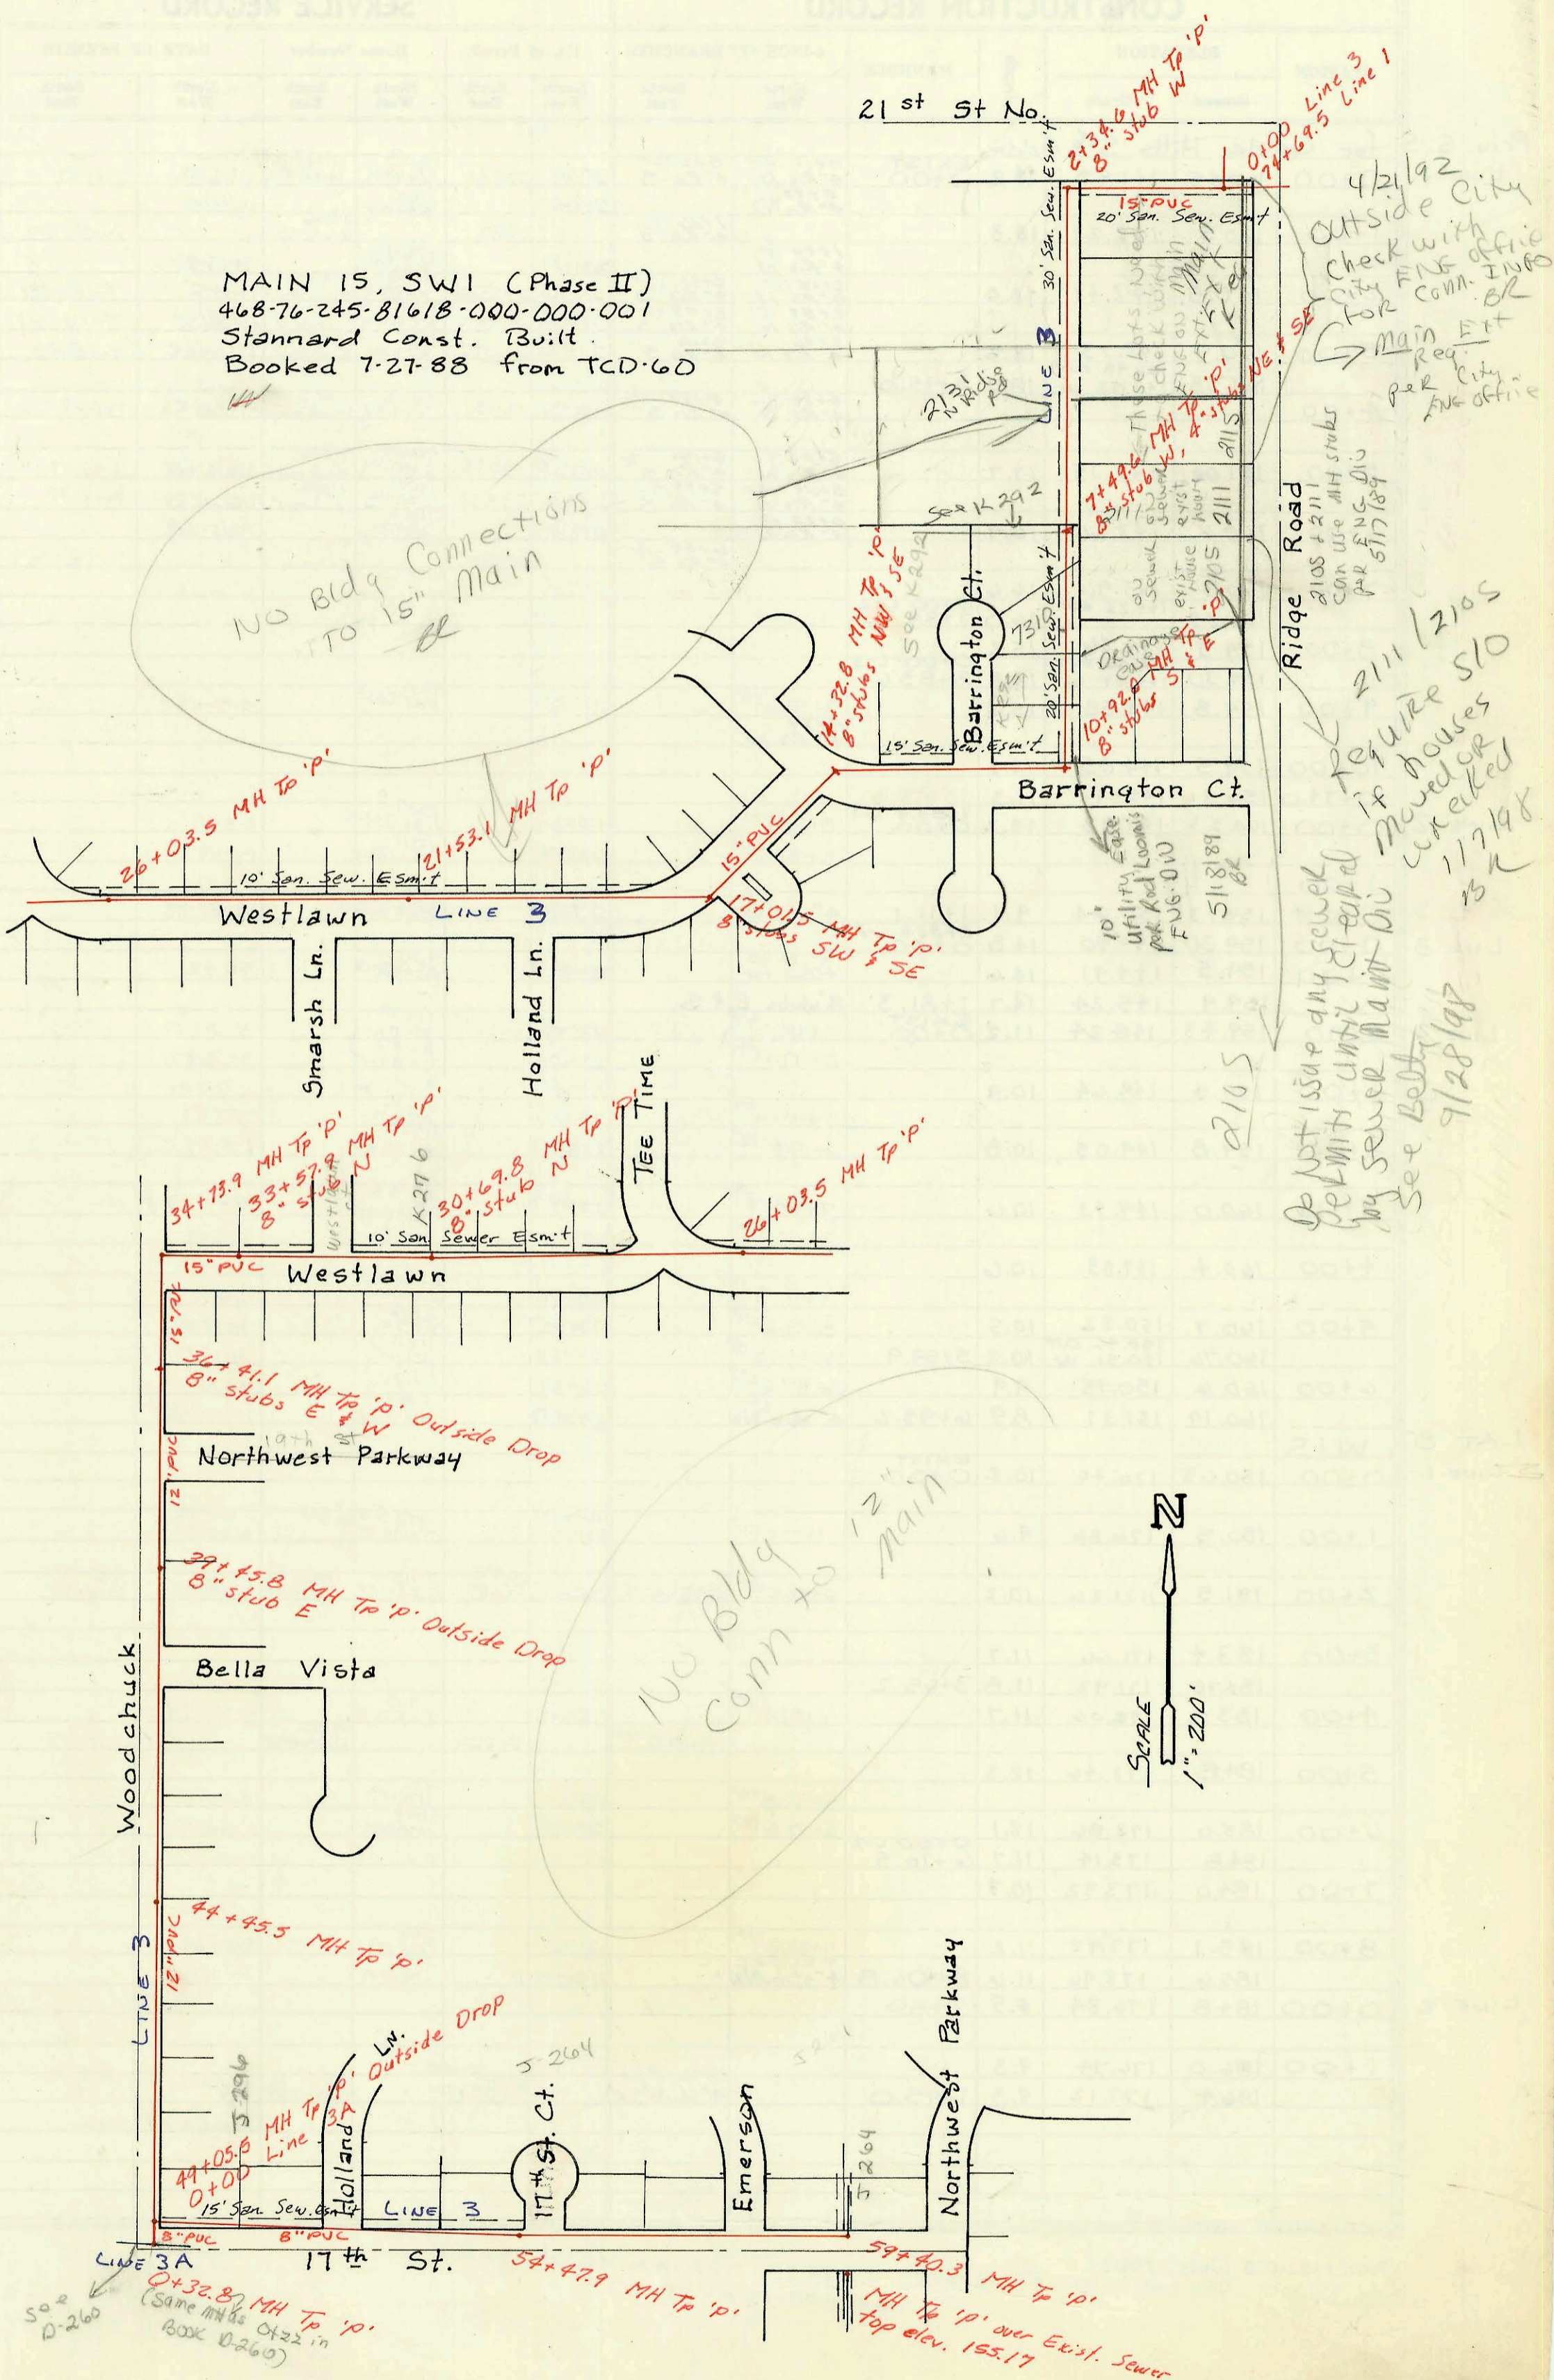

4/21/92
Outside City
Check with
City Eng. Office
for Comm. Info.
Main Ext.
Per City Eng. Office

2111/2105
Require SLO
if houses
moved or
checked
1/7/98
BR

Do not issue any sewer
permits until created
by sewer maint. Div
See Betty
9/28/98

2105



No Bldg
Conn to 12" Main

See
D-260
0+32.87 MH Tp 'P'
(Same MHs as 0+22 in
Book D-260)

CONSTRUCTION RECORD

SERVICE RECORD

MAIN 15

STATION	ELEVATION		Depth	MANHOLE	4-INCH "Y" BRANCHES		No. of Permit		House Number		DATE OF PERMITS	
	Ground	Grade			North West	South East	North West	South East	North West	South East	North West	South East
8+00	144.8	129.24	15.6									
9+00	144.0	129.50	14.5									
10+00	143.7	129.76	13.9									
	145.52	130.00 out 130.03 in	15.5	10+92.0	8" stub S	8" stub E						
11+00	144.2	130.05	14.2									
12+00	144.3	130.23	14.1									
13+00	144.5	130.42	14.1									
14+00	144.6	130.61	14.0									
	145.06	130.67 out 130.76 in	14.4	14+32.8	8" stub NW	8" stub SE						
15+00	145.2	130.95	14.3									
16+00	145.9	131.24	14.7									
17+00		131.53 131.53 out 131.54 in	15.0	17+01.5	8" stub SW	8" stub SE						
18+00	146.5	131.75	14.8									
19+00	146.8	131.95	14.9									
20+00	147.4	132.16	15.2									
21+00	148.0	132.37	15.6									
	148.81	132.48	16.3	21+53.1								
22+00	148.8	132.57	16.2									
23+00	149.6	132.75	16.9									
24+00	151.5	132.94	18.6									
25+00	155.0	133.13	21.9									
26+00												
	153.58	133.32	20.3	26+03.5								
27+00	154.5	133.55	21.0									
28+00	155.5	133.79	21.7									
29+00	155.8	134.03	21.8									
30+00	155.4	134.26	21.1									
	154.95	134.43	20.5	30+69.8	8" stub N							
31+00	155.3	134.50	20.8									
32+00	156.0	134.74	21.3									
33+00	156.4	134.97	21.4									
	155.67	135.11	20.6	33+57.9	8" stub N							
34+00	155.8	135.18	20.6									
	155.70	135.29 out 135.40 in	20.4	34+73.9								
35+00	155.3	135.51	19.8									
36+00	156.7	135.91	20.8									
	156.53	136.08	20.5	36+41.1	8" stub W	8" stub E						
37+00	157.2	136.26	20.9									
38+00	157.0	136.57	20.4									
39+00	156.5	136.87	19.6									
	156.36	137.01	19.4	39+45.5		8" stub E						
40+00	156.6	137.17	19.4									
41+00	156.7	137.46	19.2									
42+00	156.0	137.75	18.3									
43+00	156.5	138.04	18.5									
44+00	156.5	138.33	18.2									
	156.96	138.46	18.5	44+45.6								
45+00	156.8	138.61	18.2									
46+00	157.3	138.89	18.4									
47+00	158.5	139.17	19.3									
48+00	158.6	139.45	19.2									
49+00	159.5	139.72	19.8									
	157.94	139.74 out 140.21 in	18.2	49+00 L-3A 49+05.5								
50+00	159.3	140.57	18.7									
51+00	160.2	140.95	19.3									
52+00	161.0	141.32	19.7									
53+00	159.5	141.70	17.8									
54+00	157.8	142.08	15.7									
	157.02	142.26	14.8	54+47.9								
55+00	156.6	142.46	14.1									
56+00	156.0	142.83	13.2									
57+00	155.5	143.21	12.3									
58+00	154.8	143.59	11.2									
59+00	154.4	143.97	10.4									
	154.48	144.12	10.4	59+40.3								
0+00	157.94	146.28	11.7	49+05.5 0+00								
	157.85	147.67	10.2	0+32.8								

LINE 3A