
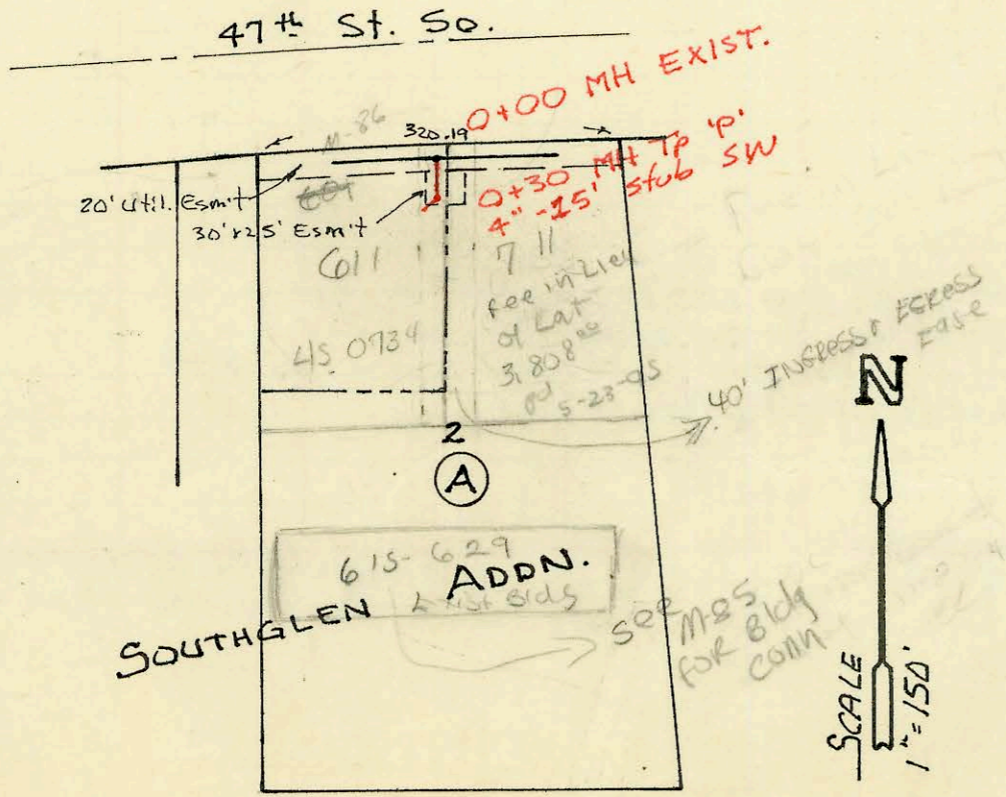
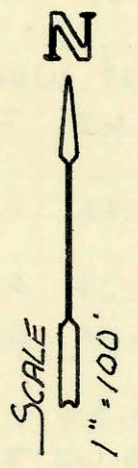


L-44

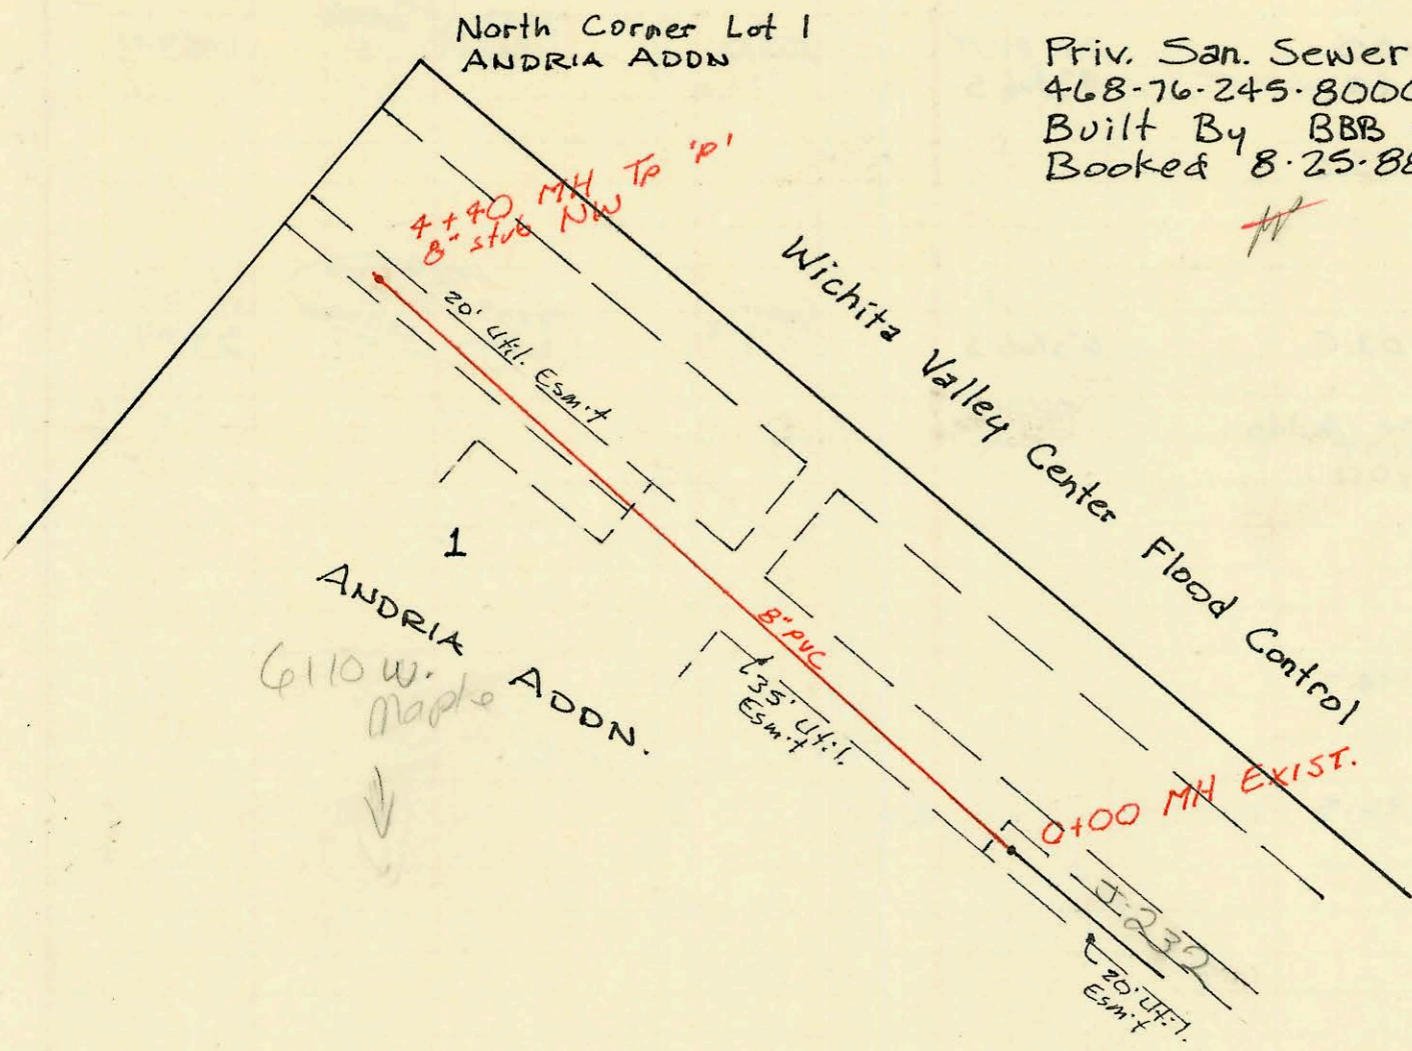

CONSTRUCTION RECORD							SERVICE RECORD						
STATION	ELEVATION		Depth	MANHOLE	4-INCH "Y" BRANCHES		No. of Permit		House Number		DATE OF PERMITS		
	Ground	Grade			North West	South East	North West	South East	North West	South East	North West	South East	
LAT 85, WIS													
LINE 1	0+00	176.63	166.97	9.7	EXIST. 0+00		4" SDR 35 0+23.0 tap		92-8219-7		1035 N Post oak		6-4-92
	1+00	178.9	167.27	11.6									
		179.0	167.37	11.6	1+34.9								
	2+00	178.6	167.67	10.9		2+47.9 ^{10"}		21380		1031 Post oak		8-26-88	
	3+00	178.3	167.97	10.3									
		178.0	168.22	9.8	0+00 L-2 3+83.0								
	4+00	177.8	168.29	9.5		4+11.0 ^{10"} 4" stub SW		21381 2000-02526 23462		1027 Post oak 1023 Post oak	Repl 8' Lowend	8-26-88 11-17-00 6-30-89	
LINE 2	0+00	178.0	168.32	9.7	0+00								
	1+00	178.3	168.62	9.7									
		179.4	168.92	10.5	1+99.0								
	2+00						1+55.0 tap		26741		1024 Post oak		12-12-90
	2+24.0	179.2	168.99	10.2									
LINE 3	0+00	179.4	169.72	9.7	0+00								
	1+00	179.7	170.12	9.6		4" SDR 35 0+98.4 tap		2239863-7 98-		1028 N Post oak 1032 Post oak	1027 Broadmoor	10-28-92 12-10-98	
		180.4	170.27	10.1	1+37.6	4" SDR 35 1+62.6 tap		2364667				15-12-92	
	2+00	180.4	170.52	9.9		4" SDR 40 2+72.6 4" SDR 35 2+67.6 tap		2001- 00693		1031 N Broadmoor		3-30-01	
	3+00	181.2	170.92	10.3				92-39716-7		1036 Post oak		9-30-92	
	4+00	181.9	171.32	10.6		NO INTERVAL 4" SDR 40 4+42.3 Predco 4" SDR 35 4+42.3		379787 98-377		1040 Post oak	1035 Broadmoor	6-7-97 2-19-98	
		182.9	171.66	11.2	4+84.9	4" stub NE	4" stub NE	93-01197 01211		1104 N Post oak	1039 Broadmoor 1103 Broadmoor	12-29-93 6-20-02	
Priv. Sewer for Lot 1 ANDRIA ADDN. (PHASE II)													
	0+00	124.2	112.28	11.9	EXIST. 0+00								
	1+00	123.6	112.68	10.9									
	2+00	124.0	113.08	10.9					21366		6110 Maple (APTD)		8-24-88
	3+00	124.8	113.48	11.3				2003 01224		6100 Maple (Add Tech)		5-7-03	
	4+00	125.6	113.88	11.7									
		126.0	114.04	12.0	4+40.0	8" stub NW							
Priv. S. S. Ext. for Tract A, Lot 2, Blk A, SOUTGLEN ADDN.													
	0+00	84.61	74.25	10.4	0+00				95-96567		711 E 47th S		6-28-95
		83.64	78.60	5.0	0+30	15" 4" stub SW		21333		6111 47th S		8-19-88	