



LAT 273, SW. INTERCEPTOR
 468-76-245-81872-000-000-001
 Built By Stannard Const.
 Booked 11-29-88

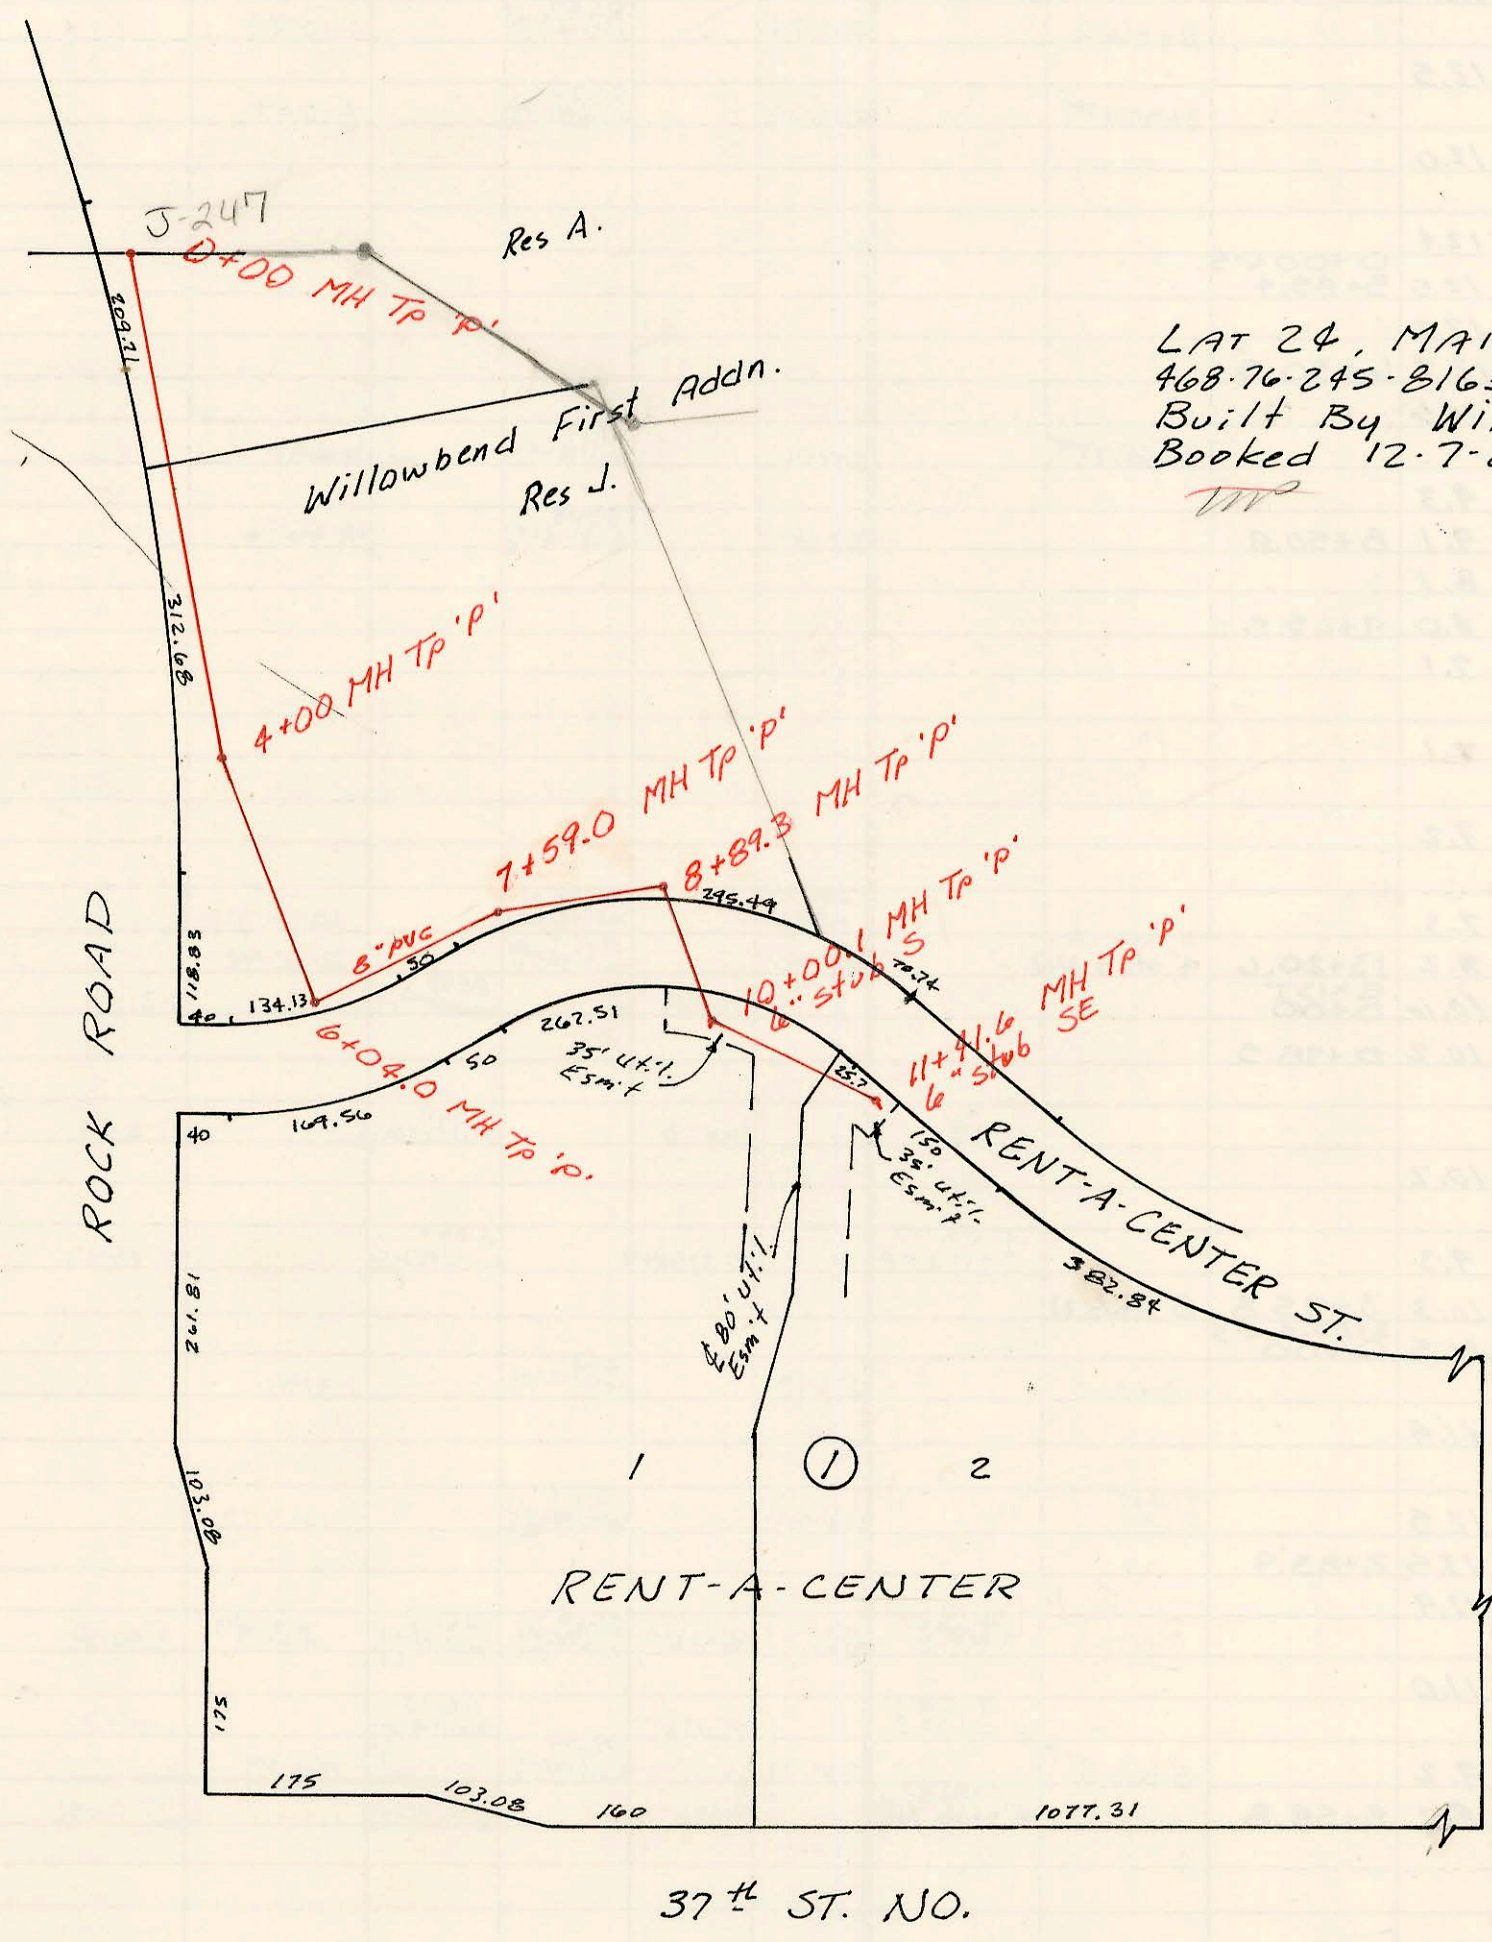

LAT 24, MAIN 9, S.S. #23
 468-76-245-81636-000-000-001
 Built By Wildcat Const. Co.
 Booked 12-7-88 from Plan

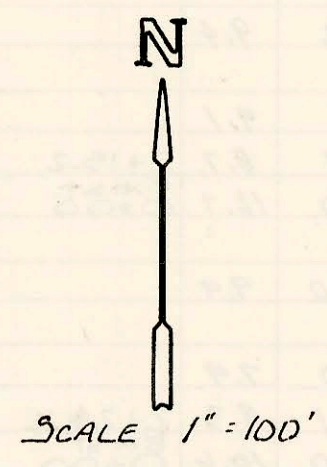