
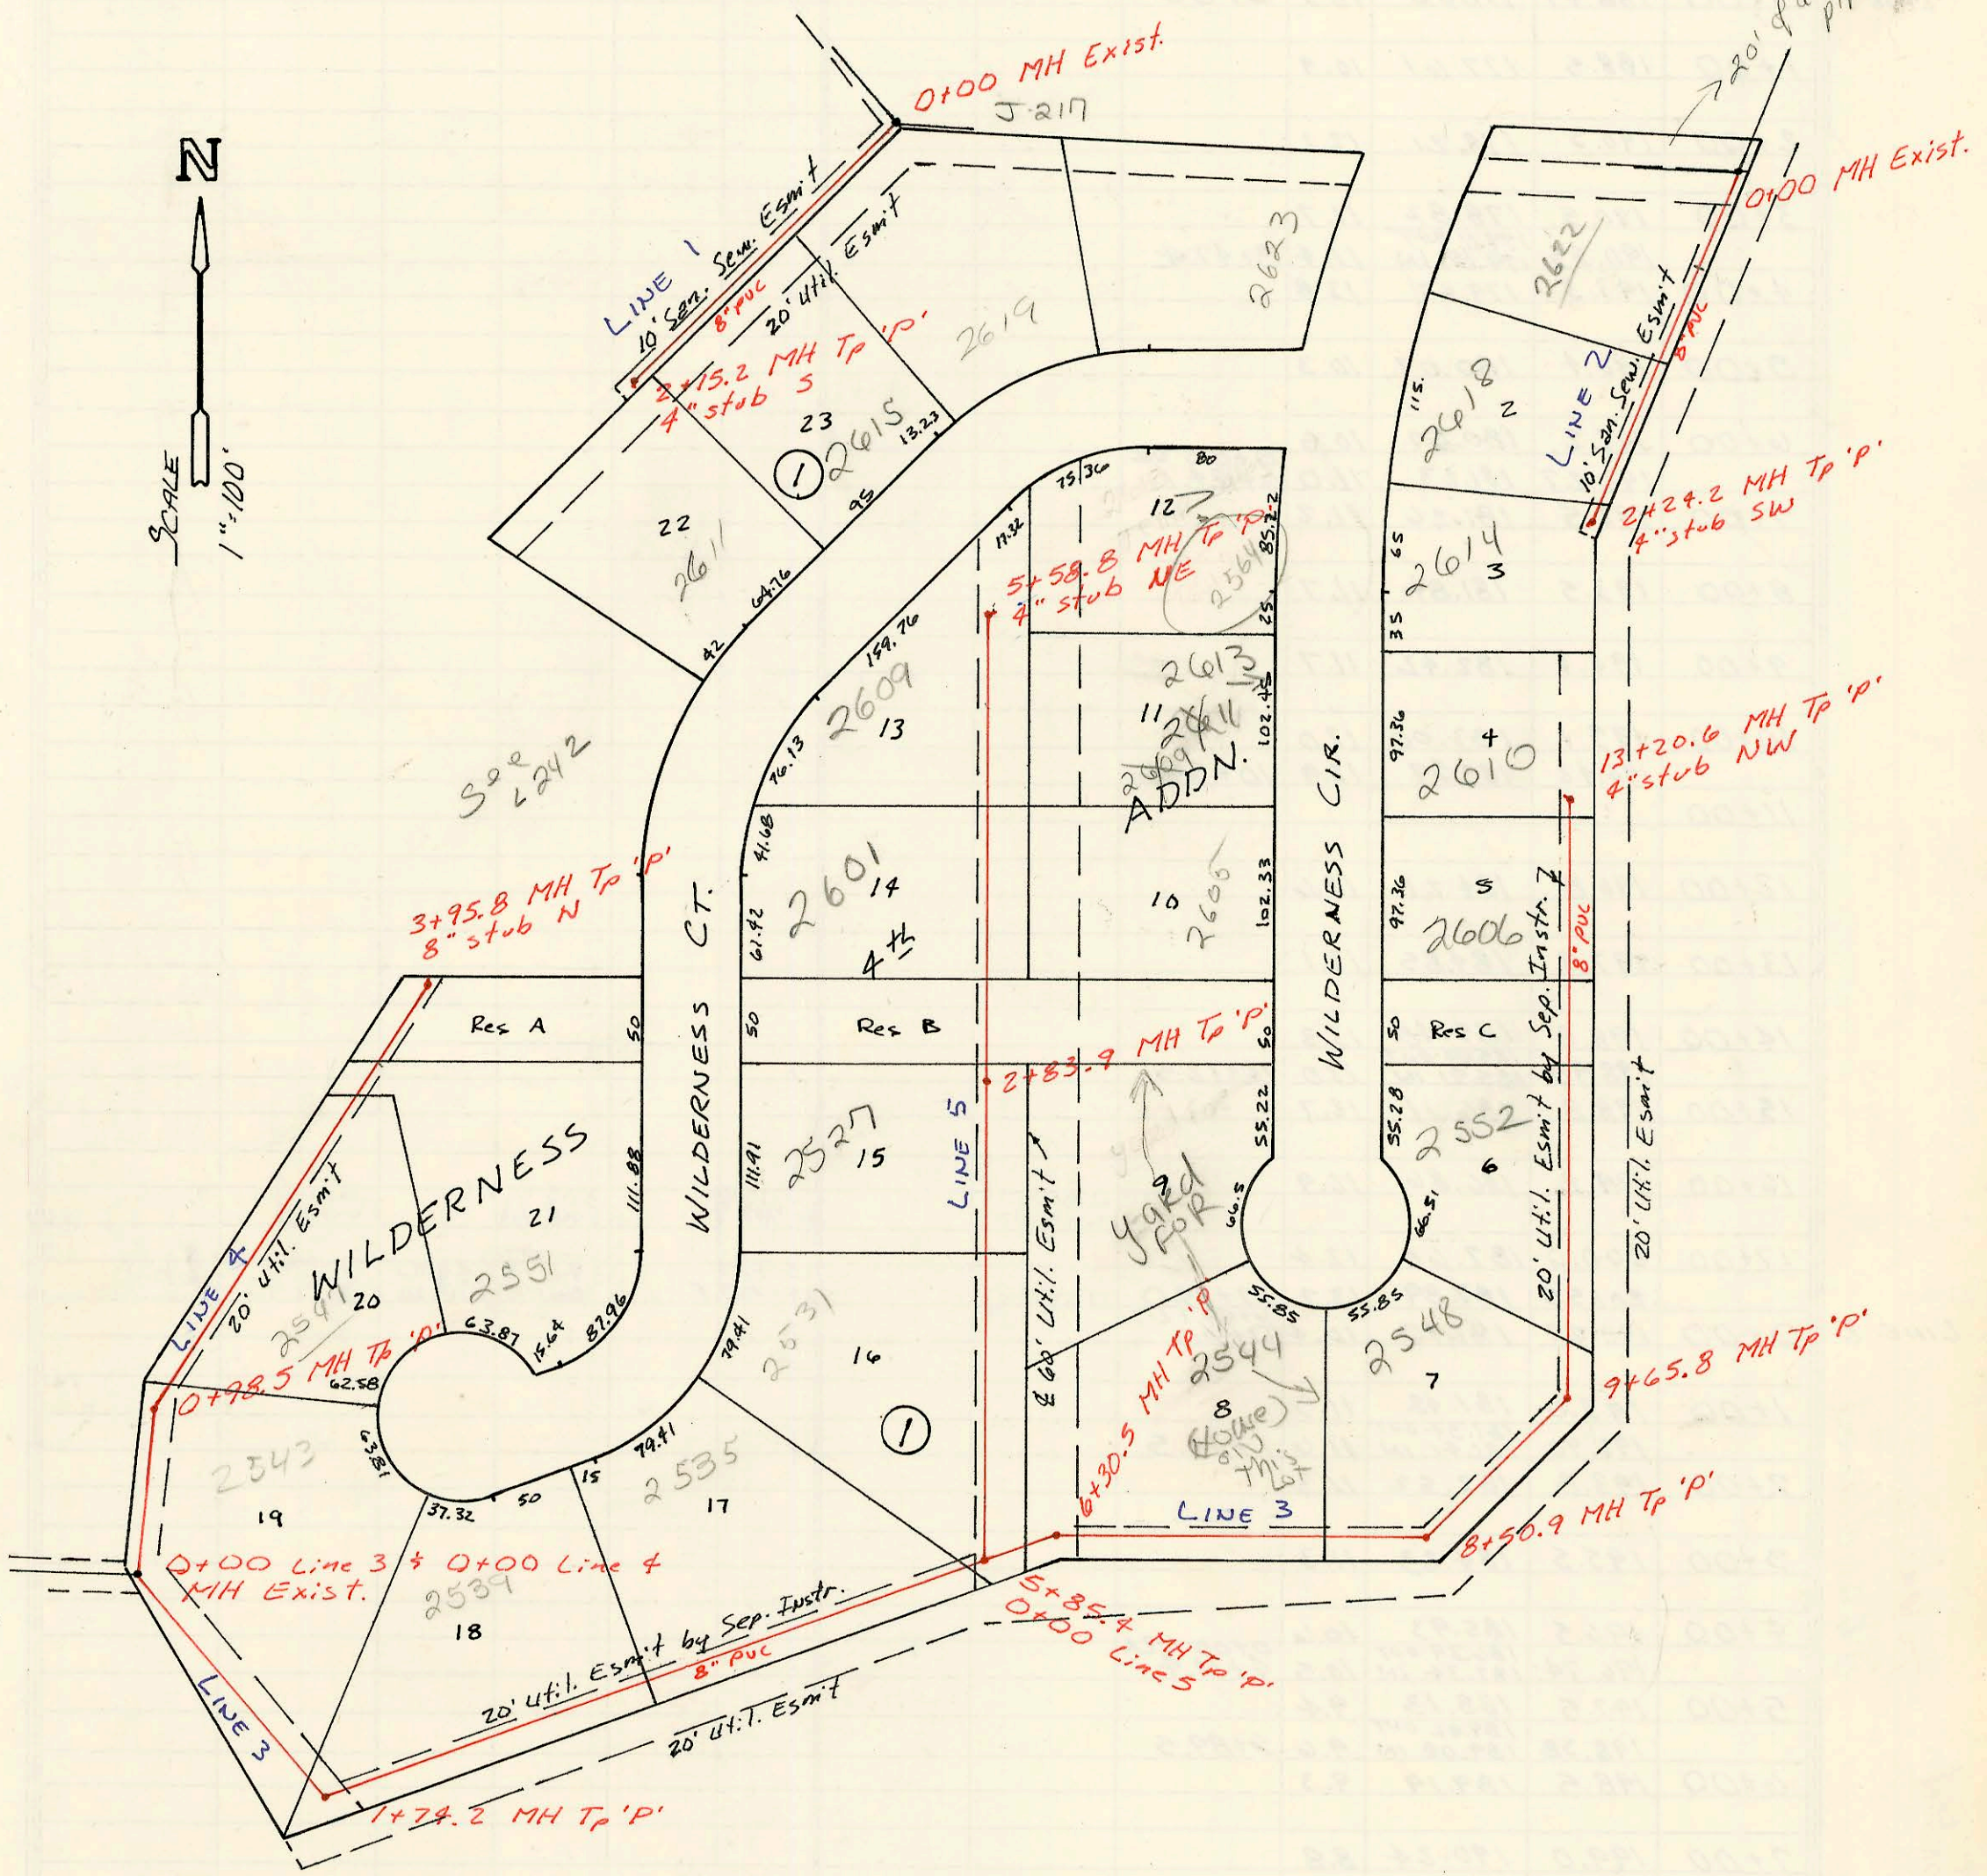


LAT 48, MAIN 22, W.I.S.
468-76-245-81805-000-000-001
Built By Stannard Const.
Booked 12-8-1988 from Plan

Handwritten initials

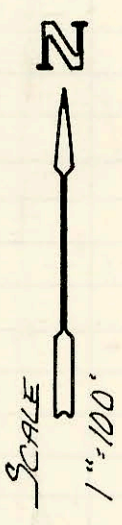

| CONSTRUCTION RECORD | | | | | | | SERVICE RECORD | | | | | | |
|---------------------|-----------|--------|-------------------------|---------|------------------------------|-----------------------|-------------------------|------------|----------------|--------------------|----------------------|--------------------|----------|
| STATION | ELEVATION | | Depth | MANHOLE | 4-INCH "Y" BRANCHES | | No. of Permit | | House Number | | DATE OF PERMITS | | |
| | Ground | Grade | | | North West | South East | North West | South East | North West | South East | North West | South East | |
| LAT 48 MAIN 22, WIS | | | | | | | | | | | | | |
| LINE 1 | 0+00 | 205.80 | 192.32 | 13.5 | EXIST 0+00 | 4" PVC 40 62.0 top | 0+14.0 TAP | 92-1633-7 | 26869 | 2624 wilderness | 2619 wilderness | 1-31-92 | 1-14-91 |
| | 1+00 | 202.7 | 193.32 | 9.4 | | | | | | | | | |
| | 2+00 | 203.4 | 194.32 | 9.1 | | | 1+77.2 TAP | | 22909 | | 2615 wilderness | | 4-12-89 |
| LINE 2 | 0+00 | 203.2 | 194.47 | 8.7 | 2+15.2 EXIST 0+00 | | 4" stub S | | 25042 | | 2611 wilderness | | 4-3-90 |
| | 1+00 | 207.5 | 197.60 | 9.9 | | | 1+41.8 TAP | | 23311 | | 2608 wilderness | | 6-5-89 |
| | 2+00 | 206.8 | 198.90 | 7.9 | | | | | | | | | |
| | | 207.2 | 199.21 | 8.3 | 2+24.2 EXIST 0+00 | 4" sch 40 PVC | 4" stub SW | 91-30262-7 | | | 2614 wilderness | | 8-20-91 |
| LINE 3 | 0+00 | 196.06 | 185.50 | 10.6 | 0+00 | | | | | | | | |
| | 1+00 | 198.0 | 187.70 | 10.3 | | | 1+33.0 TAP | | | | 2593 wilderness | | 1-31-91 |
| | | 201.0 | 189.33 OUT 189.53 IN | 11.7 | 1+74.2 | | | | | | | | |
| | 2+00 | 201.0 | 189.63 | 11.4 | | | | | | | | | |
| | 3+00 | 202.5 | 190.03 | 12.5 | | | 2+56.2 | | 22694 | | 2589 wilderness | | 2-10-89 |
| | 4+00 | 203.4 | 190.43 | 13.0 | | | 3+90.4 TAP | | 22695 | | 2585 wilderness | | 3-10-89 |
| | 5+00 | 203.2 | 190.83 | 12.4 | | | | | | | | | |
| | | 203.7 | 191.18 | 12.5 | 0+00 L-5 5+85.4 | | | | | | | | |
| | 6+00 | 203.4 | 191.23 | 12.2 | | | | | | | | | |
| | | 204.1 | 191.36 | 12.7 | 6+30.5 | | | | | | | | |
| | 7+00 | 203.2 | 191.63 | 11.6 | | | | | | | | | |
| | 8+00 | 201.3 | 192.03 | 9.3 | | | 7+65.9 TAP | | 24944 | | 2544 wilderness | | 3-16-90 |
| | | 201.3 | 192.24 OUT 192.44 IN | 9.1 | 8+50.9 | | | | 21199-7 | | 2548 wilderness | | 12-26-96 |
| | 9+00 | 200.7 | 192.63 | 8.1 | | | | | | | | | |
| | | 200.9 | 192.90 OUT 193.10 IN | 8.0 | 9+65.8 | | | | | | | | |
| | 10+00 | 200.5 | 193.44 | 7.1 | | | | | | | | | |
| | 11+00 | 201.5 | 194.44 | 7.1 | | | | | | | | | |
| | 12+00 | 202.6 | 195.44 | 7.2 | | | | | | | | | |
| | 13+00 | 203.7 | 196.44 | 7.3 | | | | | 2602- 62807 | | 2606 N wilderness | | 10-14-02 |
| LINE 4 | 0+00 | 196.04 | 185.42 | 10.6 | 13+20.6 EXIST 0+00 | 4" sch 40 | 4" stub NW | 92-23803-7 | | | 2613 wilderness | | 8-20-92 |
| | | 196.7 | 186.50 | 10.2 | 0+98.5 | | | | | | 2543 wilderness | | 1-31-91 |
| | 1+00 | | | | | | | | | | | | |
| | 2+00 | 197.8 | 187.62 | 10.2 | | | 1+98 | | 23473 | | 2547 wilderness | | 7-5-89 |
| | 3+00 | 198.0 | 188.72 | 9.3 | | | 4" sch 40 3+41.8 TAP | | 92-23784-7 | | 2551 wilderness | | 8-20-92 |
| LINE 5 | 0+00 | 200.1 | 189.77 | 10.3 | 3+95.8 5+85.4 C-3 0+00 | | 8" stub N | | | | | | |
| | 1+00 | 204.5 | 192.58 | 11.9 | | | 0+51.0 | | 26970 | | 2591 wilderness | | 1-31-91 |
| | 2+00 | 205.5 | 192.98 | 12.5 | | | | | | | | | |
| | | 206.8 | 193.32 | 13.5 | 2+83.9 | | | | 92-44134-7 | | 2527 wilderness | | 12-3-92 |
| | 3+00 | 206.4 | 193.53 | 12.9 | | | | | | | | | |
| | 4+00 | 205.8 | 194.83 | 11.0 | | | 4" sch 40 3+71.5 | | 98-11 | 954867 | 2601 wilderness | 2605 wilderness | 2-31-97 |
| | 5+00 | 205.3 | 196.13 | 9.2 | | | 4" sch 40 4+93.8 | | 93-138-7 | | 2609 wilderness | 2613 wilderness | 1-5-93 |
| | | 205.6 | 196.89 | 8.7 | 5+58.8 | | 4" sch 35 4" stub NE | | 91-27397-7 | | 2564 wilderness | | 7-5-89 |
| | | | | | | | | | | | | | |