



21st St. No.

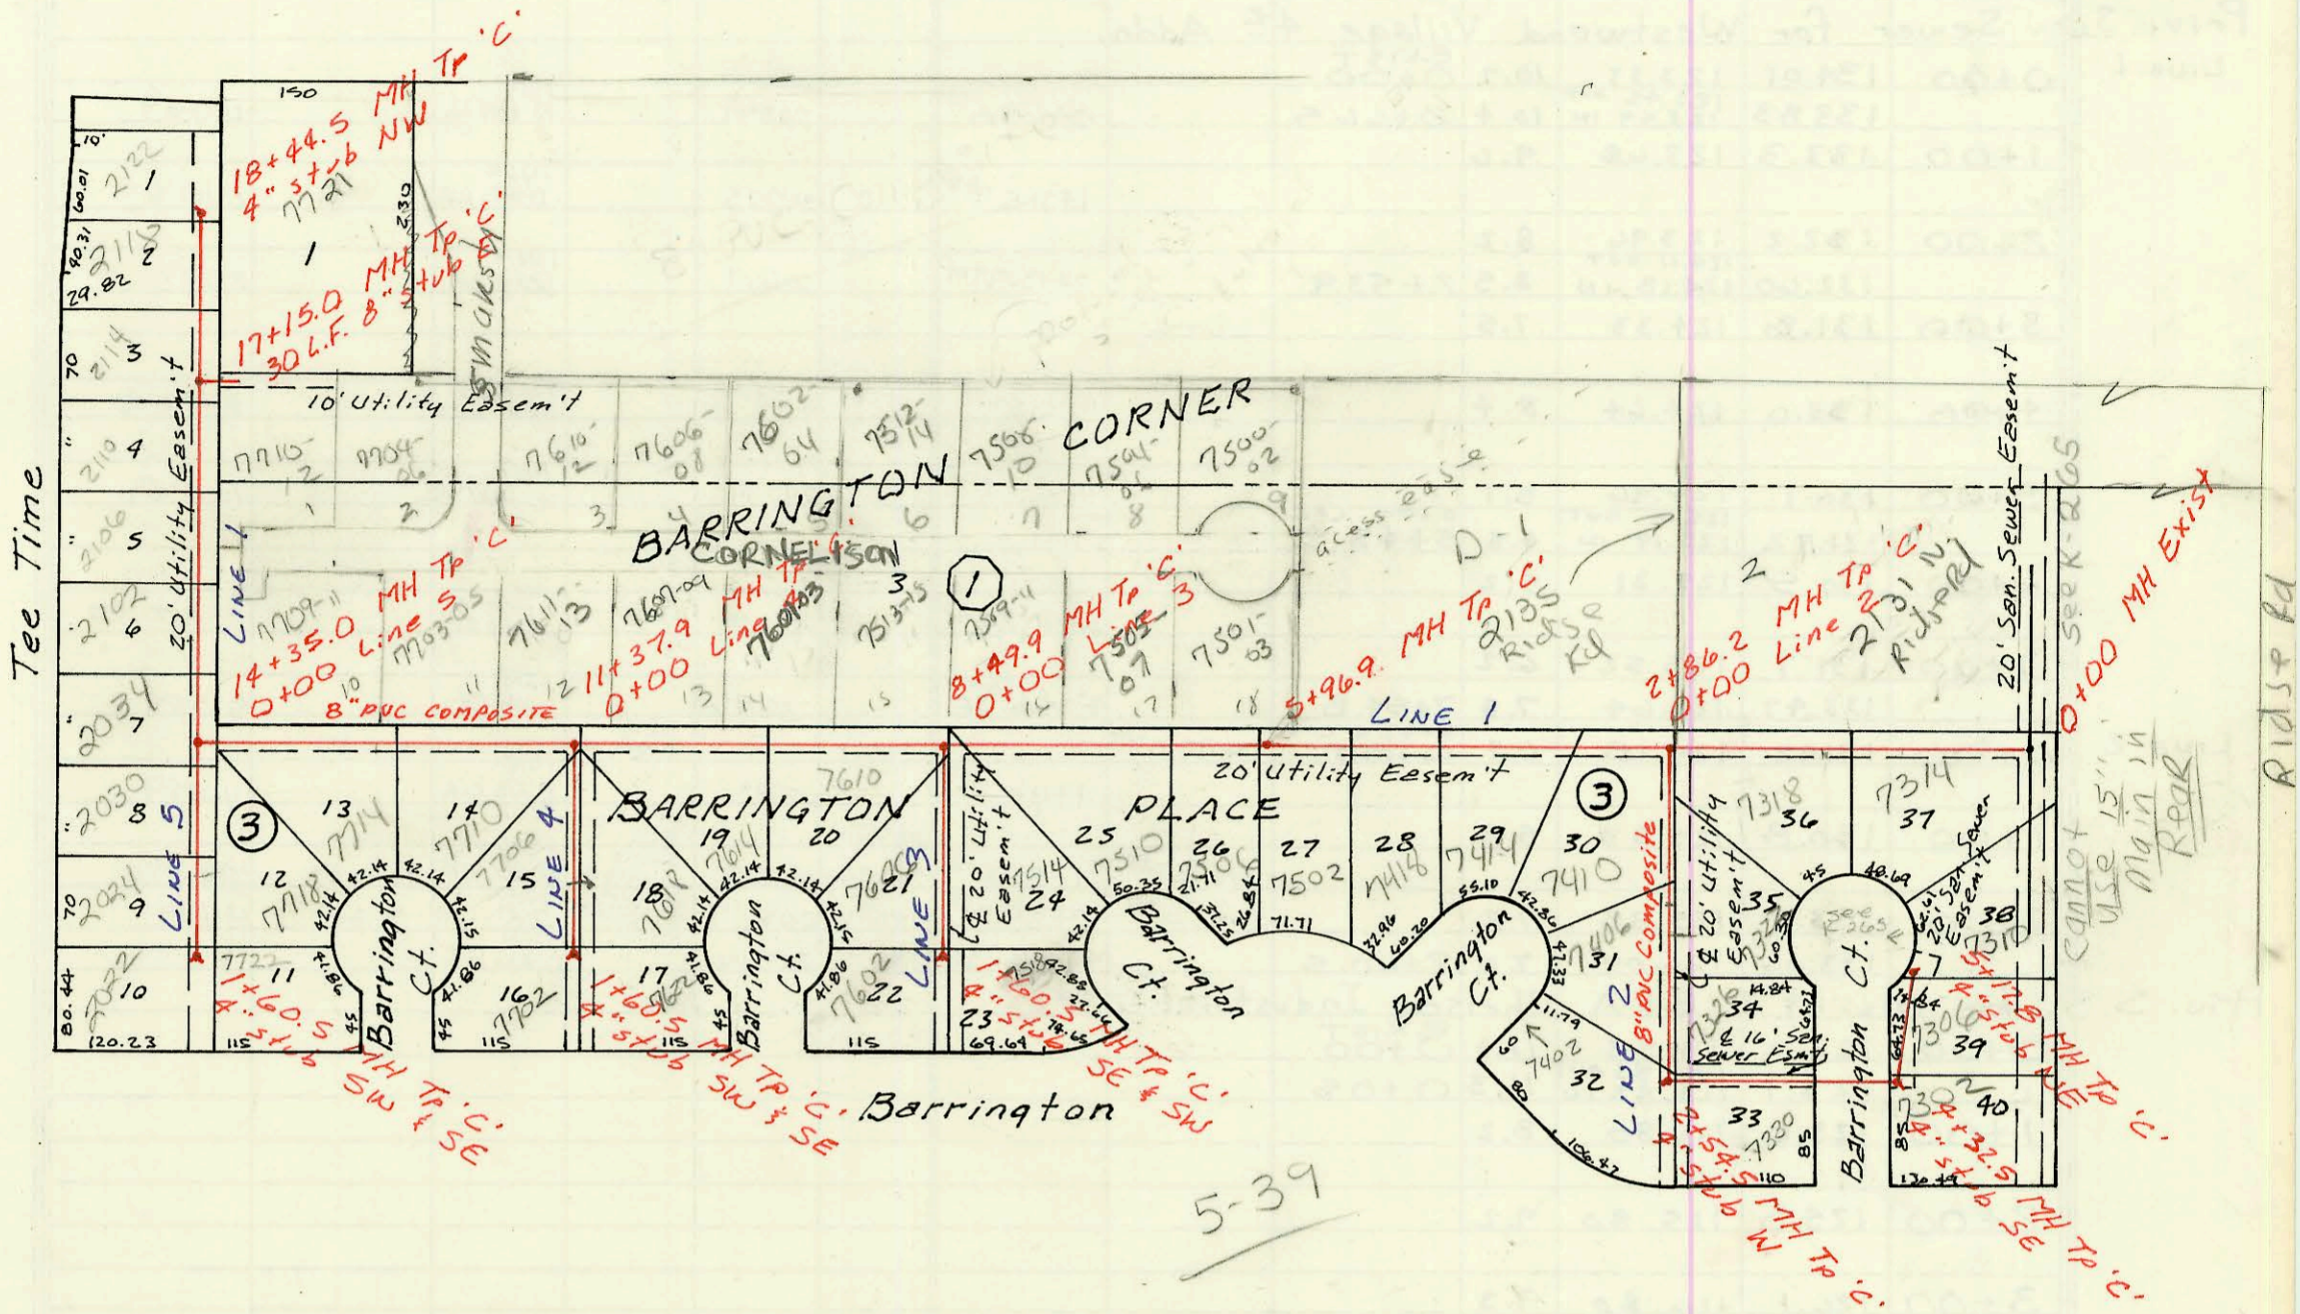

5-39

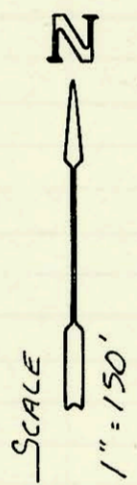

8 composite
 LAT 9, MAIN 15, SWI
 468-76-245-31847-000-001
 Built By MID-STATES CONST.
 Booked 3-3-89 from Plan

Priv. Sanitary Sewer to serve
 part of Lot 4, Blk 6, Riverside 4th Adcn.
 468-76-245-80001-000-000-202
 Built By Stannard Const.
 Booked 3-4-88 from As Built

