



Priv. Sanitary Sewer for
Westwood Village 4th Addn.
468-76-245-80001-000-000-194
Built By Stannerd Const.
Booked 3-3-89 from As Built Plan

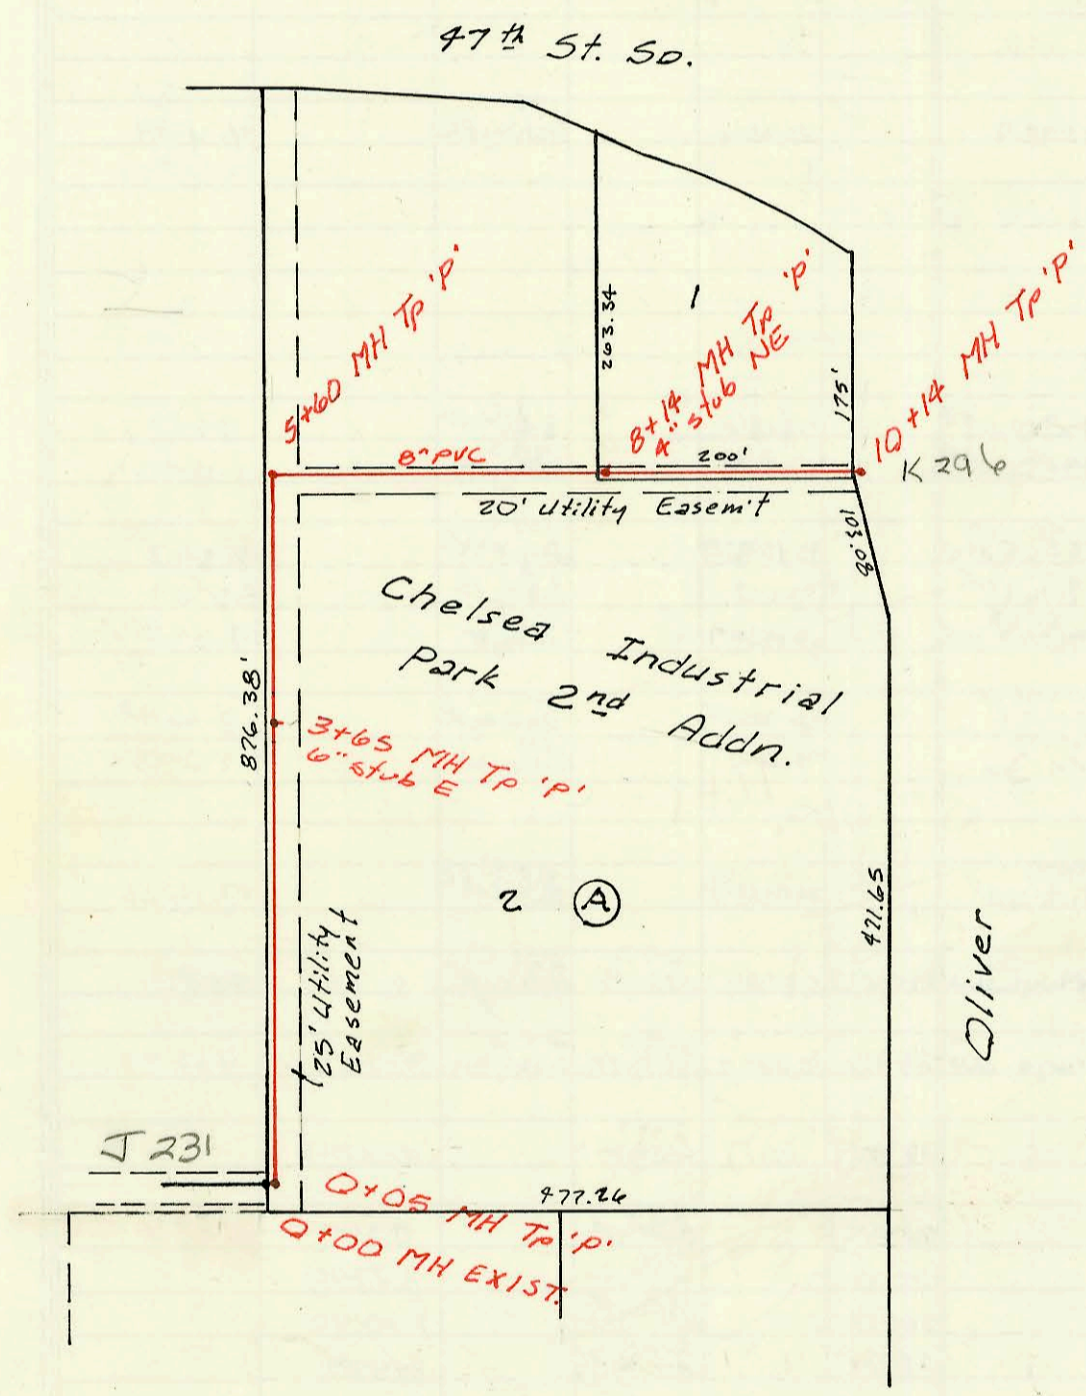

Wayne Biddle, Water Dept
was advised by Jim Webber,
County. That this sewer
connects to Oakland
Sewer. Direct any
inquiries to
County
2-28-95
BR

Priv. S.S. for lots 1 & 2, Bk A, Chelsea Industrial 2nd
468-76-245-80001-000-000-184
Built By Mid-States Const.
Booked 3-29-89 from As Built.

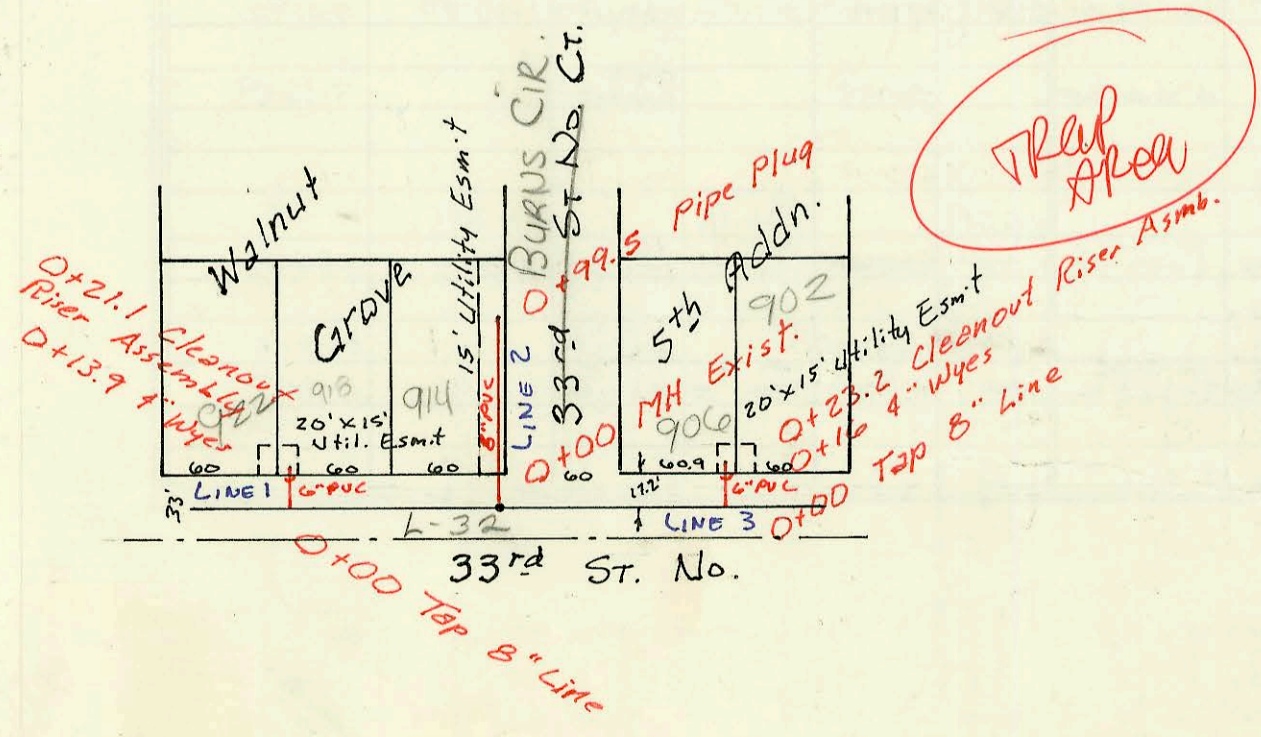

Priv. S.S. for lots 1-5, Walnut Grove 5th Addn.
468-76-245-80001-000-000-197
Built By Wildcat Const. Co.
Booked 3-29-89 from As Built Plan

CONSTRUCTION RECORD							SERVICE RECORD					
STATION	ELEVATION		Depth	MANHOLE	4-INCH "Y" BRANCHES		No. of Permit		House Number		DATE OF PERMITS	
	Ground	Grade			North West	South East	North West	South East	North West	South East	North West	South East
Priv. San. Sewer for Westwood Village 4 th Addn.												
LINE 1	0+00	134.01	123.33	10.7	EXIST							
		133.83	123.45 ^{OUT} 123.59 ^{IN}	10.4	0+66.5	0+60.5 TAP		22849		1413 N Doris Cir		4-1-89
	1+00	133.3	123.68	9.6		1+31.5 TAP		24095		1424 DORIS CIR		10/10/89
	2+00	132.2	123.96	8.2								
		132.60	124.11 ^{OUT} 124.18 ^{IN}	8.5	2+53.9	3+13.9 TAP		23664		1426 DORIS CIR		8-3-89
	3+00	131.8	124.33	7.5								
	4+00	133.0	124.64	8.4		4+12.5 TAP		25013		421 DORIS CIR		3-29-90
	5+00	130.1	124.96	5.1		4+86.5 TAP		24074		1417 N. Doris Cir		10-10-89
		131.92	125.10 ^{OUT} 125.19 ^{IN}	6.8	5+43.5							
	6+00	130.5	125.31	5.2		6+61.8 TAP		25012		5214 W. 13th Ct		3-29-90
	7+00	131.7	125.52	6.2								
		133.47	125.64	7.8	7+54.8	4" stub SE		23676		5218 13th Ct		8-3-89
LINE 2	0+00	131.92	125.18	6.7	EXIST 5+43.5 L-1 0+00	0+79.0 TAP		24073		5210 W 13th Ct		10-10-89
	1+00	130.8	125.53	5.3		1+11.0 TAP		22848		1413 DORIS CIR		4-1-89
	2+00	133.7	125.88	7.8		1+61.5 TAP 2+16.5 TAP		24072	23860	5206 W 13th Ct 5202 W 13th Ct	1404 DORIS CIR	10-10-89 9-11-89
		133.06	126.09	7.0	2+60.5	4" stub SE		22846		1405 DORIS CIR		8-3-89 4-1-89
Priv. S.S. for lots 1 & 2, Blk A, Chelsea Industrial 2 nd												
	0+00	123.2	111.83	11.4	EXIST							
		123.1	111.85 ^{OUT} 113.85 ^{IN}	11.3	0+05							
	1+00	123.0	114.80	8.2								
	2+00	125.0	115.80	9.2								
	3+00	126.1	116.80	9.3								
		126.8	117.45	9.3	3+65	6" stub E						
	4+00	127.0	117.80	9.2								
	5+00	127.6	118.80	8.8								
		128.7	119.40 ^{OUT} 119.50 ^{IN}	9.3	5+60							
	6+00	127.7	119.70	8.0								
	7+00	126.6	120.20	6.4								
	8+00	126.2	120.70	5.5								
		126.4	120.75	5.6	8+14	4" stub NE						
	9+00	126.1	121.20	4.9								
	10+00	128.8	121.70	7.1								
		129.0	121.75	7.2	10+14							
Priv. S.S. for lots 1-5, Walnut Grove 5 th Addn.												
LINE 1	0+00	131.9	124.63	7.3								
	0+13.9		124.77	7.3		W. Wye		25325	25992	922 W 33rd St	918 W 33rd St	5-16-90 8-21-90
	0+21.1	132.11										
LINE 2	0+00	131.63	124.19	7.4	EXIST	0+58.0 TAP		25324		914 W 33rd St		5-16-90
	0+99.5	131.0	124.68	6.3								
LINE 3	0+00	132.4	124.55	7.9								
	0+16.0		124.75	7.7		W. Wye		24398	22977	906 W 33rd St	902 W 33rd St	12-1-89 3-24-89
	0+23.2	132.42										
LAT 46, Line 5												
	MAIN 4, SW I (CONT.)					4" SDR 35 4+02.5 tap		21081-7	2026	113 N Ashley Pl	7612 Douglas 11610 W Douglas	4-25-91 2-4-92
	4+00	144.0	135.28	8.7		4+38.5 tap		25897				8-2-90
		144.4	135.41	9.0	4+44.5	4" stub SW						
LINE 6	0+00	144.35	135.30	9.1	0+00							
	1+00	144.5	135.70	8.8		4" SDR 35 4+41.1		24498-7	24885	7601 O'Neil	141 Ashley Pl	4-5-94 3-2-90
	2+00	145.2	136.10	9.1		4" SDR 35 4+41.1		2000 0121	93 3171-7	7605 O'Neil	1371 Ashley Pl	5-4-90 12-21-93
	3+00	146.0	136.50	9.5		4" SCH 40 3+84.6		21268-7	2000 00598	7609 O'Neil	133 N Ashley Pl	12-1-97 3-3-00
		146.30	136.66	9.6	3+40.8	8" stub N		2001 00549	93 4147-7	1163 O'Neil	109 N Ashley Pl	2-25-93 5-25-92
	4+00	146.4	136.90	9.5		4" SDR 35 3+64.8 saddle		2001 00549	92-7623-7	1163 O'Neil	105 N Ashley Pl	3-14-94 5-25-92
		146.60	137.07	9.5	4+44.1	4" stub NW		2001 00549		1163 O'Neil		6-19-97