

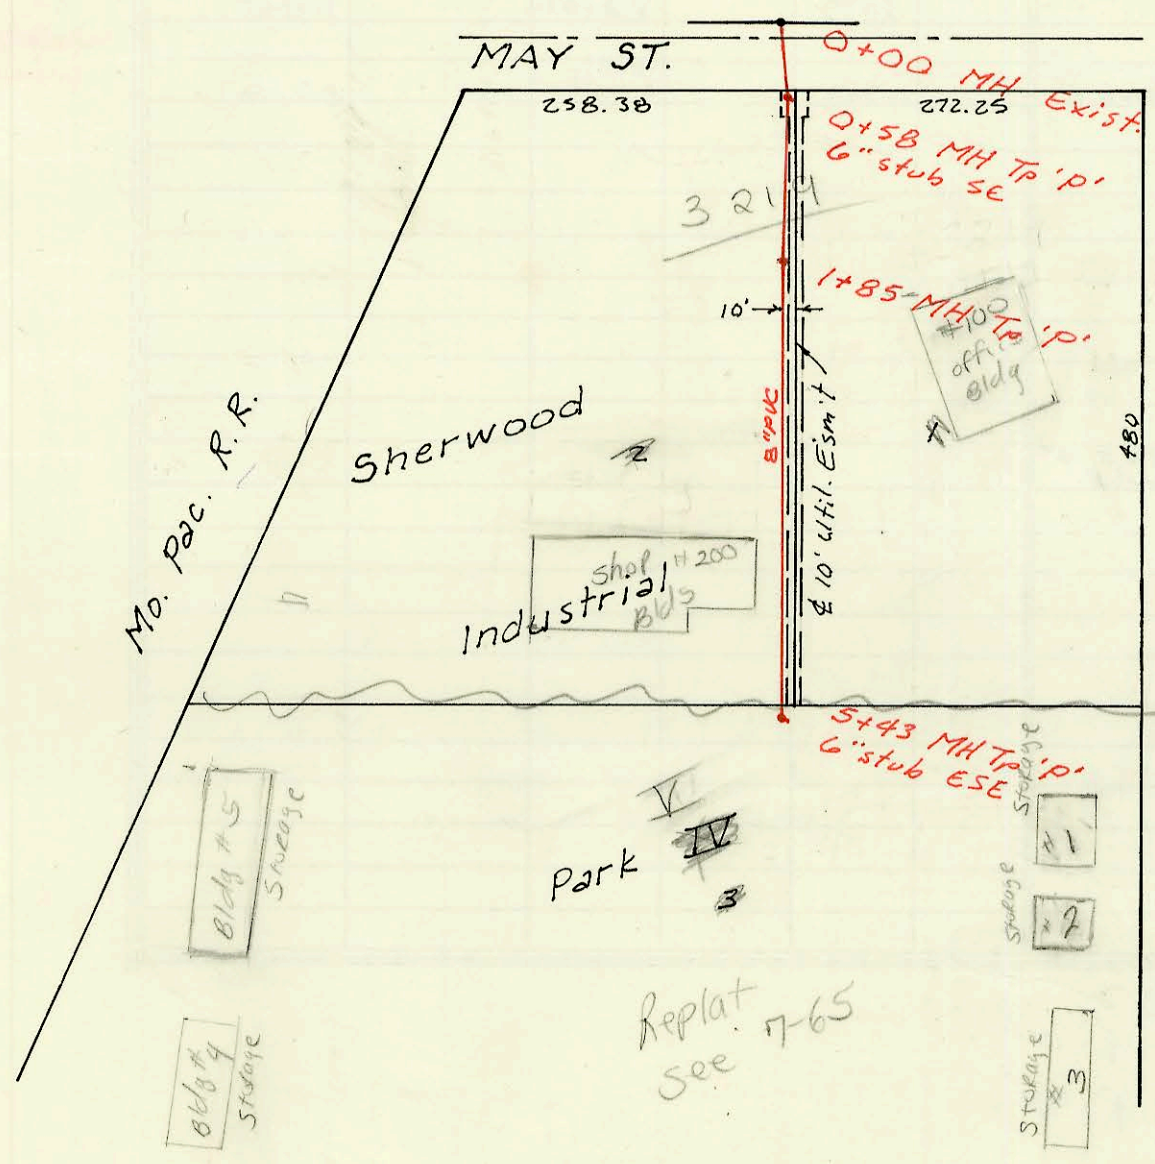
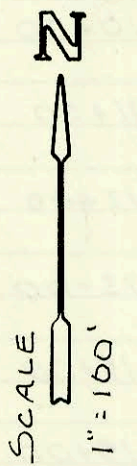


LAT 63, SAN. SEWER # 23
 468-76-245-81762-000-000-001
 Built By Stannard Const
 Booked 3-27-89 from Plan #

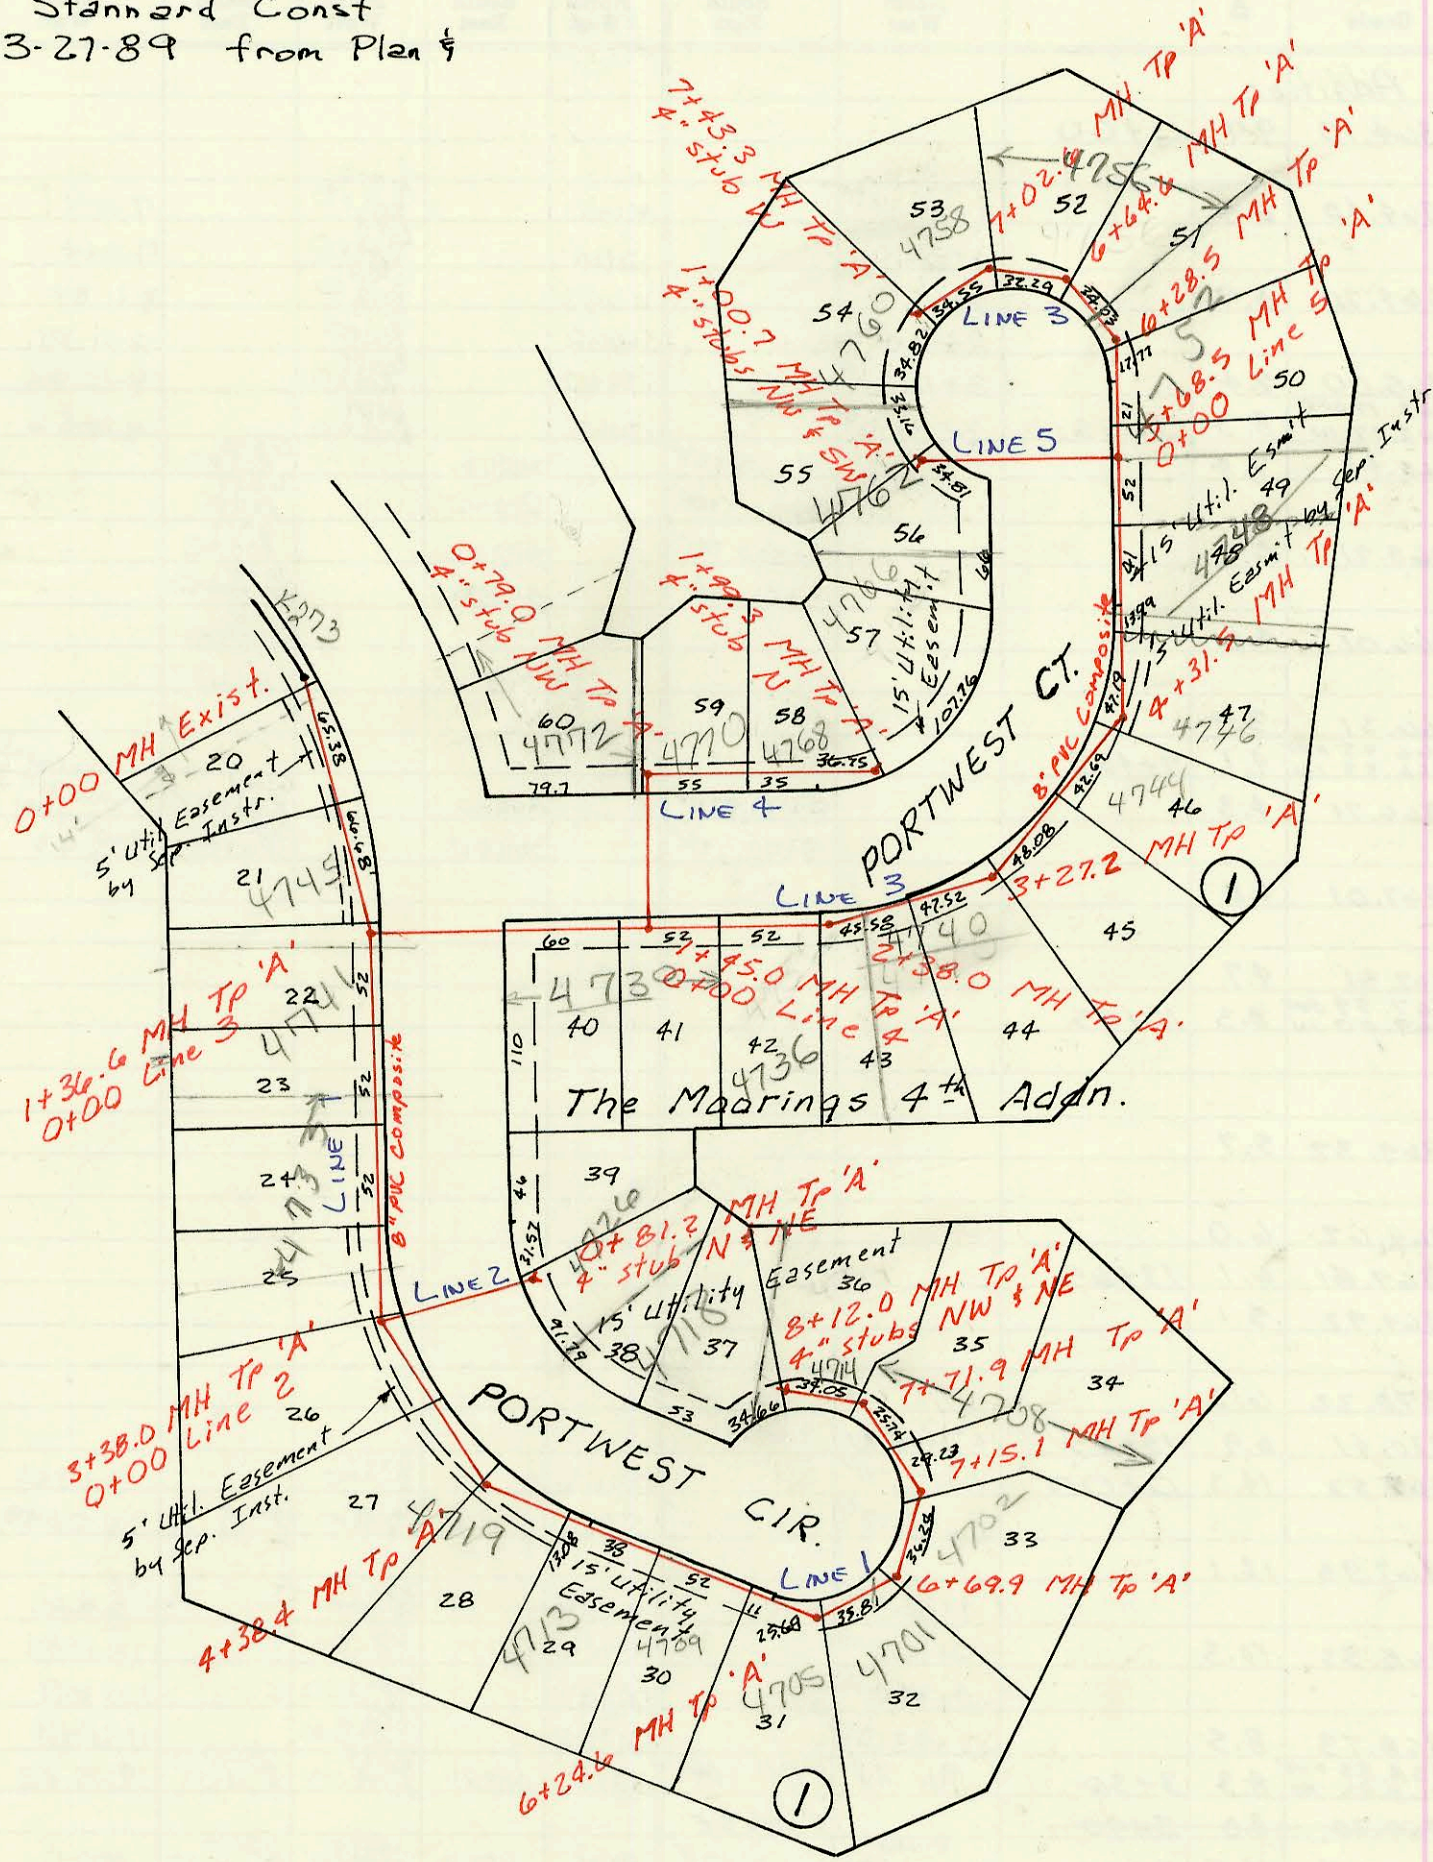

Priv. San. Sewer to serve Lots 1, 2 & 3
 Sherwood Industrial Park IV
 468-76-245-80001-000-000-186
 Built By Wildcat Const.
 Booked 3-30-89 from As Built Plan

Line south from MH 0+58 is a private ss. line and is not to be maintained by the city.
 For Paul Woodcuff, Sewer Maint.
 4/6/89
 (SK)

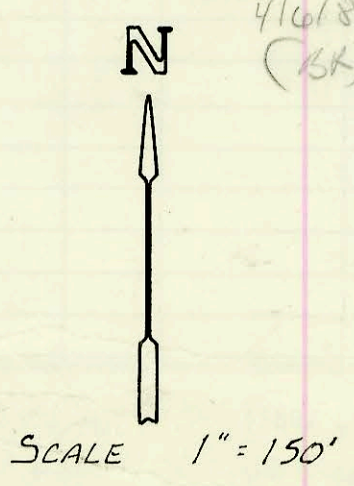

CONSTRUCTION RECORD

SERVICE RECORD

LAT 63
LINE 1

LINE 2

LINE 3

LINE 4

LINE 5

Priv. San. Sewer to serve lots 1, 2 & 3, Sherwood Industrial Park IV

STATION	ELEVATION		Depth	MANHOLE	4-INCH "Y" BRANCHES		No. of Permit		House Number		DATE OF PERMITS	
	Ground	Grade			North West	South East	North West	South East	North West	South East	North West	South East
0+00	143.70	137.64	6.1	EXIST 0+00								
1+00	143.6	137.94	5.7									
2+00	143.5	138.34	5.2									
3+00	143.5	138.64	4.9									
4+00	143.9	139.04	4.9									
5+00	144.3	139.44	4.9									
6+00	144.6	139.74	4.9									
7+00	145.0	140.31	4.7									
8+00	145.0	140.91	4.1									
0+00	144.50	138.85	5.7	8+12.0	4" stub NW	4" stub NE	2245					
0+00	143.90	138.15	5.8	0+00	4" stub W	4" stub NE	27009					
1+00	143.9	138.45	5.5									
2+00	144.2	138.75	5.5									
3+00	144.5	139.15	5.4									
4+00	144.9	139.55	5.4									
5+00	145.1	139.95	5.2									
6+00	145.5	140.39	5.1									
7+00	146.15	140.99	5.2									
0+00	144.45	138.69	5.8									
1+00	144.2	139.19	5.0									
0+00	145.55	140.26	5.3									
1+00	146.10	140.66	5.4									
0+00	107.4	97.05	10.4	EXIST 0+00								
1+00	108.5	97.28	11.2	0+58								
2+00	109.1	97.85	11.3									
3+00	111.5	98.25	13.3									
4+00	110.7	98.65	12.1									
5+00	110.4	99.05	11.4									
	110.05	99.29	10.8	5+43.								