


LAT. 2, SUB. 19, S. S. NO. 22
 W. B. CARTER CONST. CO. INC.
 MAY 1965, PROJ. NO. C24-12
 BK. NO. K-81

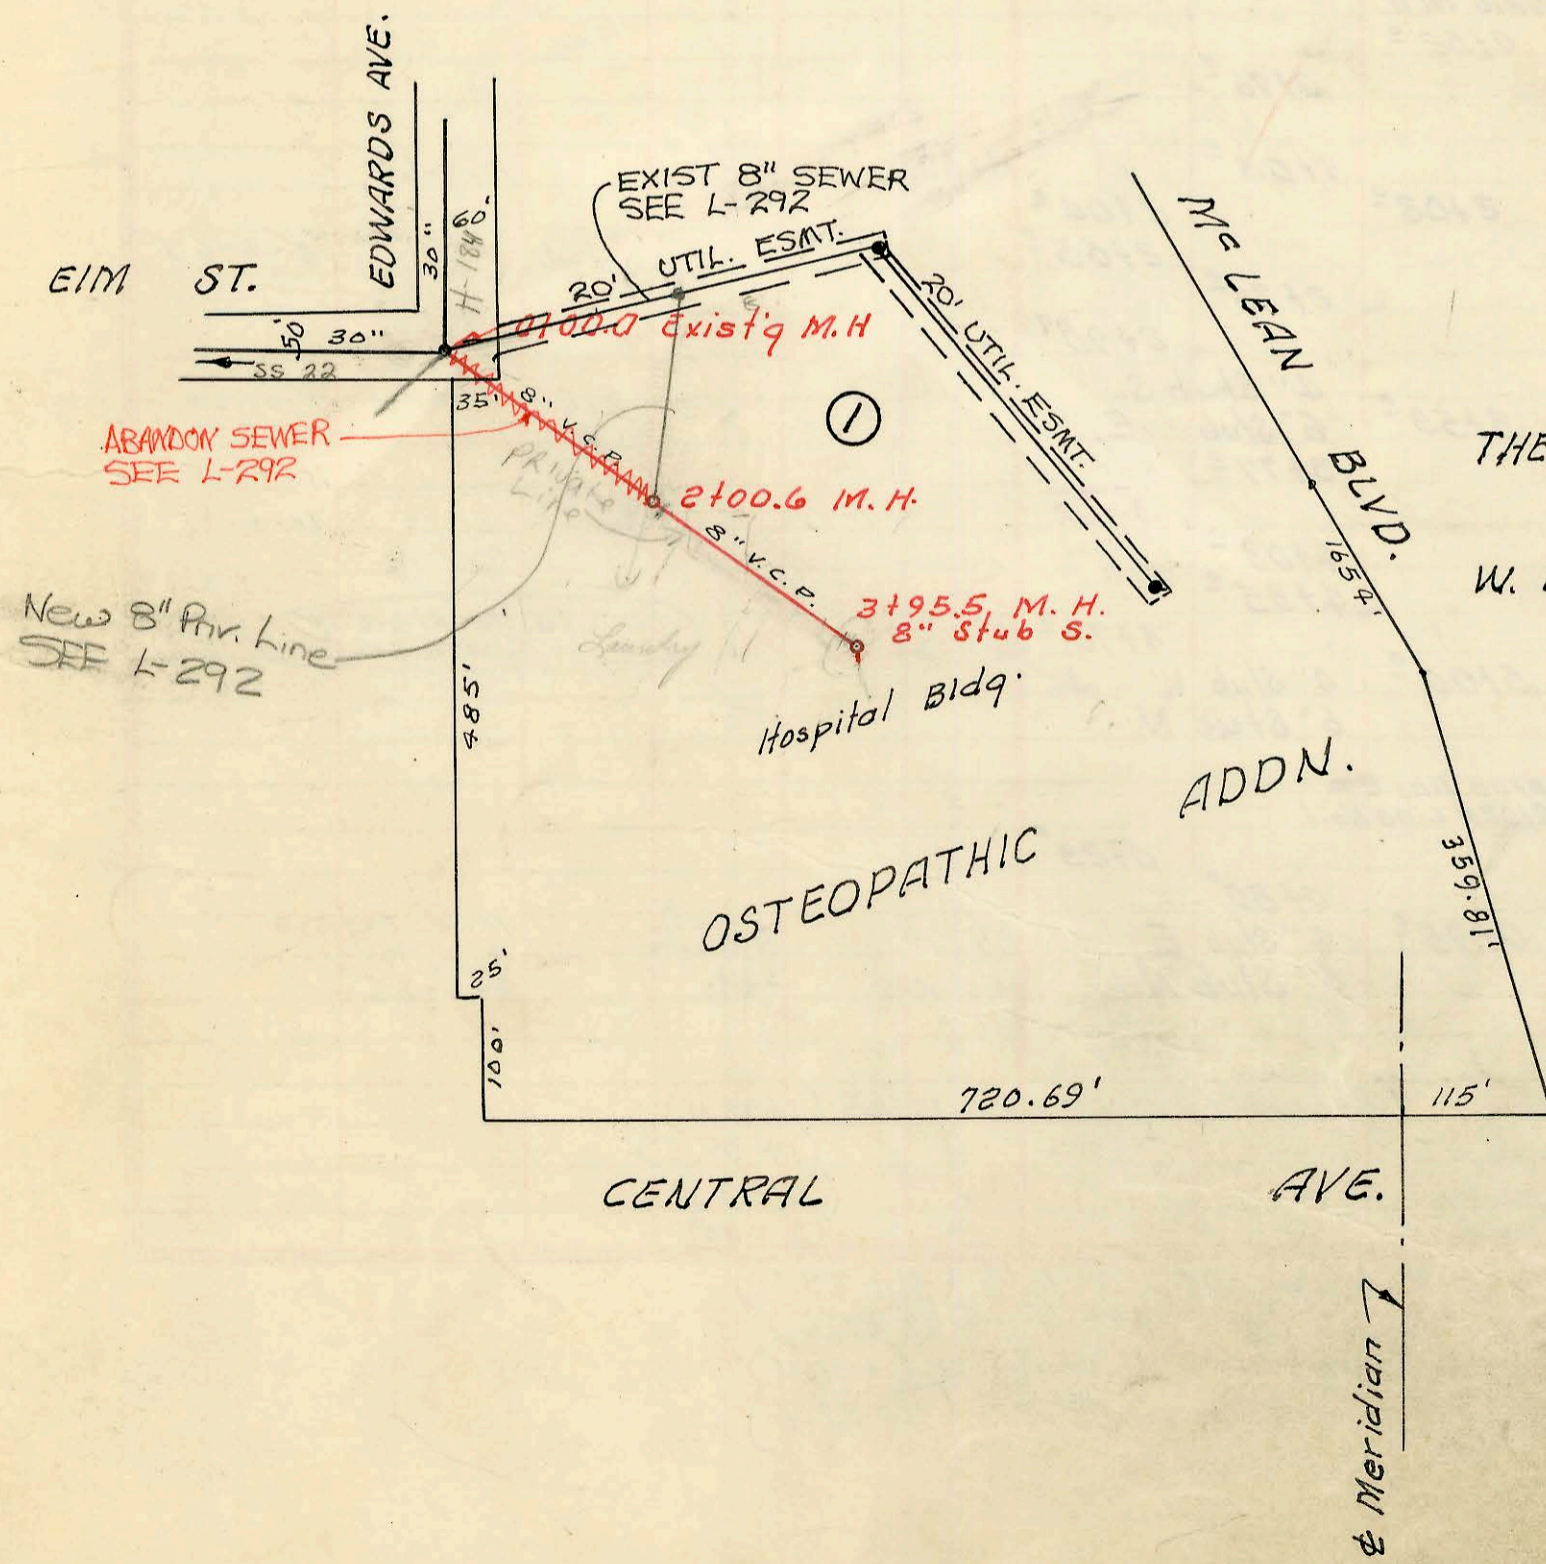

THE OSTEOPATHIC HOSPITAL OF WICHITA
 PRIVATE SANITARY SEWER
 W. B. CARTER, DEC. 1965
 BK. NO. K-86

plot 7-48
 SE 1/4 13-27-1W
 Connect MHT to

CONSTRUCTION RECORD

SERVICE RECORD

STATION	ELEVATION		Depth	MANHOLE	4-INCH "Y" BRANCHES		No. of Permit		House Number		DATE OF PERMITS	
	Ground	Grade			North West	South East	North West	South East	North West	South East	North West	South East
0+00	125.6	117.30	8.3	0+00.0 Exist'g M.H.								
1+00	125.4	117.50	7.9									
2+00	125.9	117.66	8.2	1+80 [±]								
	125.8	117.70	8.1		2+57 [±]			C6125	28027	River Park Dr.	12-13-67	
					2+109 [±]							
					2+81 [±]							
3+00	124.9	117.90	7.0									
	124.8	117.97 ^{out} 118.09 ⁱⁿ	6.8 6.7	3+41 [±]								
4+00	125.2	118.21	7.0		3+76 [±]	3+78 [±]		C2539	2810	River Park Dr.	4-1-67	
						4+13 [±]		B6013	2818	River Park	7-15-66	
						4+73 [±]		C8170	2817	Cornelison	5-6-68	
5+00	125.5	118.41	7.1		5+55 [±]	5+57 [±]		C1394	2901	Cornelison	3-20-68	
	125.6	118.57	7.0	5+77 [±]				B5048	2902	River Park Dr.		
6+00	125.6	118.61	7.0		6+38 [±]	6+40 [±]		C3282	2907	Cornelison	7-11-67	11-8-65
						7+23 [±]		B5376	2919	Cornelison	3-31-66	
						7+29 [±]		B4029	2920	River Park		8-26-65
						7+46 [±]						
8+00	125.9	119.01	6.9	7+94 [±]								
					8+48 [±]	8+21 [±]		B4588	2930	River Park		11-19-65
9+00	126.1	119.21	6.9	top 8+90 [±]				C30894	2928	Cornelison	3-9-72	
					9+10 [±]	9+10 [±]		B5108	2940	River Park		2-17-66
					9+67 [±]	9+69 [±]						
	125.9	119.38 ^{out} 119.48 ⁱⁿ	6.5 6.4	9+82 [±]	4" stub SW			#3474	2950	River Pk. Dr.		
10+00	126.1	119.55	6.5		10+10 [±]			#3472	3029 3229	Cornelison	5-25-65	
					10+43 [±]							
					10+90 [±]							
11+00	127.0	119.95	7.0		11+12 [±]	11+07		C6576	2939	Cornelison	4-20-66	1-22-68
					11+85 [±]	11+83 [±]		B5479	3019	Cornelison	4-20-66	
	127.8	120.35	7.4	11+95 [±]				B5478	3001	Cornelison	4-20-66	9-16-68
0+00	125.0	118.10	6.9	0+00 = 3+41.9 Line No. 1								
1+00	125.1	118.30	6.8		0+31 [±]	0+29 [±]						
					top 0+68 [±]			C46933	2809	Cornelison	6-24-69	10-4-74
	127.8	118.46	9.3	1+82 [±]	8" stub N.			C4617	2809	Cornelison	6-24-69	6-4-70
0+00	96.1	88.00	8.1	0+00 [±] Exist'g MH								
1+00	96.8	89.40	7.4									
2+00	97.1	90.80	6.3	2+00 [±]				C19466	(addr.) 2622 W. Central		5-26-70	
					2+77 [±]			C13442	2622 W. Central		4-8-69	
3+00	97.2	92.20	5.0		3+51 [±]			C13441	2622 W. Central		4-8-69	
	97.7	93.53	4.2	3+95 [±]	8" stub So.							

LINE NO. 1

LINE NO. 2

THE OSTEOPATHIC HOSPITAL OF WICHITA
PRIVATE SAN. SEWER

C41226 - 2622 W. Central - Jim Dealby - 9-14-73 (Osteop. Hospital) going into existing line for laundry
 91-35911-7 10/23/71 2622 W. Central - 6" SDR 35 - MH tap on private line (27006)
 91-35917-7 10/23/71 " " " " 4" SDR 35 MH tap on private line (37955) 92-28452-7 9-11-72 2622 W. Central
 26303 - 1422 W. Central - 6" SDR 35 MH TAP - N/C McCullough - 6" SDR 35 repl old
 Cast from along Bldg and
 Tied into exist'g 6" SDR 35