
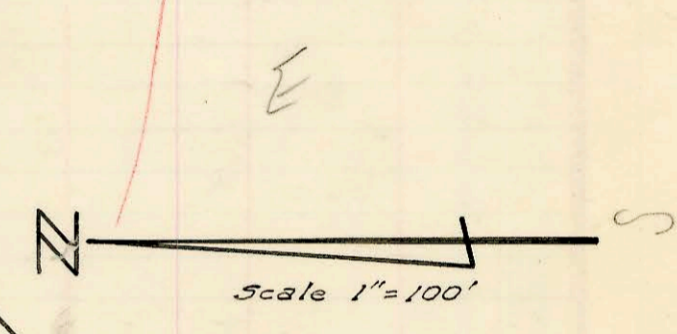


LATERAL 31, WAR INDUSTRIES SEWER
 W. B. CARTER CONSTRUCTION CO. INC., AUG 1965
 PROJ. NO. C25-12 BOOKED AUG 27, 1965 K-73

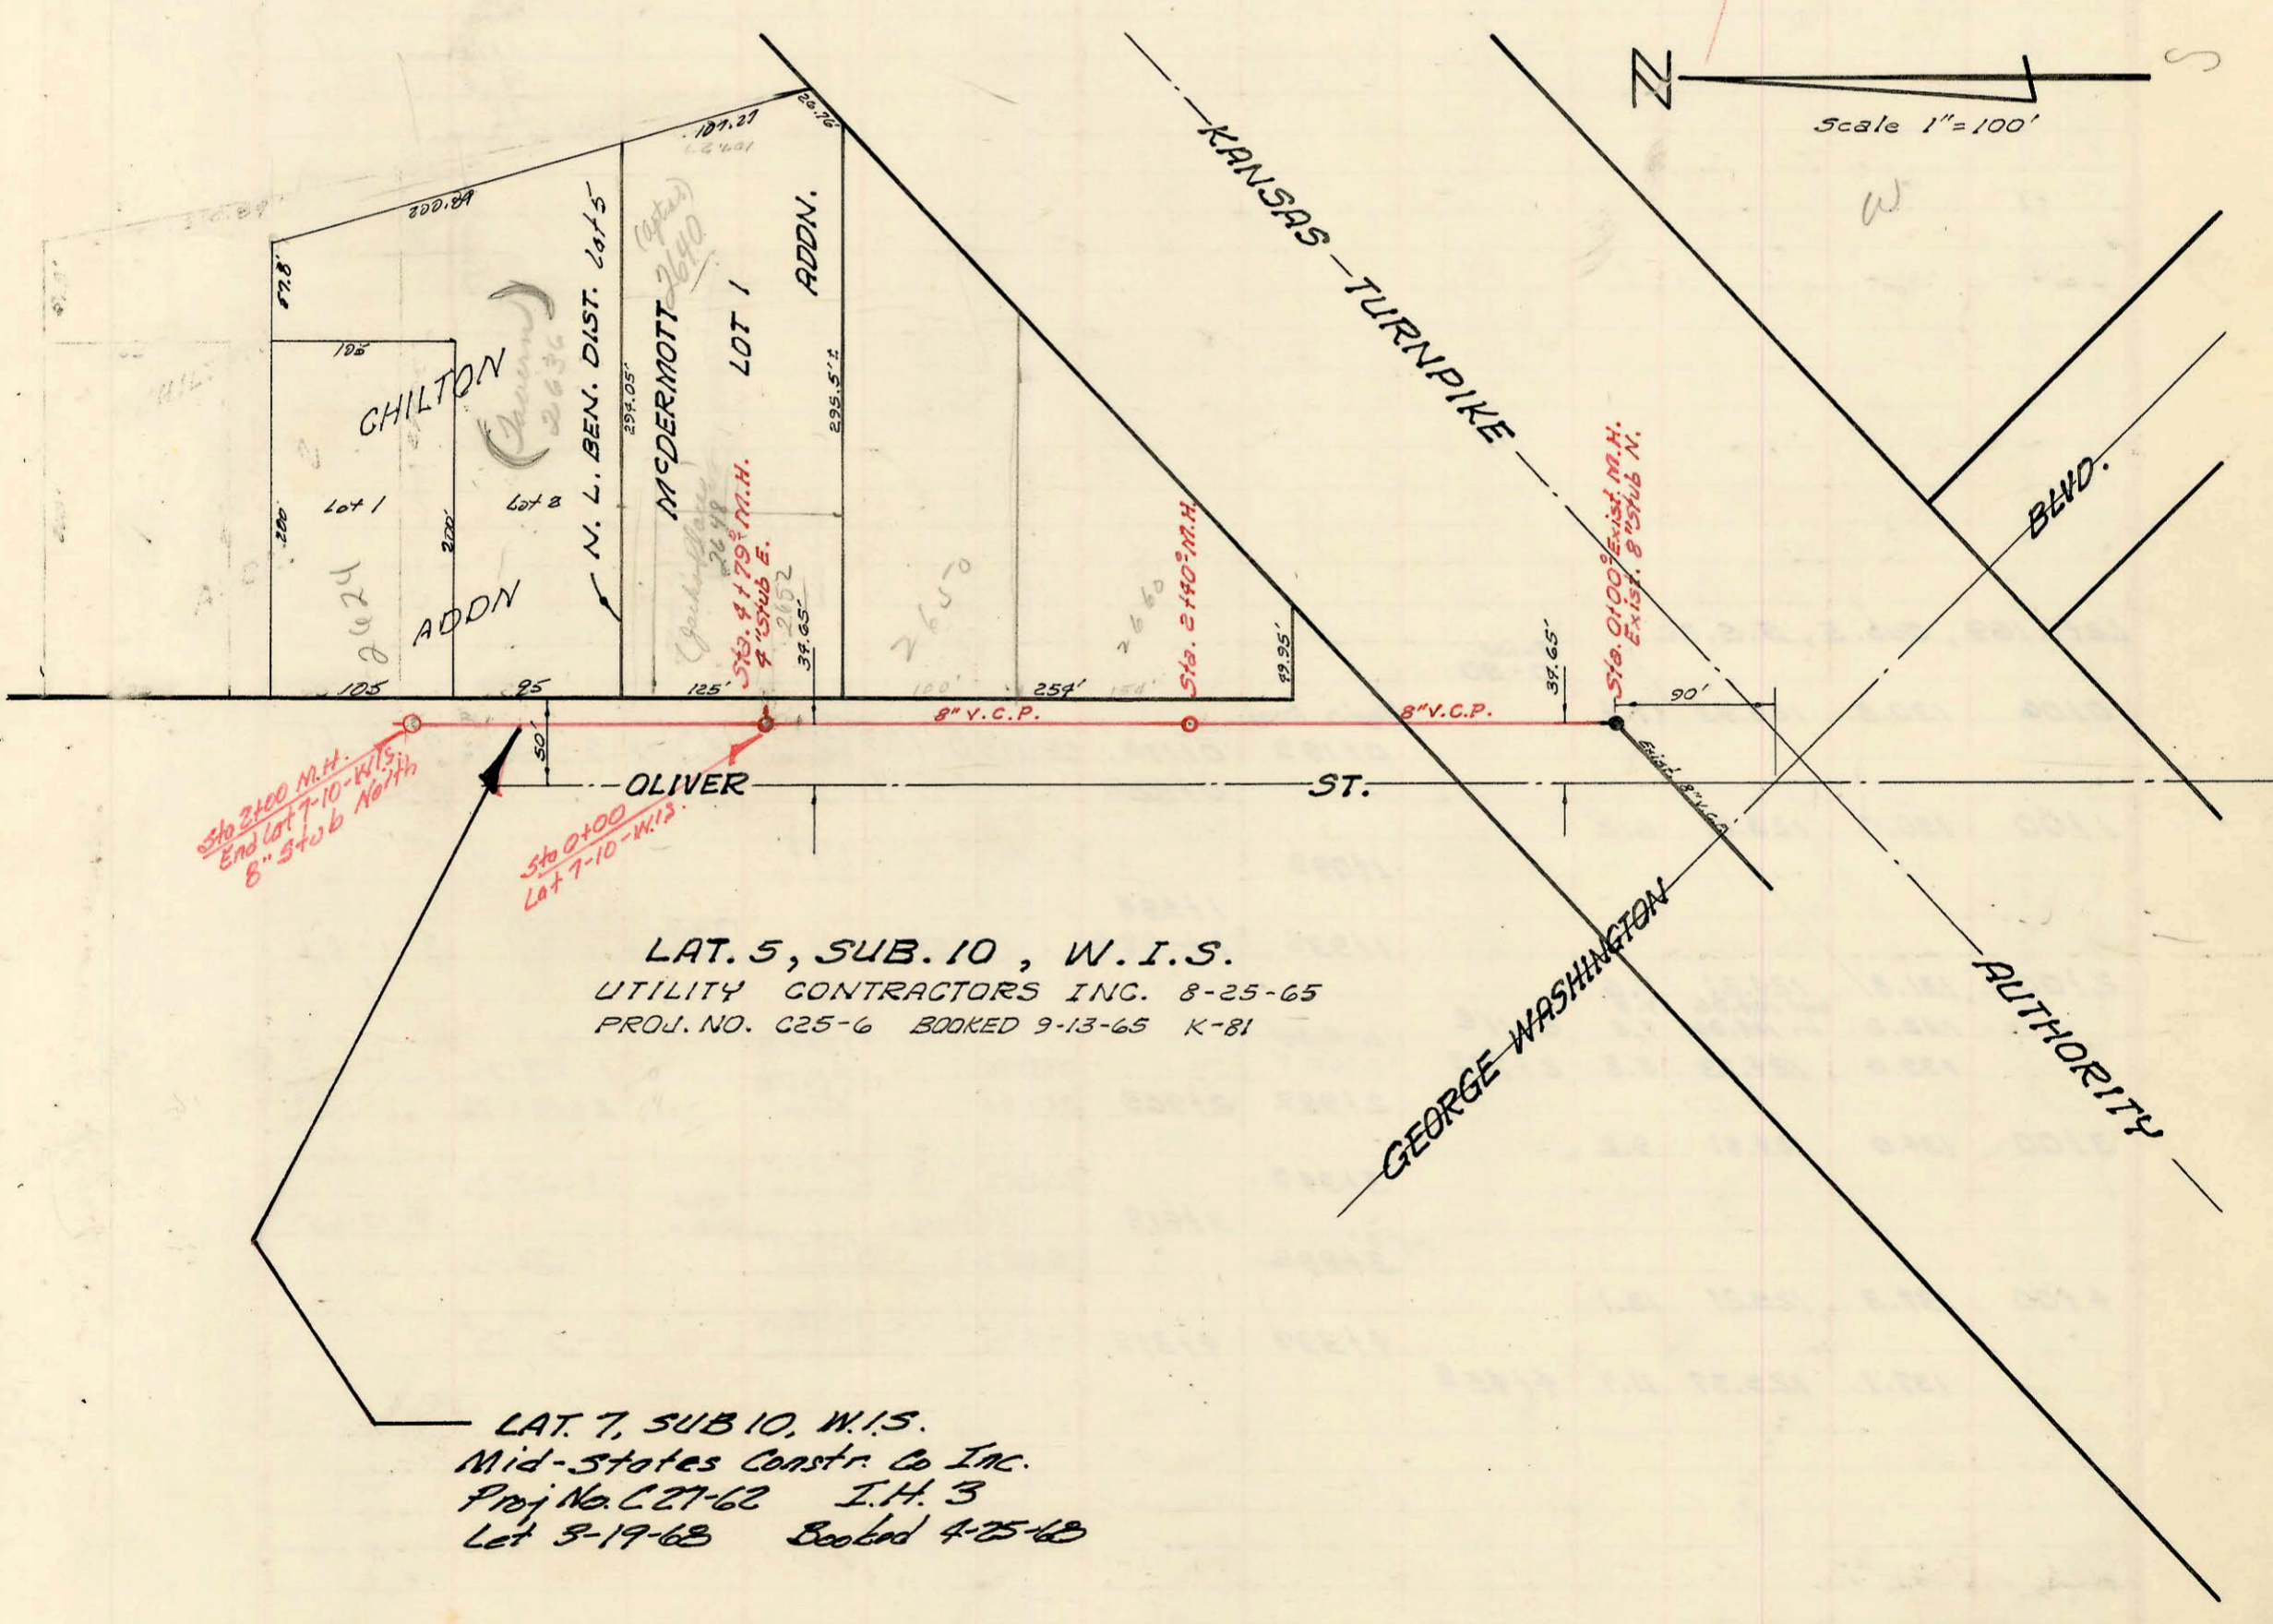

LAT. 5, SUB. 10, W.I.S.
 UTILITY CONTRACTORS INC. 8-25-65
 PROJ. NO. C25-6 BOOKED 9-13-65 K-81

LAT. 7, SUB 10, W.I.S.
 Mid-States Constr. Co Inc.
 Proj No C27-62 I.H. 3
 Let 9-19-68 Booked 4-25-68

CONSTRUCTION RECORD						SERVICE RECORD						
STATION	ELEVATION		Depth	MANHOLE	4-INCH "Y" BRANCHES		No. of Permit		House Number		DATE OF PERMITS	
	Ground	Grade			North West	South East	North West	South East	North West	South East	North West	South East
LAT. 31, W.I.S. 0+00	144.30	out 128.30 in 132.80	11.5		0+36 ^N	0+39 ^S						
1+00	145.20	133.30	11.9		1+28 ^N	1+59 ^E						
2+00	144.80	133.80	11.0		1+97 ^E		C2848	8407 Block Tree			4-26-67	
	144.50	134.20	10.3	2+80 ^N			20330213 ⁶ C18760	8430 ^E S.D.O. E. Kellogg			8-14-65 4-18-70	
3+00	144.90	134.30	10.1		3+05 ^E							
					3+18 ^N		# 83373 9617807 #C14965	3415 Peach Tree Lane E. Kellogg			8-17-1965	5-23-61 7-16-69
4+00	145.30	134.80	10.5		4+02 ^N		# 83963	3421 Peach Tree Lane			8-13-1965	
	145.30	134.86	10.4	4+11 ^N								
Lat. 5, Sub. 10, W.I.S. 0+00	124.5	116.31	8.2	Exist. M.H. 0+00 ^N	Exist. 8" Stub N.							
1+00	125.5	116.81	8.7									
2+00	125.4	117.31	8.1									
	126.5	117.51	9.0	2+90 ^N		2+09 ^E	648039 C10982	2660 ^S Oliver			1-14-75 10-18-68	
3+00	127.1	117.81	9.3			2+81 ^N 3+70 ^E	646783 C11673	2650 ^S Oliver S.O.			9-23-74 11-22-68	
						3+32 ^E 3+90 ^E						
4+00	128.8	118.31	10.5			M.H. TAP 4+67 ^E	64374 C25713 # 9086	2640 ^S Oliver 2678 ^S Oliver			8-19-62 7-20-71 2-8-65	
	129.5	118.71	10.8	4+79 ^N	4" Stub East							
Lat. 7, Sub. 10, W.I.S. 1+10	131.0	119.82	11.2			0+43 ^E	4478	2640 ^S Oliver			10-19-63	
						1+21 ^N 1+88 ^N	92 292897 12198 C33363	2636 ^S Oliver			9-16-61 7/5/72	
	130.2	120.00	10.2	2+00	8" 46 N							
10730 - 2648 ^S Oliver - 4-18-84 - Wilfred Brake - 0+00 N (0+91 ^N)												