



Map Area

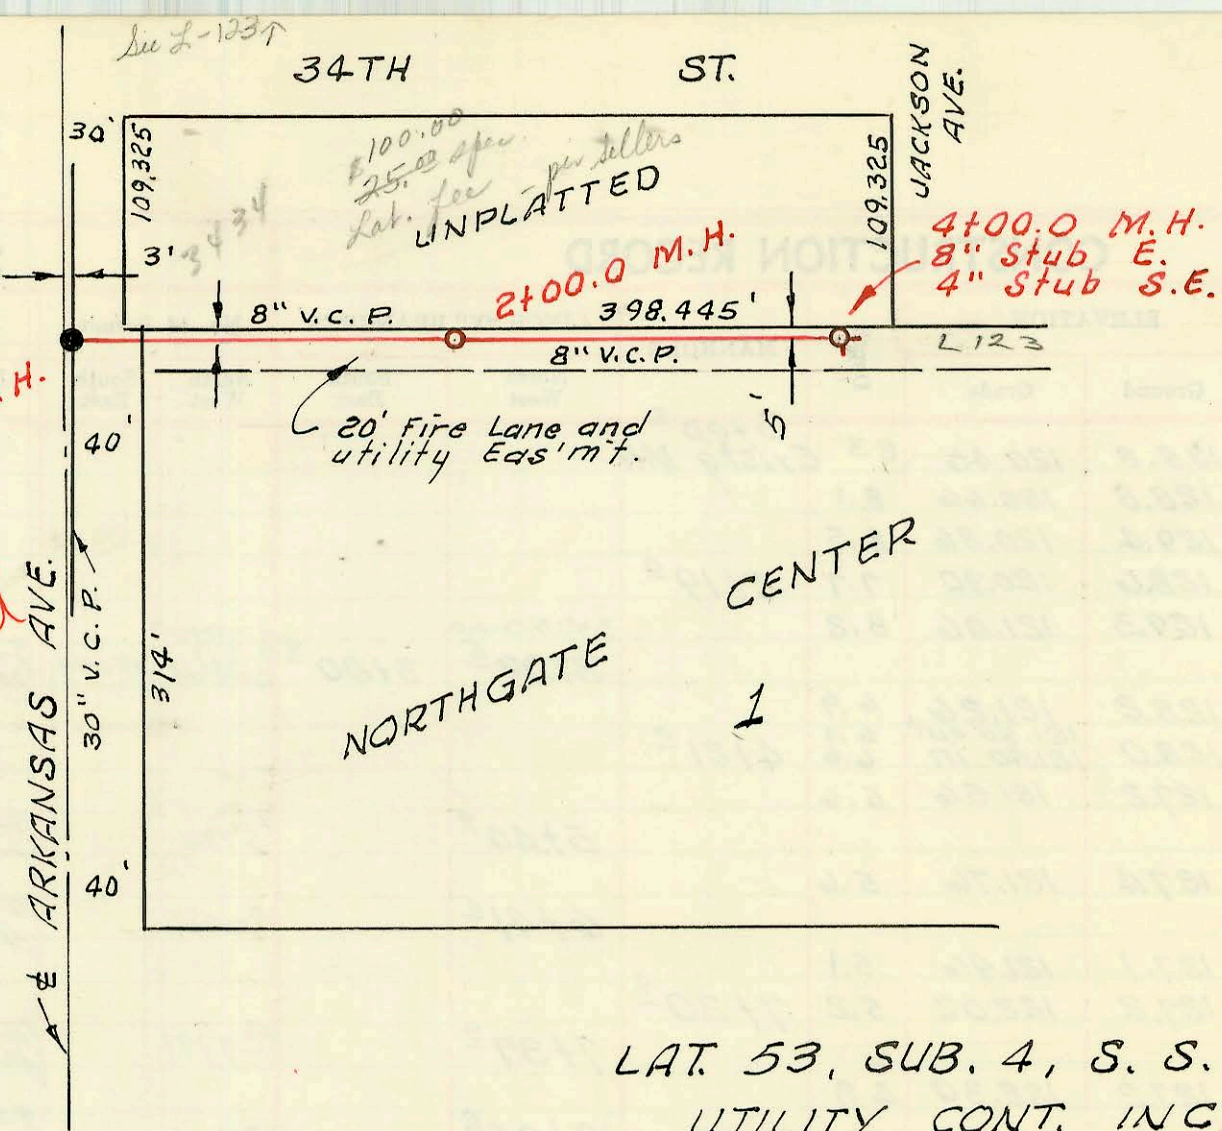

LAT. 53, SUB. 4, S. S. NO. 23
UTILITY CONT. INC.
PRIVATE JOB, BK. NO. K-76A
JAN. 13, 1966

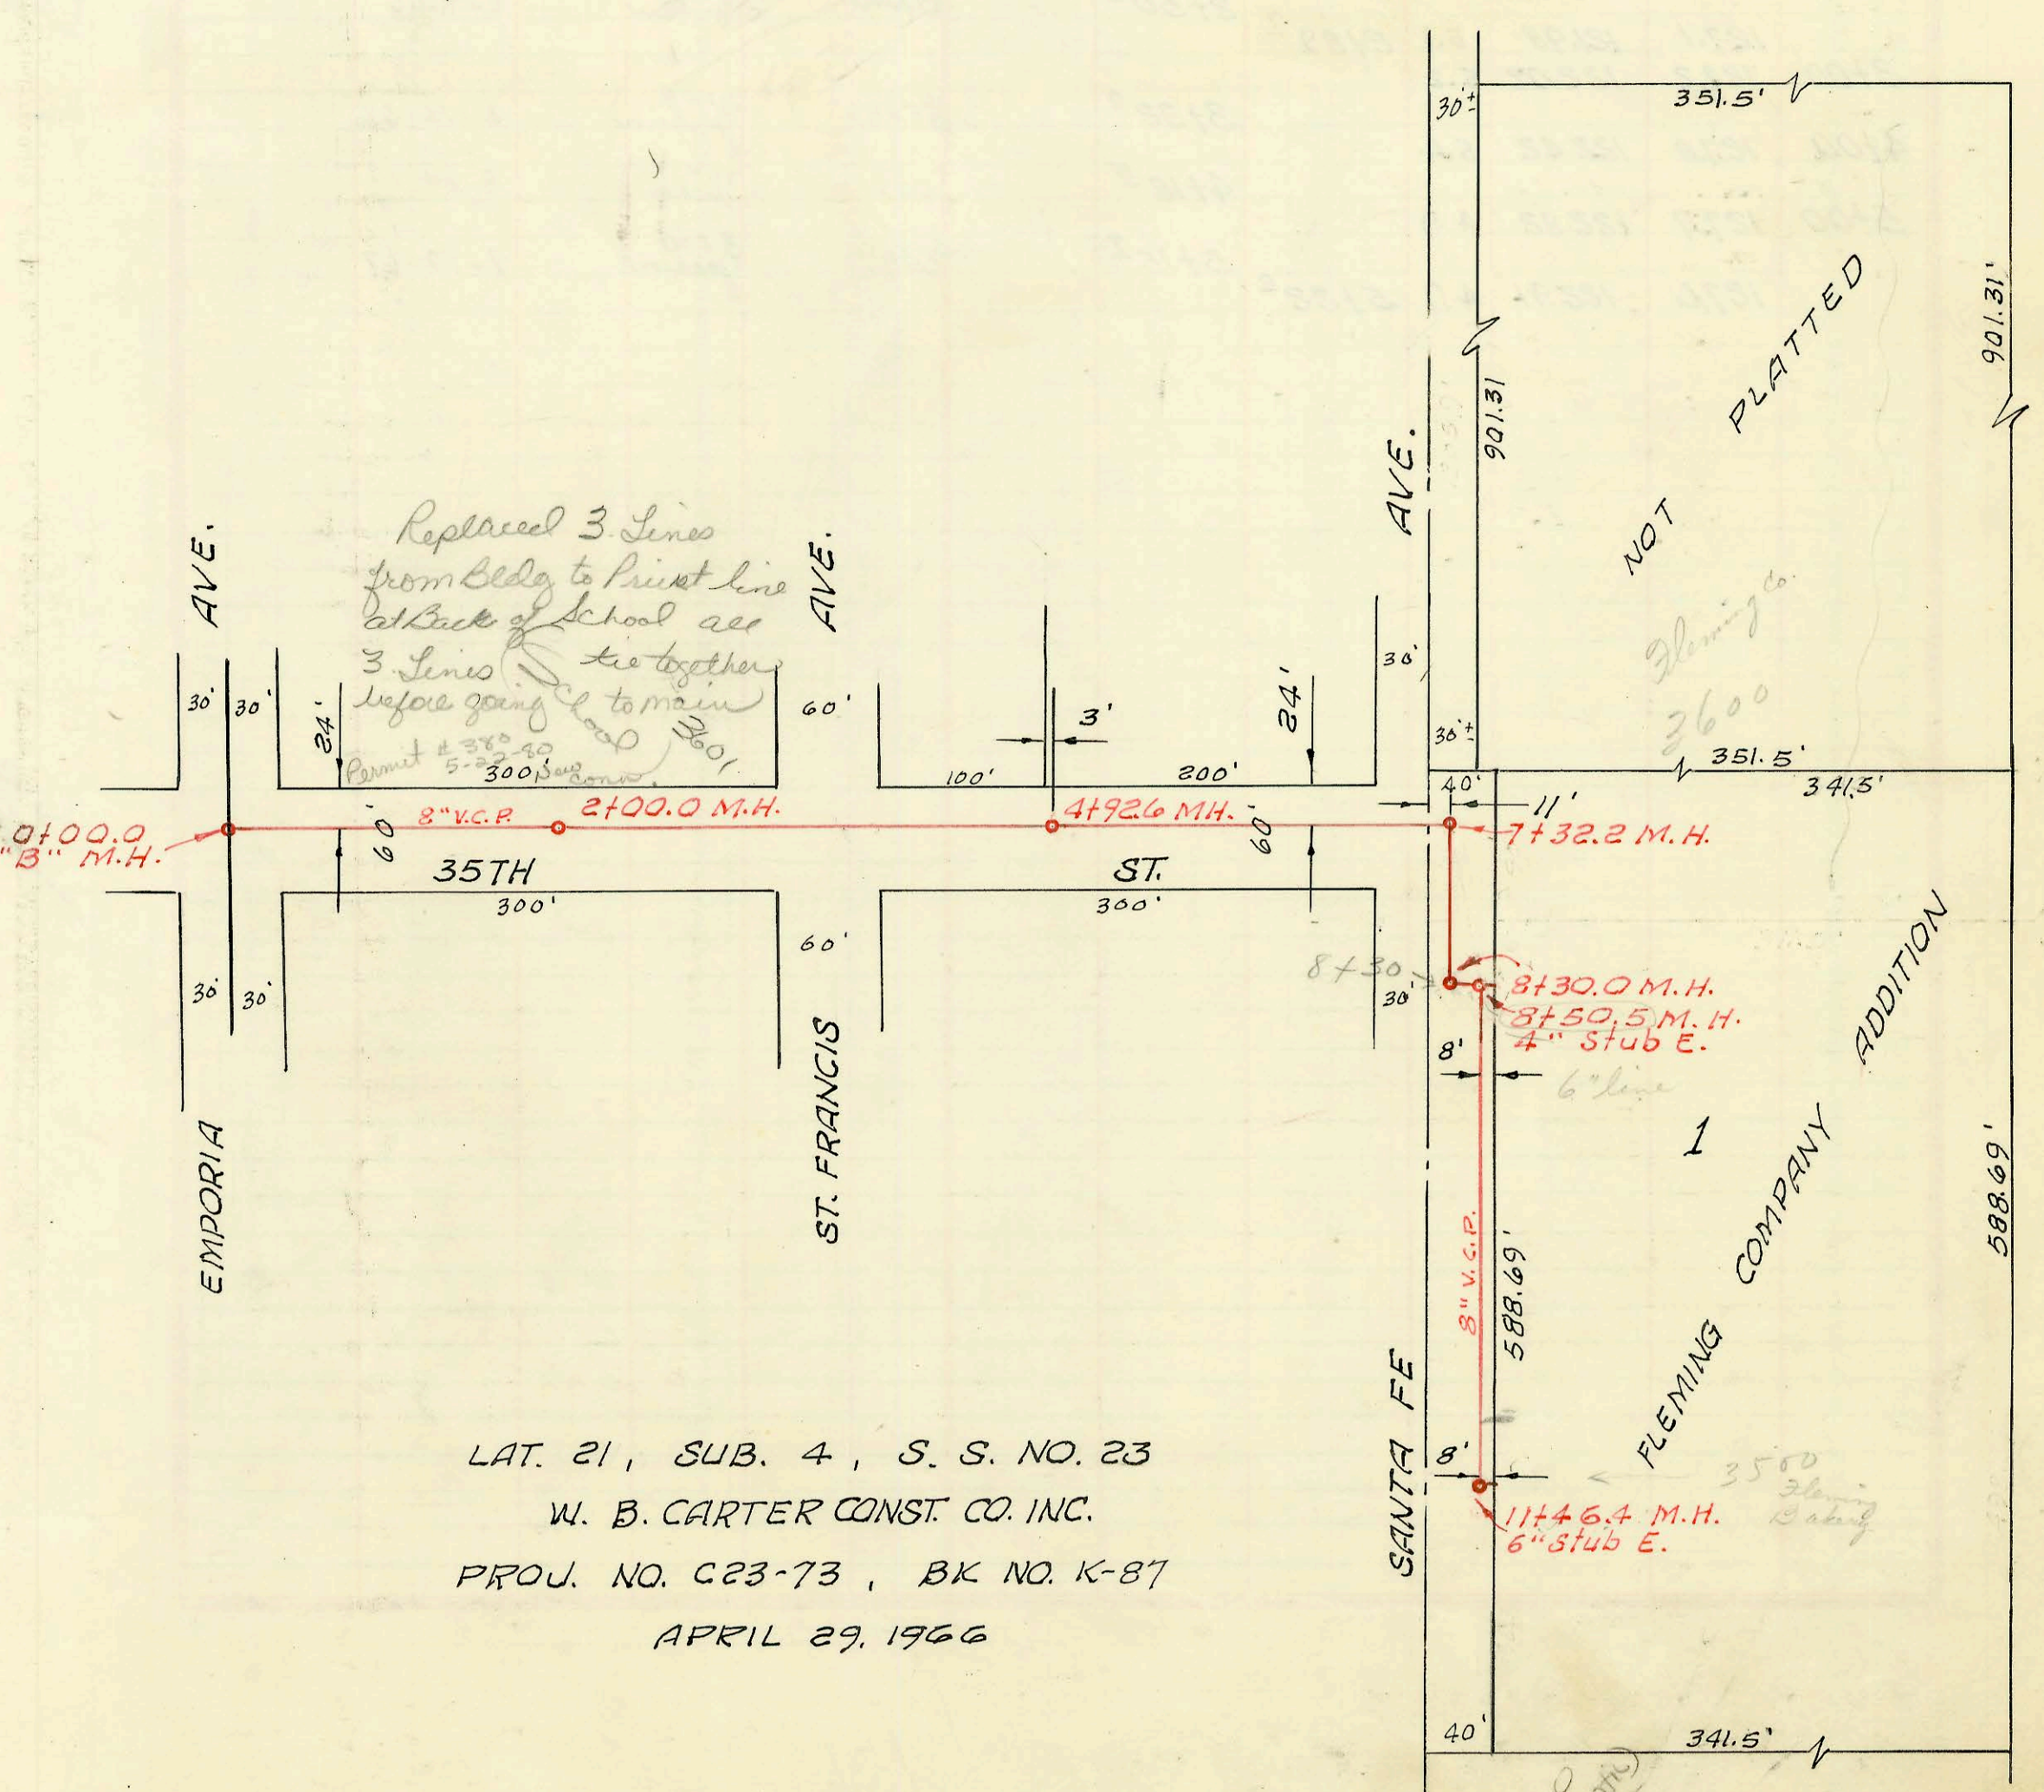

LAT. 21, SUB. 4, S. S. NO. 23
W. B. CARTER CONST. CO. INC.
PROJ. NO. C23-73, BK NO. K-87
APRIL 29, 1966

*3400
(ON 49th)
see plat
page*

