


1" = 100'

LAT. 28, SUB. 4, S. S. NO. 23
W. B. CARTER CONST. CO. INC.
PROJ. NO. C23-80, BK NO. K-83
MAY 10, 1966

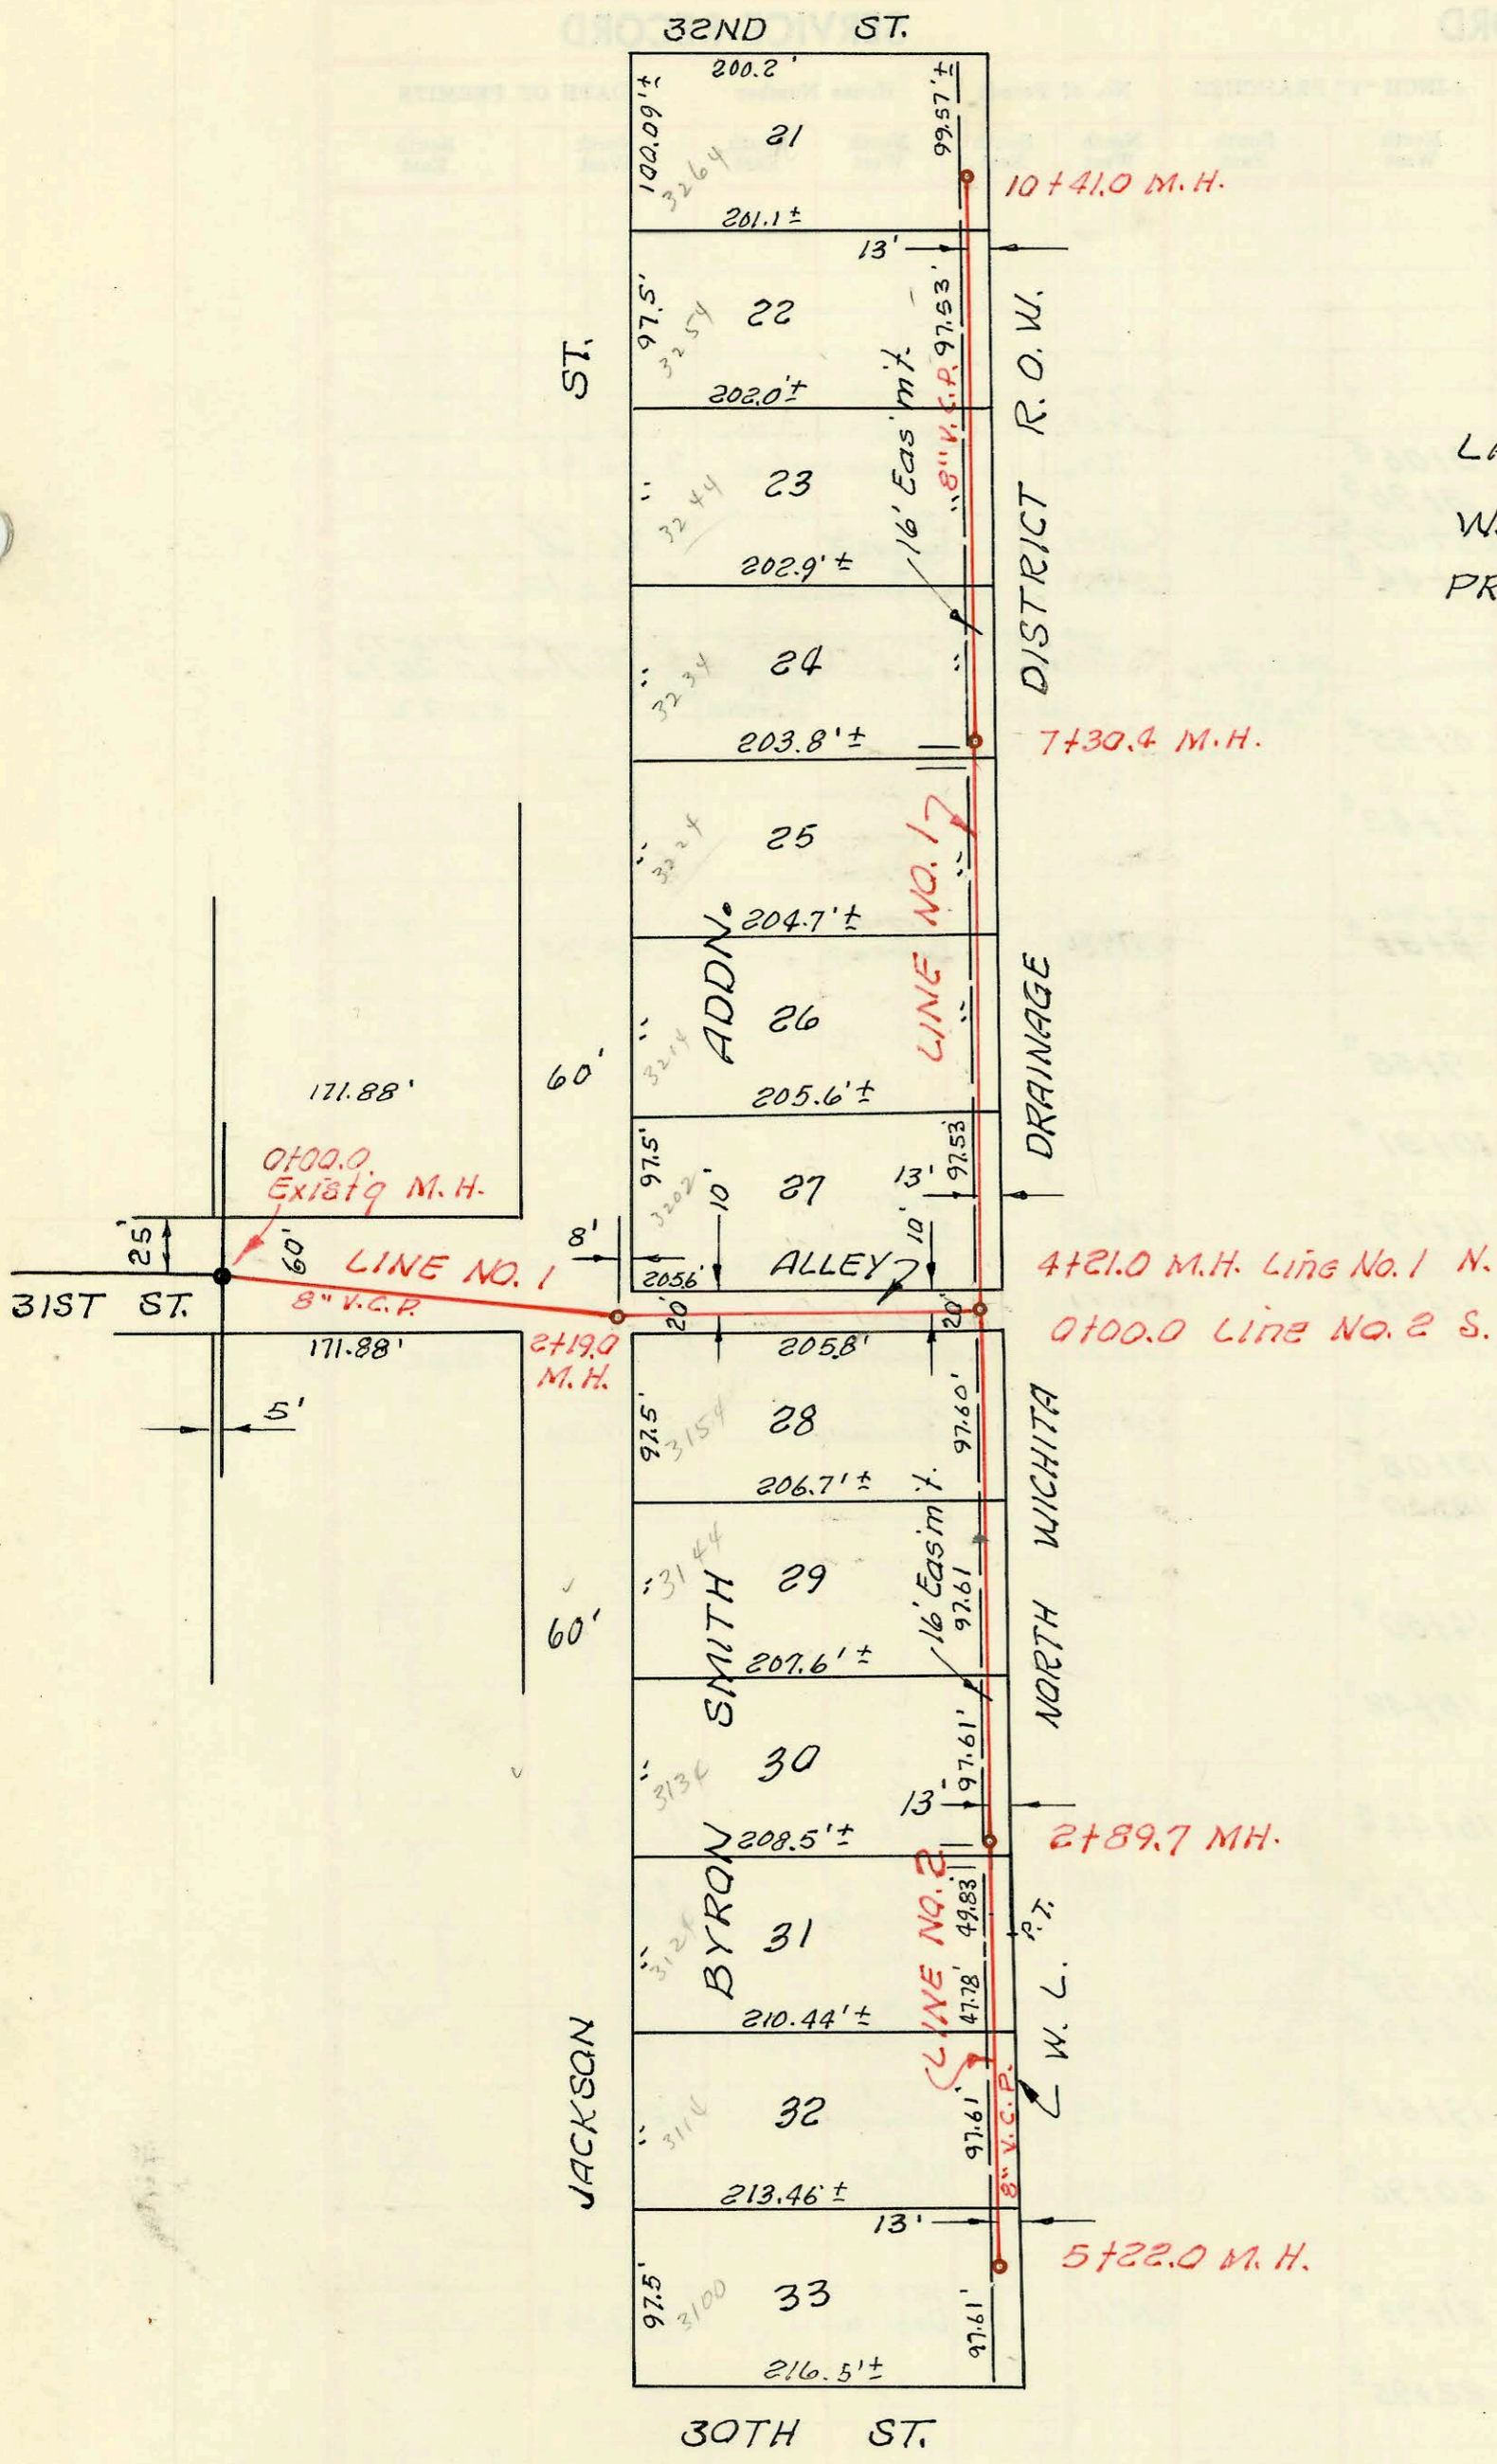

CONSTRUCTION RECORD

SERVICE RECORD

LINE NO. 1

STATION	ELEVATION		Depth	MANHOLE	4-INCH "Y" BRANCHES		No. of Permit		House Number		DATE OF PERMITS	
	Ground	Grade			North West	South East	North West	South East	North West	South East	North West	South East
0+00	128.8	120.46	8.3	0+00 ² Exist ^g MH								
1+00	128.8	120.66	8.1									
2+00	129.4	120.86	8.5									
3+00	128.6	120.90	7.7	2+19 ²								
3+00	129.3	121.06	8.2		3+05.0 wye. 3+02 ⁵	3+00 ⁵	31885-1 30469	35644	3202 ² Jackson	3154 Jackson	9-9-91 6-8-67	5-16-66
4+00	128.2	121.26	6.9									
4+00	128.0	121.30 out	6.7	4+21 ²								
5+00	127.2	121.40 in	6.6									
5+00	127.2	121.56	5.6									
6+00	127.4	121.76	5.6									
6+00	127.4	121.76	5.6									
7+00	127.1	121.96	5.1									
7+00	127.2	122.02	5.2	7+30 ²								
8+00	127.2	122.30	4.9									
8+00	127.2	122.30	4.9									
9+00	127.4	122.70	4.7									
9+00	127.4	122.70	4.7									
10+00	127.3	123.10	4.2									
10+00	127.3	123.10	4.2									
	127.4	123.26	4.1	10+41 ²								
	127.4	123.26	4.1	10+41 ²								
0+00	128.6	121.40	7.2	0+00.0 LINE 2= 4+21.0 LINE 1								
1+00	127.5	121.60	5.9									
2+00	127.2	121.80	5.4									
2+00	127.2	121.80	5.4									
3+00	127.1	121.98	5.1	2+89 ²								
3+00	127.2	122.02	5.2									
4+00	127.8	122.42	5.4									
4+00	127.8	122.42	5.4									
5+00	127.7	122.82	4.9									
5+00	127.7	122.82	4.9									
	127.6	122.91	4.7	5+22 ²								
	127.6	122.91	4.7	5+22 ²								

LINE NO. 2

L