

1605 W. May

MAY


AVE.

ST.

VINE


AVE.

ELIZABETH

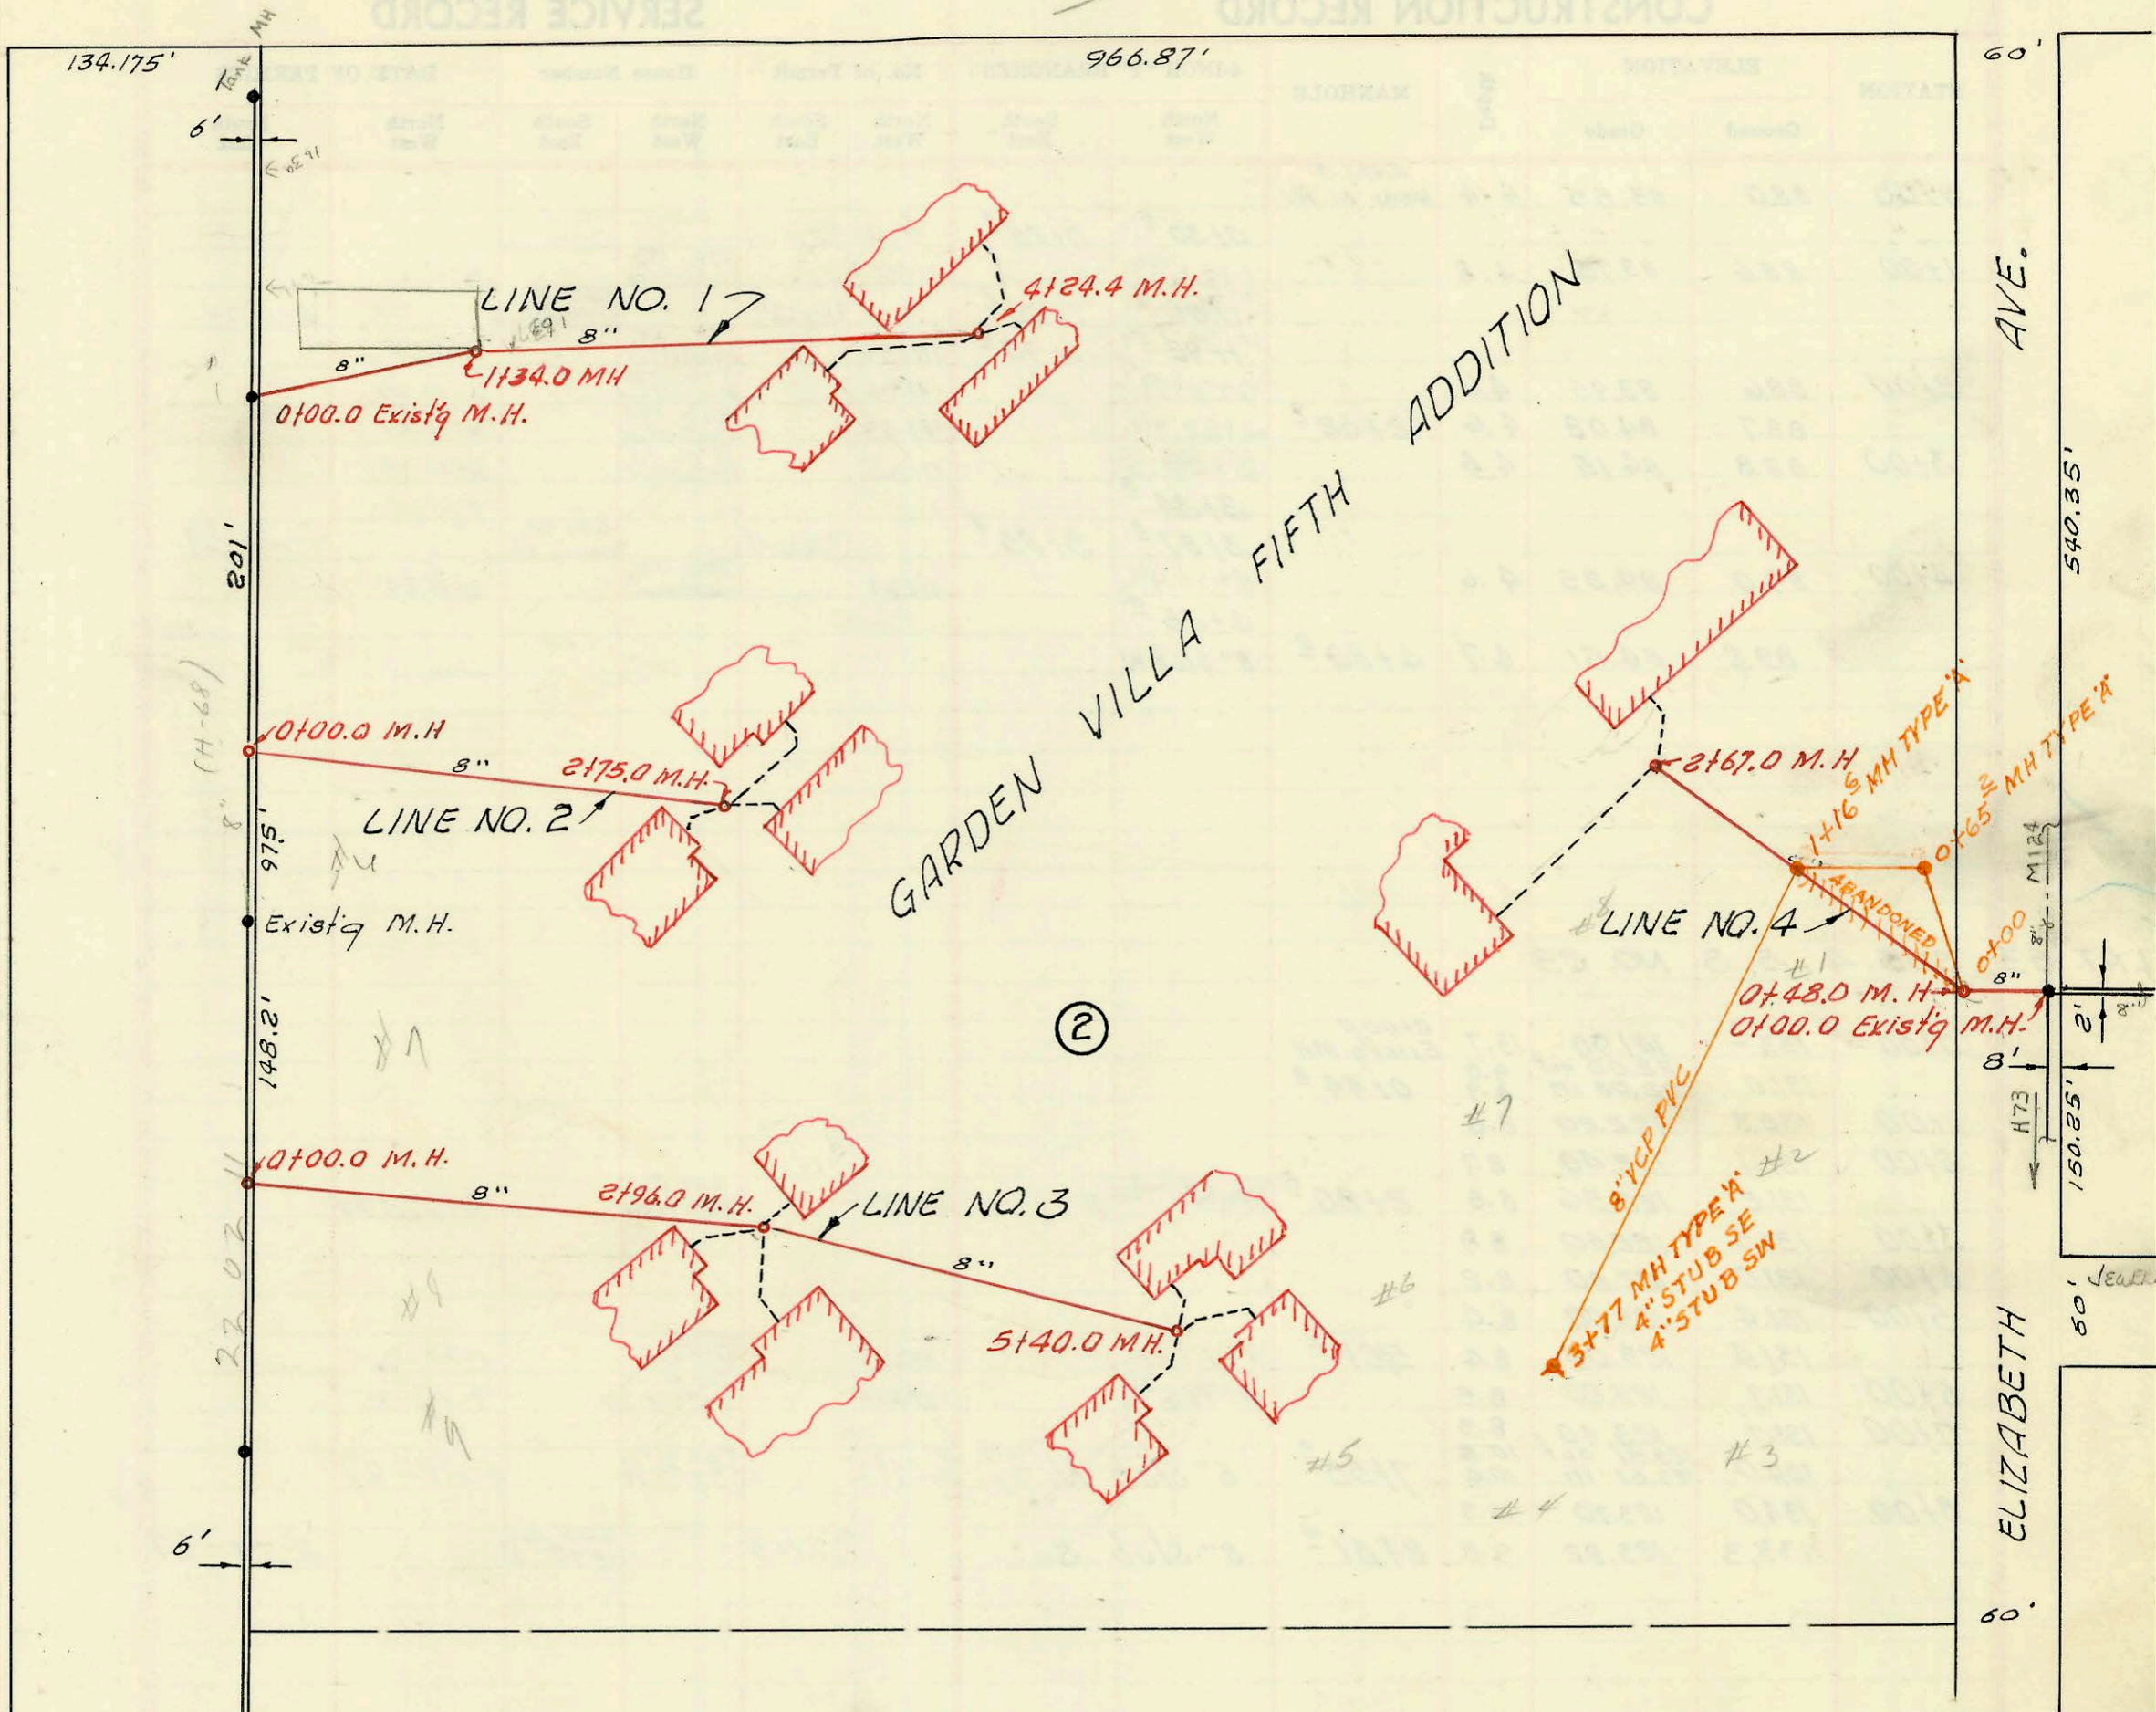

HOME FOR THE ELDERLY - Retirement Community  
 PRIVATE SANITARY SEWER  
 BK. K-80, NOV. 22, 1965

PRAIRIE HOMESTEAD MANOR SAN SEWER  
 BUILT BY: W. B. CARTER CONST. CO.  
 PROJ. No DBKW 707017  
 BOOKED 10-6-77 FROM CLG 13

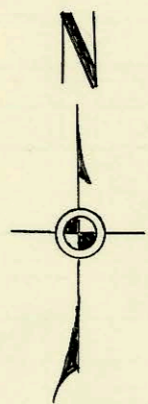

1" = 80'  
 100'

L-25

on map

CONSTRUCTION RECORD

SERVICE RECORD

STATION	ELEVATION		Depth	MANHOLE	4-INCH "Y" BRANCHES		No. of Permit		House Number		DATE OF PERMITS	
	Ground	Grade			North West	South East	North West	South East	North West	South East	North West	South East
LINE NO. 1	0+00	93.00	5.5	0+00 <sup>2</sup> Exist <sup>g</sup> MH	0+03	0+09	B4234	B4222	Unit 1	Unit 1	10-25-65	10-25-65
	1+00	93.40	4.8		6" stub N.E	6" stub S.E	B4223	B4224	Unit 2	Unit 3		10-29-65
		93.53	3.7	1+34 <sup>2</sup>	1+09	1+18.6	B4227	B4226	Unit 4-2	Unit 4-3	9-29-65	9-29-65
	2+00	93.80	2.9		2+41.7	6" stub SE	6717	B4225	Unit 4-6	Unit 4-5	10-11-82	9-29-65
	3+00	94.39	5.0		1+95.6		7940		1637 501-2		4-26-83	
	4+00	94.58	5.8		2+51.8		7937		1637 41-2		4-26-83	
		94.67	5.9	4+24 <sup>2</sup>					may			
LINE NO. 2	0+00			0+00 <sup>2</sup> New MH								
	1+00											
	2+00				2+51.1		B4228	11-11	Unit 4-7		9-29-65	
					2+75 <sup>2</sup>	6" stub E		B4230	Unit 4-9		9-29-65	
						6" stub NE		B4229	Unit 4-8		9-29-65	
LINE NO. 3	0+00	98.1	6.4	0+00 <sup>2</sup> New MH								
	1+00	95.9	3.6									
	2+00	98.0	5.0				11741		Unit 4-10		9-29-65	
		99.7	6.0	2+96 <sup>2</sup>	STUB N.	STUB E	B4232	B4233	Unit 4-11	Unit 4-12	9-29-65	9-29-65
	3+00											
	4+00	97.5	3.4									
	5+00	99.6	5.1									
		99.8	5.1	5+40 <sup>2</sup>								
LINE NO. 4	0+00	91.30	5.2	0+00 <sup>2</sup> Exist <sup>g</sup> MH								
		91.50 out	4.0	0+48 <sup>2</sup>	top of MH		B4235		Unit 2		10-25-65	
	1+00	93.45	5.1									
	2+00	93.65	2.8									
		93.80	2.8	2+67 <sup>2</sup>								
PRAIRIE HOMESTEAD MANOR SAN SEWER												
	0+00	102.4	5.7	0+00 <sup>2</sup> EXISTING								
		102.5	5.5									
		97.01	5.4	0+65.2								
	1+00	103.3	6.1									
		103.0	5.7									
		97.32	5.6	1+16.6								
		97.42										
	2+00	103.0	5.3		1+65.8	1+29.7	C63414	C63407	2101 2	2101 2	10-7-77	10-7-77
					2+81	2+86.6	C63413	C63408	2101 2	2101 2	10-7-77	10-7-77
							C63417	C63409	2101 2	2101 2	10-7-77	10-7-77
	3+00	103.3	5.2									
					3+70.3		C63412		2101 2	2101 2	10-7-77	
		103.5	5.0	3+77	4" STUB SW	4" STUB SE	C63411	C63410	2101 2	2101 2	10-7-77	10-7-77

Sur 2001-01265 S/22101 1605 Bldg add rep w May - Padgett ENTER: 4" SCH 40 Partial - low end No HSMnt - 1-way co, 17WIN CO, 5H45

Tap C43899-1605 May - San Fran - 3-8-74 (1744)