


LAT. 38, SUB. 4, S. S. NO. 23
 W. B. CARTER CONST. CO. INC.
 PROJ. NO. C23-90, BK. K-83
 JUNE 1, 1966

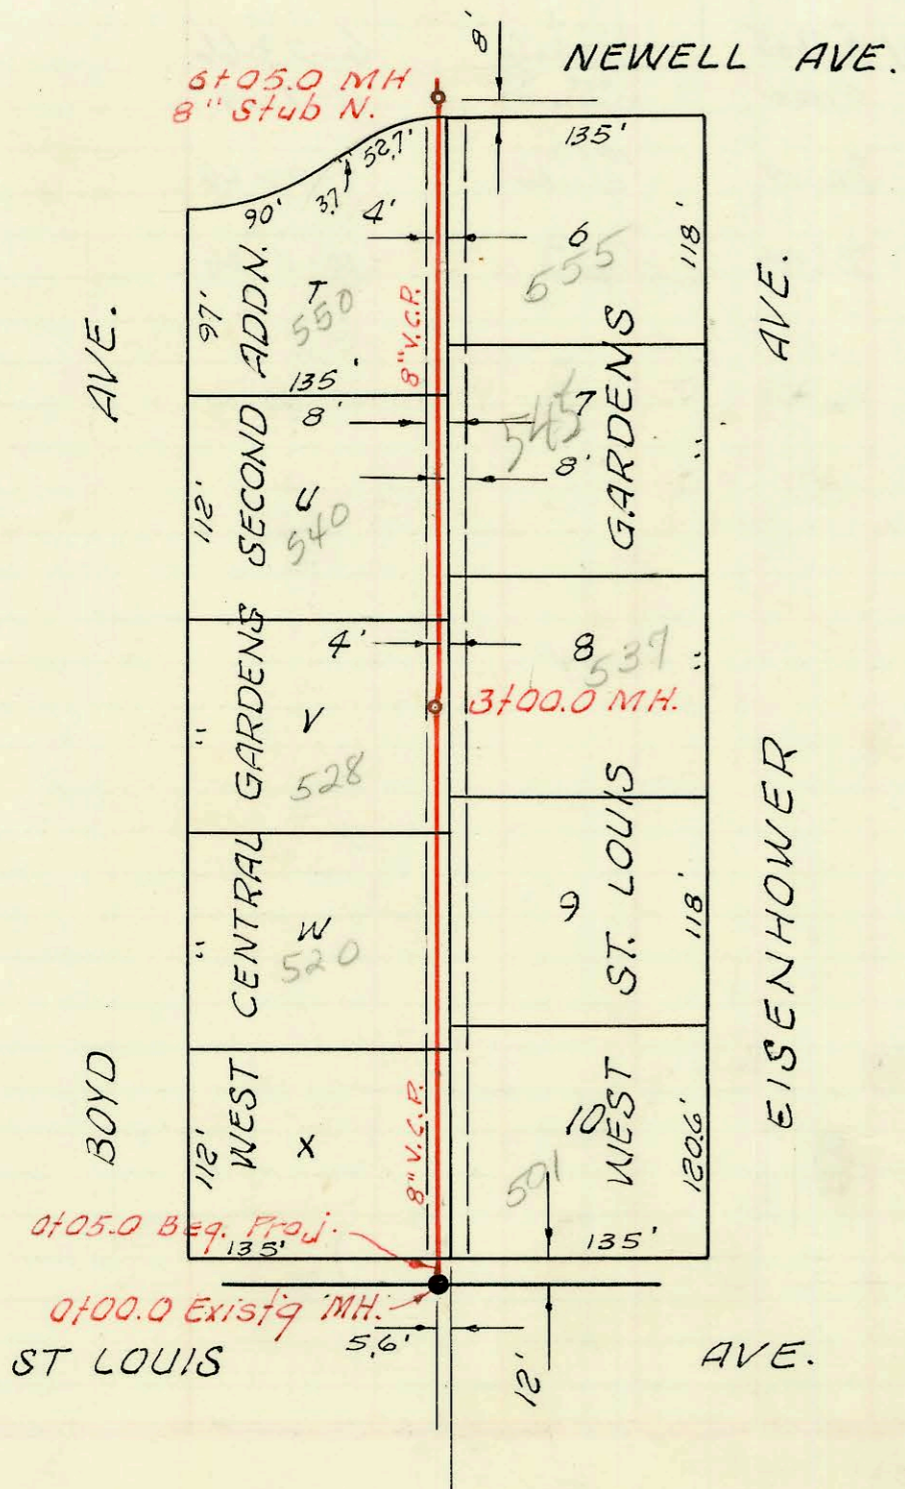

LAT. 192, SUB. 5, S. S. NO. 22
 W. B. CARTER CONST. CO. INC., OCT. 1966
 PROJ. NO. C26-58, BK NO. K-81
 10-28-66

CONSTRUCTION RECORD						SERVICE RECORD						
STATION	ELEVATION		Depth	MANHOLE	4-INCH "Y" BRANCHES		No. of Permit		House Number		DATE OF PERMITS	
	Ground	Grade			North West	South East	North West	South East	North West	South East	North West	South East
0+00	127.8	120.64	7.2	0+00.0 Existg MH								
					0+64°	0+34°						
1+00	127.7	120.79	6.9									
					1+25°	1+67°						
2+00	128.3	120.94	7.4		1+74° Tap	1+91°						
					2+27°	2+39°						
3+00	128.4	121.09	7.3		2+76°							
	128.3	121.11	7.2	3+10°	3+24°	3+56°						
4+00	128.0	121.24	6.8		3+73°							
					4+15°	4+32°						
5+00	128.0	121.39	6.6		4+52°	4+76°						
					5+37°	5+69°						
6+00	127.9	121.54	6.4		5+45.6 TAP	5+77°						
	127.8	121.57	6.2	6+17°	8" Stub N.							
0+00	121.0	114.13	6.9	0+00.0 Existg MH								
0+05°	Beq.	proj.			0+43°	0+45°						
1+00	121.0	114.33	6.7		1+03°	1+83°						
					1+49°	1+92°						
2+00	121.0	114.53	6.5		1+90°	1+92°						
					2+49°	2+66°						
3+00	121.4	114.73	6.7	3+00°	3+84°	3+17°						
					3+74°	3+96°						
4+00	121.0	114.93	6.1		4+42°							
5+00	120.9	115.13	5.8		5+04°	5+36°						
6+00	121.5	115.33	6.2		6+05°	8" Stub N.						
	121.5	115.34	6.2									

C2242-501 Eisenhower - 3-15-67 - Jacob Lemer Service Tap (0+75)
 2004-00296-501 Eisenhower - 2-1-06 - Wichita Ex - Tap (0+77)