
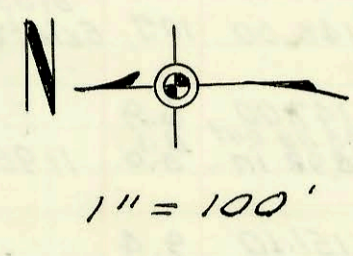


SERVICE RECORD

CONSTRUCTION RECORD

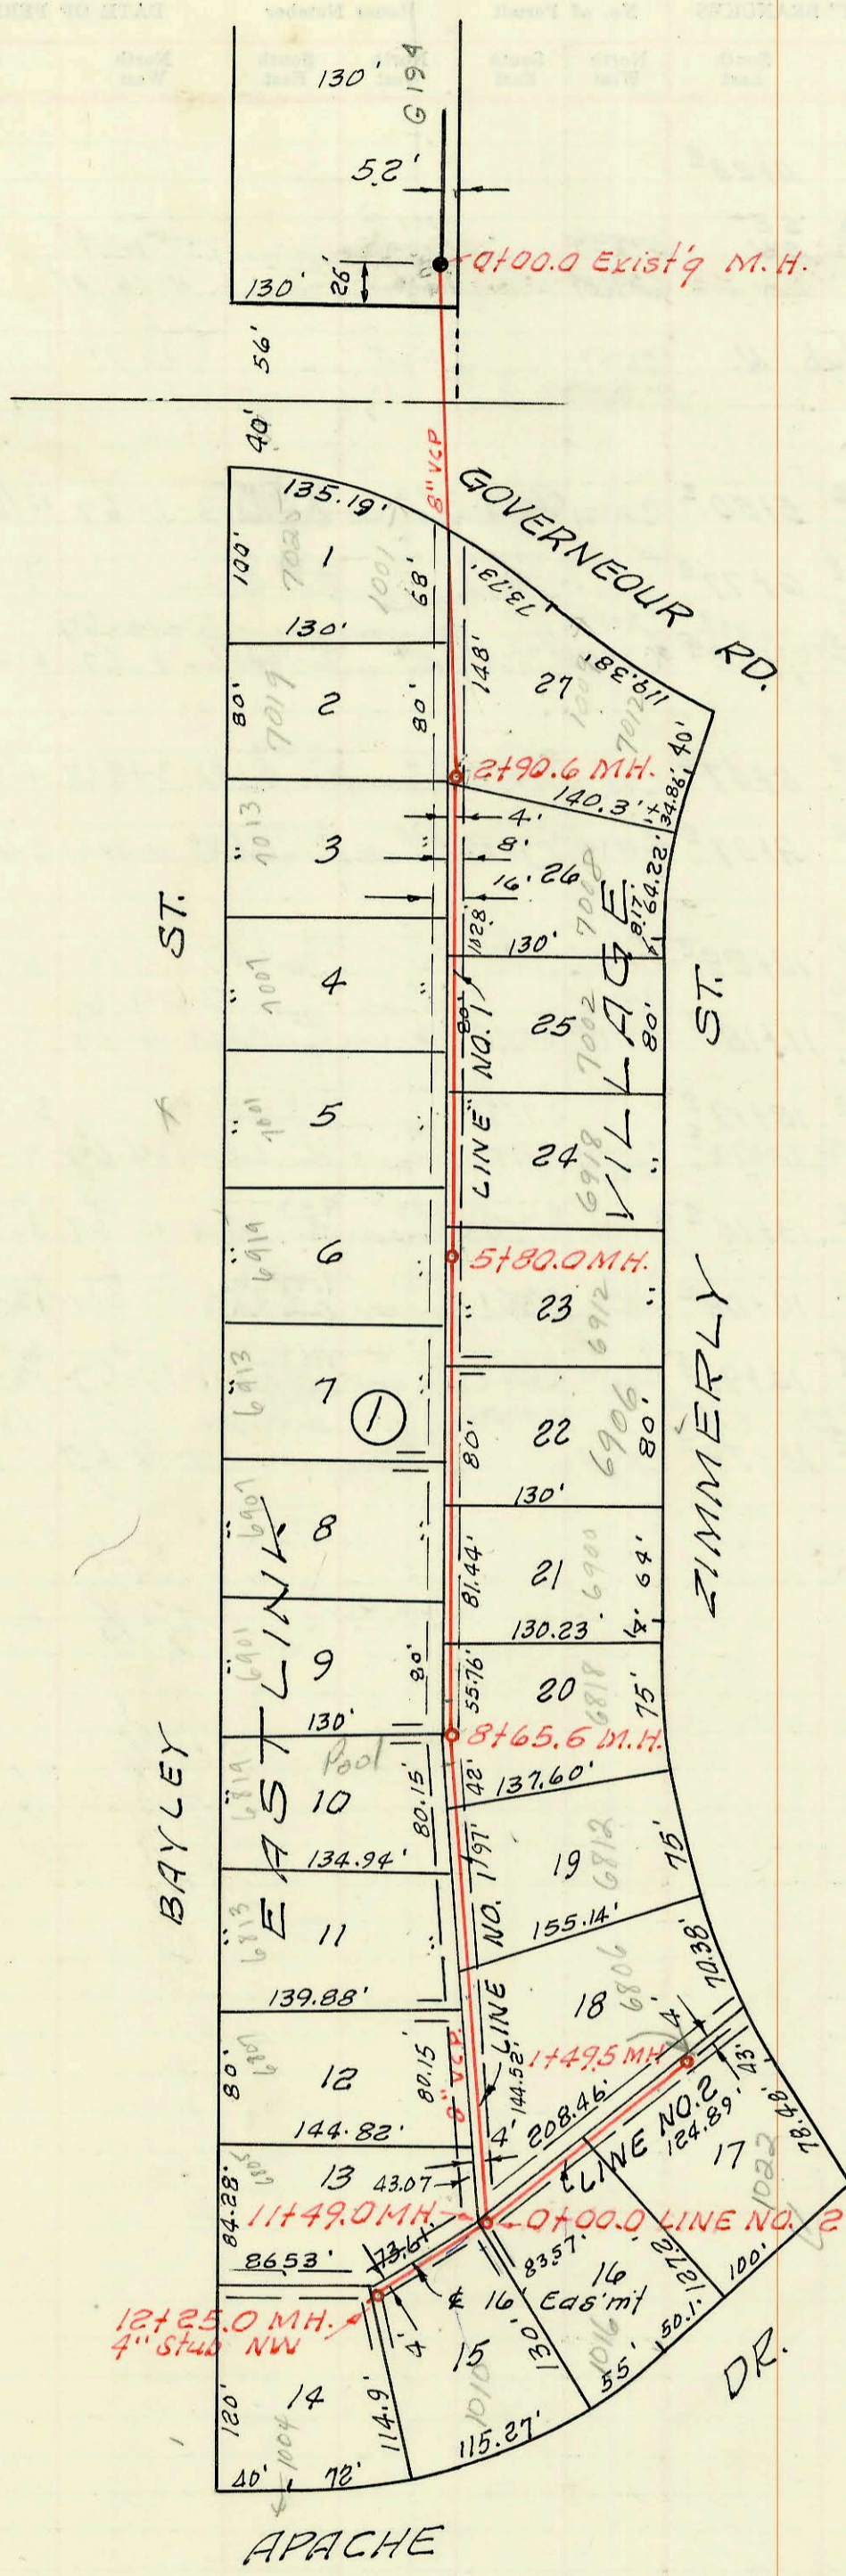

LAT. 8, SUB. 5, W. 1. S.  
 UTILITIES CONTRACTORS INC.  
 PROJ. NO. C26-10, BK # K-85  
 JUNE 22, 1966

L 39.

CONSTRUCTION RECORD

SERVICE RECORD

STATION	ELEVATION		Depth	MANHOLE	4-INCH "Y" BRANCHES		No. of Permit		House Number		DATE OF PERMITS	
	Ground	Grade			North West	South East	North West	South East	North West	South East	North West	South East
0+00	149.7	141.52	8.2	0+00.0 Exist'g MH								
1+00	146.7	141.82	4.9									
2+00	148.7	142.12	6.6		1+67 <sup>s</sup>	1+69 <sup>s</sup>						
					2+00 <sup>s</sup>	2+71 <sup>s</sup>	C11579		1001 S Governor		11-19-68	
	150.8	142.39	8.4	2+90 <sup>s</sup>	2+40 <sup>s</sup>		C5174	C13404	7019 E, 1009 Bayley Governor		10-6-67	4-3-69
3+00	150.6	142.42	8.2		3+22 <sup>s</sup>	3+24 <sup>s</sup>	B5902	*3985	2013 E Bayley	7008 E Zimmerly	6-24-66	7-18-67
4+00	151.8	142.72	9.1		4+00 <sup>s</sup>	4+22 <sup>s</sup>	B5901		7007 E Bayley	7002 E Zimmerly	6-24-66	10-2-67
					4+80 <sup>s</sup>		C6443	*5073	7001 E Bayley		1-17-68	
5+00	151.6	143.02	8.6		5+58 <sup>s</sup>	5+02 <sup>s</sup>	B5900	*3387	6919 E Bayley	6918 E Zimmerly	6-24-66	6-2-67
	152.9	143.26	9.6	5+80 <sup>s</sup>	5+90 <sup>s</sup>		C4239		6912 E Zimmerly			8-4-67
6+00	153.4	143.32	10.1		6+39 <sup>s</sup>	6+65 <sup>s</sup>	B5889		6913 E Bayley	6906 E Zimmerly	6-23-66	6-24-66
7+00	155.0	143.62	11.4		7+35 <sup>s</sup>	7+37 <sup>s</sup>	B5888	*1556	6907 E Bayley	6900 E Zimmerly	6-23-66	1-16-67
					7+99 <sup>s</sup>	8+21 <sup>s</sup>	B5887		6901 E Bayley		6-23-66	
8+00	155.3	143.92	11.4		8+78 <sup>s</sup>	8+37 <sup>s</sup>				6818 E Zimmerly		3-30-67
	156.1	144.12	12.0	8+65 <sup>s</sup>	9+72 <sup>s</sup>	9+19 <sup>s</sup>	B5886	C4572	6813 E Bayley	6812 E Zimmerly	6-23-66	8-23-67
9+00	156.0	144.22	11.8		10+50 <sup>s</sup>	10+13 <sup>s</sup>	#5877	C3038	6807 E. Bayley	6806 E Zimmerly	6-22-66	5-10-67
10+00	155.2	144.52	10.7		11+22 <sup>s</sup>	11+68 <sup>s</sup>	B6038		6805 E Bayley		7-20-66	
11+00	155.1	144.82	10.3		12+25 <sup>s</sup>	4" stub NW	B5885		7004 Apache		6-23-66	
	154.9	144.97 out 9.9 145.07 in 9.8	9.9	11+49 <sup>s</sup>			C75227		7010 Apache		11-7-79	
LINE #2 0+00	154.9	145.07	9.8	0+00 LINE NO. 2 = 11+49 <sup>s</sup> LINE NO. 1	0+24 <sup>s</sup>		B6068		1016 Apache		7-27-66	
1+00	154.8	145.47	9.3		1+00 <sup>s</sup>		B6433		1022 Apache		10-3-66	
	154.4	145.67	8.7	1+49 <sup>s</sup>								

L  
39