



SERVICE RECORD

CONSTRUCTION

P214  
P-52

ZETA

See PRIVATE  
SEWER EASE  
F 5' of  
W 15' of  
1/2 of Lot 40  
granted to  
S 1/2 of Lot 40  
for sewer  
1978

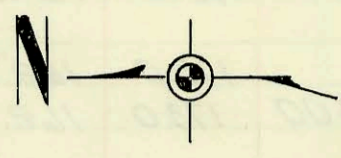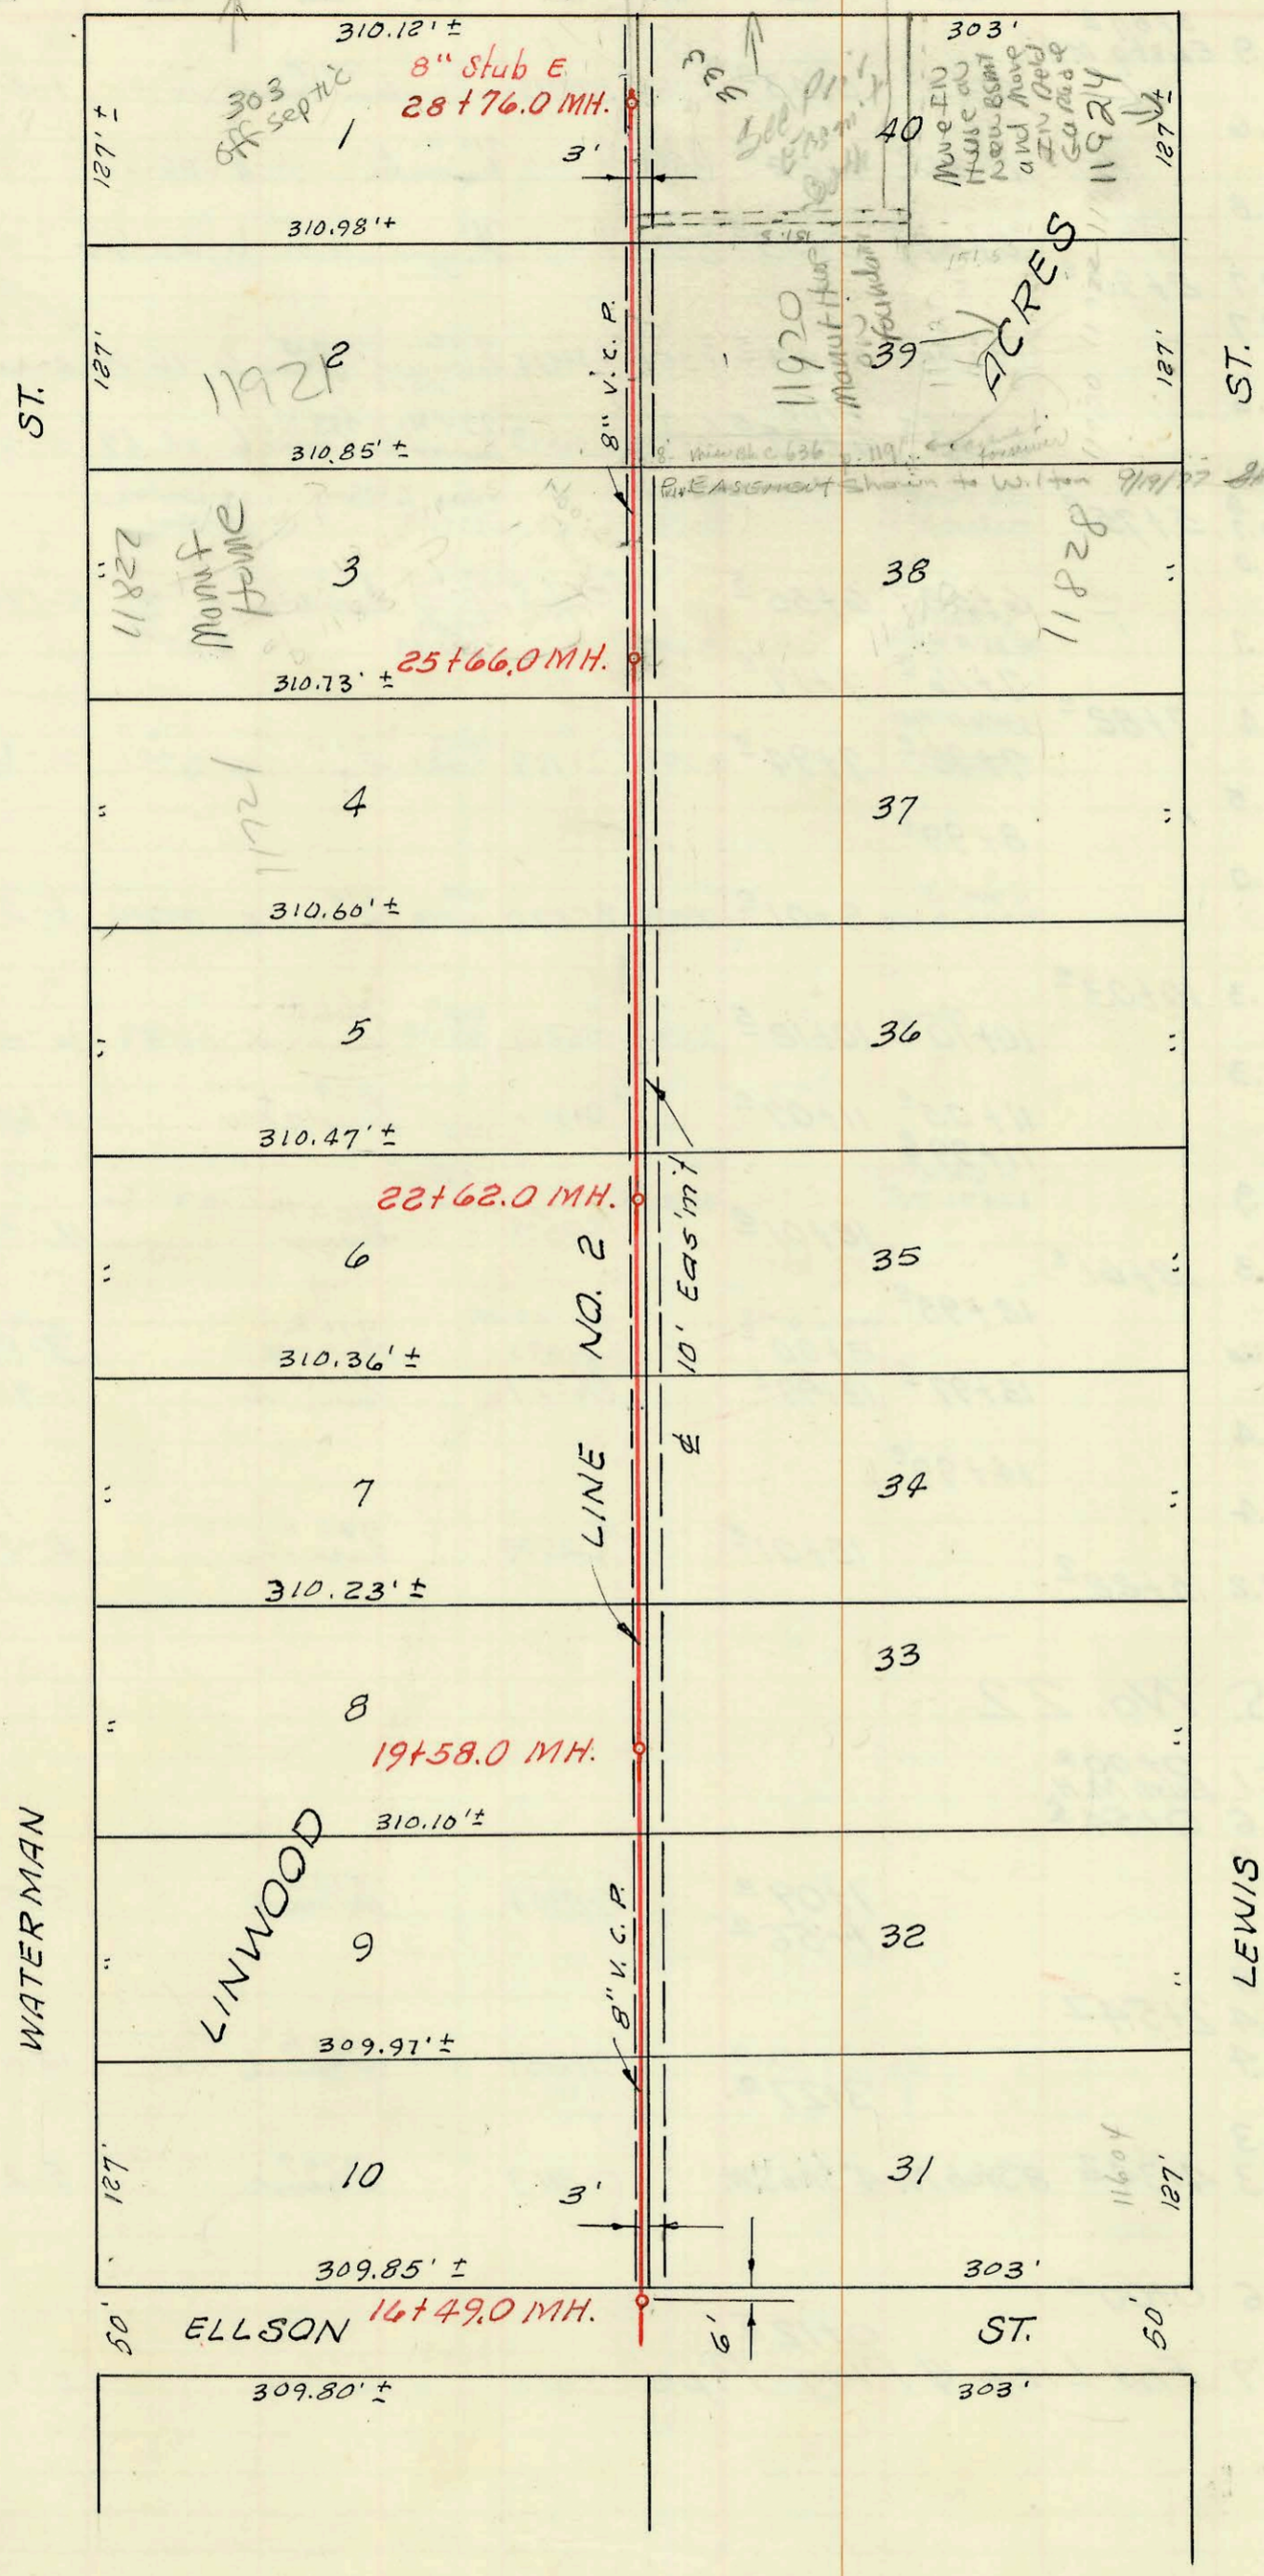

1" = 100'

LAT. 4, SUB. 13, W. 1. S.

**CONSTRUCTION RECORD**

**SERVICE RECORD**

LINE No. 2  
Continued

STATION	ELEVATION		Depth	MANHOLE	4-INCH "Y" BRANCHES		No. of Permit		House Number		DATE OF PERMITS	
	Ground	Grade			North West	South East	North West	South East	North West	South East	North West	South East
				16+49°								
17+00	182.9	168.55	14.3		16+68°	16+70°						
18+00	182.4	168.75	13.6		17+38°	17+40°	88-12807 65186		11604 ESO Lewis		7-6-98 10-6-67	
19+00	183.3	168.95	14.3		18+00°	18+02°						
					18+65°	18+67°						
19+00	183.4	169.07	14.3	19+58°	19+30°	19+32°						
20+00	183.1	169.15	14.0		19+91°	19+93°						
21+00	182.6	169.35	13.2		20+56°	20+58°						
22+00	181.9	169.55	12.3		21+14°	21+16°						
					21+83°	21+85°						
23+00	181.4	169.68	11.7	22+62°	22+47°	22+49°						
	181.0	169.75	11.2		23+11°	23+13°						
24+00	179.8	169.95	9.8		23+75°	23+77°						
25+00	181.8	170.15	11.7		24+38°	24+40°	C44029		11816 E. Lewis		3-19-74	
					24+97°	24+99°						
26+00	182.1	170.29	11.8	25+66°	25+57°	25+59°	771347		11828 Lewis		7-7-97	
					26+29°	26+31°	788241 9639187 17002		11827 Lewis		5-22-98 3-25-96 9-9-86	
27+00	181.2	170.55	10.6		26+88°	26+90°						
					27+22°	26+76°	9336 C6131	11921	11920 E Lewis		9-27-83	12-13-67
28+00	182.0	170.75	11.2		27+52°	27+54°						
					28+11°	28+13°	20635 05825		11924 NC Lewis		3-28-03	
	181.8	170.91	10.9	28+76°	28+69°	28+71°	21650 C71590	303 Zelta	333 Zelta		10-12-88	5-2-79
Baxter Place Hillpark - N/C												
11755 E WATERMAN - SWR 2001-01634 Lots 31, 32, 33, 34, 35 & 36 4" SCH 40 7/24/01												
2001-01635 Lots 37, 38, 39, 40, 41, 42, 43, 44, 45, 46, 47 & 48 4" SCH 40 7/20/01												
2001-01636 Lots 1, 2, 3, 4, 5, 6, 7 & 8 4" SCH 40 7/17/01												
2001-01637 Lots 9, 10, 11, 12, 13, 14, 15, 16, 17, 18, 19, 20, 21, 22, 23, 24, 25, 26 & 27 4" SCH 40 7/31/01												
2001-01638 Lots 28, 29, 30 4" SCH 40 7/24/01												
964328-7 8/28/96 11920 E Lewis - Nic Mobile Home on foundation -												

76-14382-7  
C 6130 11922 E Lewis - Phil's Trucking - 12-13-67 - top (26+78.0)