
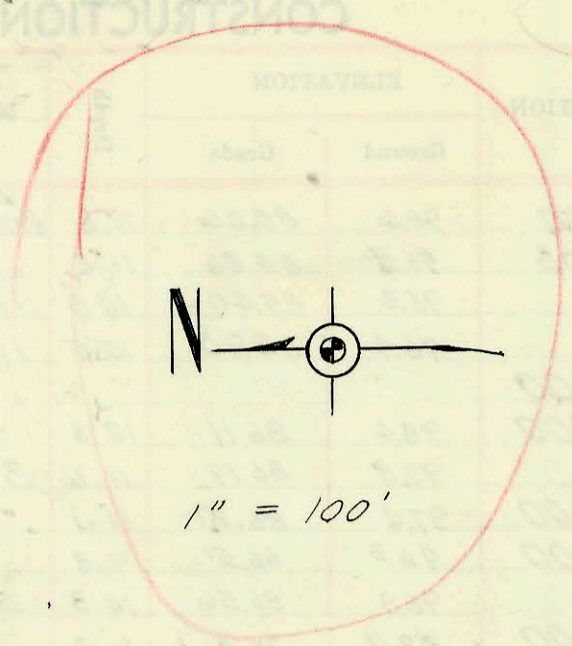


Plot 7-43

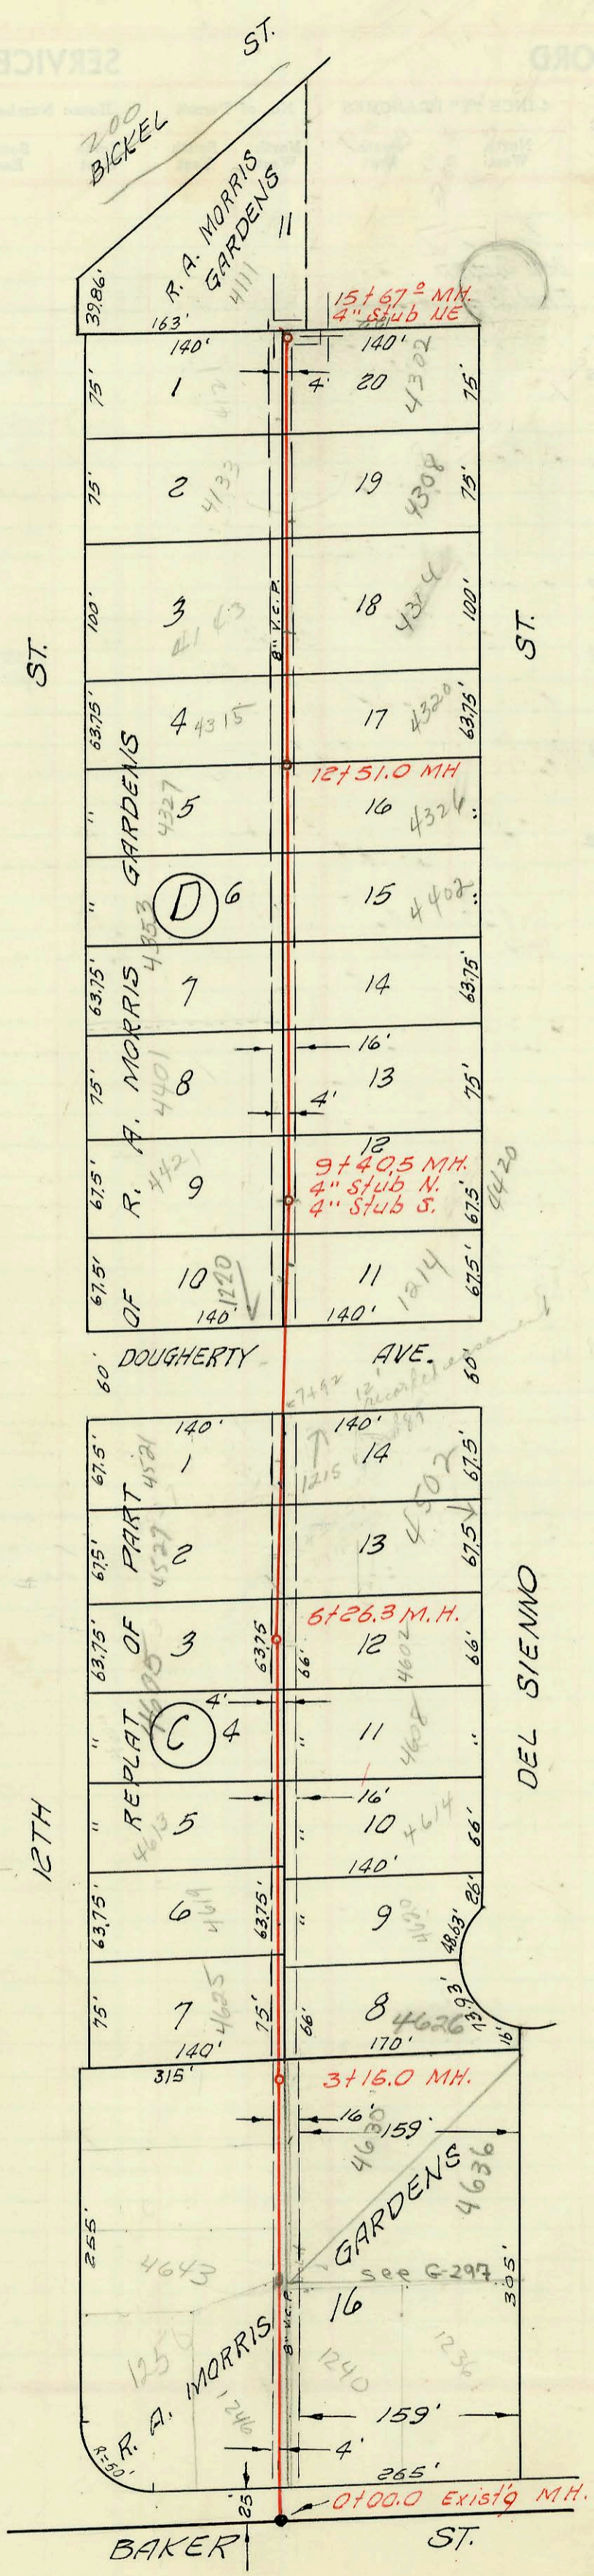

LAT. 188, SUB. 5, S. S. NO. 22  
 MID-STATES CONST. CO. INC. SEPT. 1966  
 PROJ. NO. C25-45 BK. NO. K-76-A  
 9-8-66

3/20/68  
 7/28  
 3/4/68

CONSTRUCTION RECORD						SERVICE RECORD						
STATION	ELEVATION		Depth	MANHOLE	4-INCH "Y" BRANCHES		No. of Permit		House Number		DATE OF PERMITS	
	Ground	Grade			North West	South East	North West	South East	North West	South East	North West	South East
0+00	132.7	114.50	18.2	0+00.0								
1+00	129.8	114.70	15.1	Existg MH								
2+00	127.3	114.90	12.4		4' Riser 5 1+08 5 4' Riser 2 1+55 2 2+48 0 4' Riser 2 2+58 2	4' Riser 5 1+06 5 4' Riser 2 1+53 2 4' Riser 2 2+56 2	C-27810 C-76078 C-75634	318	1250 BAKER 4637 W 4631 W 12th	4643 W 12th	9-9-71 1-14-80 12-6-79	5-21-80
3+00	126.7 126.5	115.10 115.13	11.6 11.4	3+16 2								
4+00	126.2	115.30	10.9		3+44 5	3+52 2	B6348		4625 W 12th	4626 Del Sienna	9-20-66	10-11-75
5+00	126.4	115.50	10.9		4+24 2	4+18 2	C56024		4620 Del Sienna			6-21-76
6+00	126.0	115.70	10.3		4+72 2	4+85 2	C39923		4614 Del Sienna			7-9-73
7+00	126.3	115.75	10.5	6+26 3	5+57 5	5+55 5	C14474		4613 W 12th		7-2-74	
8+00	127.5	115.90	11.6		6+09 5	6+07 5	C55592	JAP C12892	4605 W 12th	4602 Del Sienna	5-24-76	2-25-69
9+00	126.1	116.10	10.0		6+63 2	6+95 2	B6298		4527 W. 12th	1215 DOUGHERTY		10-19-67
10+00	124.9	116.30	8.6		7+52 5	7+50 5	6825		4521 W. 12th	4502	10-31-82	
11+00	124.9	116.38	8.5	9+40 5	8+85 2	7+93 3	C9456	C9493	1220 W 12th	4502 Del Sienna	7-5-68	7-8-68
12+00	125.6	116.50	9.1		8+96 2	8+94 2	C1706		1214 DOUGHERTY			4-2-68
13+00	125.9	116.70	9.2		4" stub N.	4" stub S.	C50439	C4118	4421 W 12th	4420 Del Sienna	7-21-75	7-27-67
14+00	125.3	116.90	8.4		10+05 5	10+03 5	C1793		4401 W 12th		2-7-67	
15+00	124.5	117.00	7.5	12+51 2	10+94 2	10+92 2	B6364		4353 W 12th		9-21-66	
16+00	124.3	117.10	7.2		11+53 2	11+51 2	C20426		4402 Del Sienna			8-7-70
17+00	125.5	117.30	8.2		12+15 5	12+13 5	C42195	C20425	4327 W 12th	4326 Del Sienna	11-9-73	8-7-70
18+00	124.8	117.50	7.3		12+74 2	12+72 2	C54077	C20424	4315 W 12th	4320 Del Sienna	3-9-76	8-7-70
19+00	125.4	117.63	7.8	15+67 2	13+49 2	13+47 2	C10142		4143 W. 12th		8-21-68	
20+00	125.4	117.63	7.8	15+12 2	14+38 5	14+36 5	B6236		92-4401-7 W. 12th	4133 Del Sienna		12-4-92
21+00	125.4	117.63	7.8	15+09 3	15+12 2	15+54 3	C10191	13189	4121 W 12th	4302 Del Sienna	7-23-73	3-12-85
22+00	125.4	117.63	7.8	15+67 2	4" stub NE		C1963		4111 W 12th		2-20-67	