


LAT. 7, SUB. 19, S. S. NO. 22  
 UTILITY CONTRACTORS INC., SEPT. 1966  
 PROJ. NO. C25-11 BK. NO. K-77  
 9-9-66

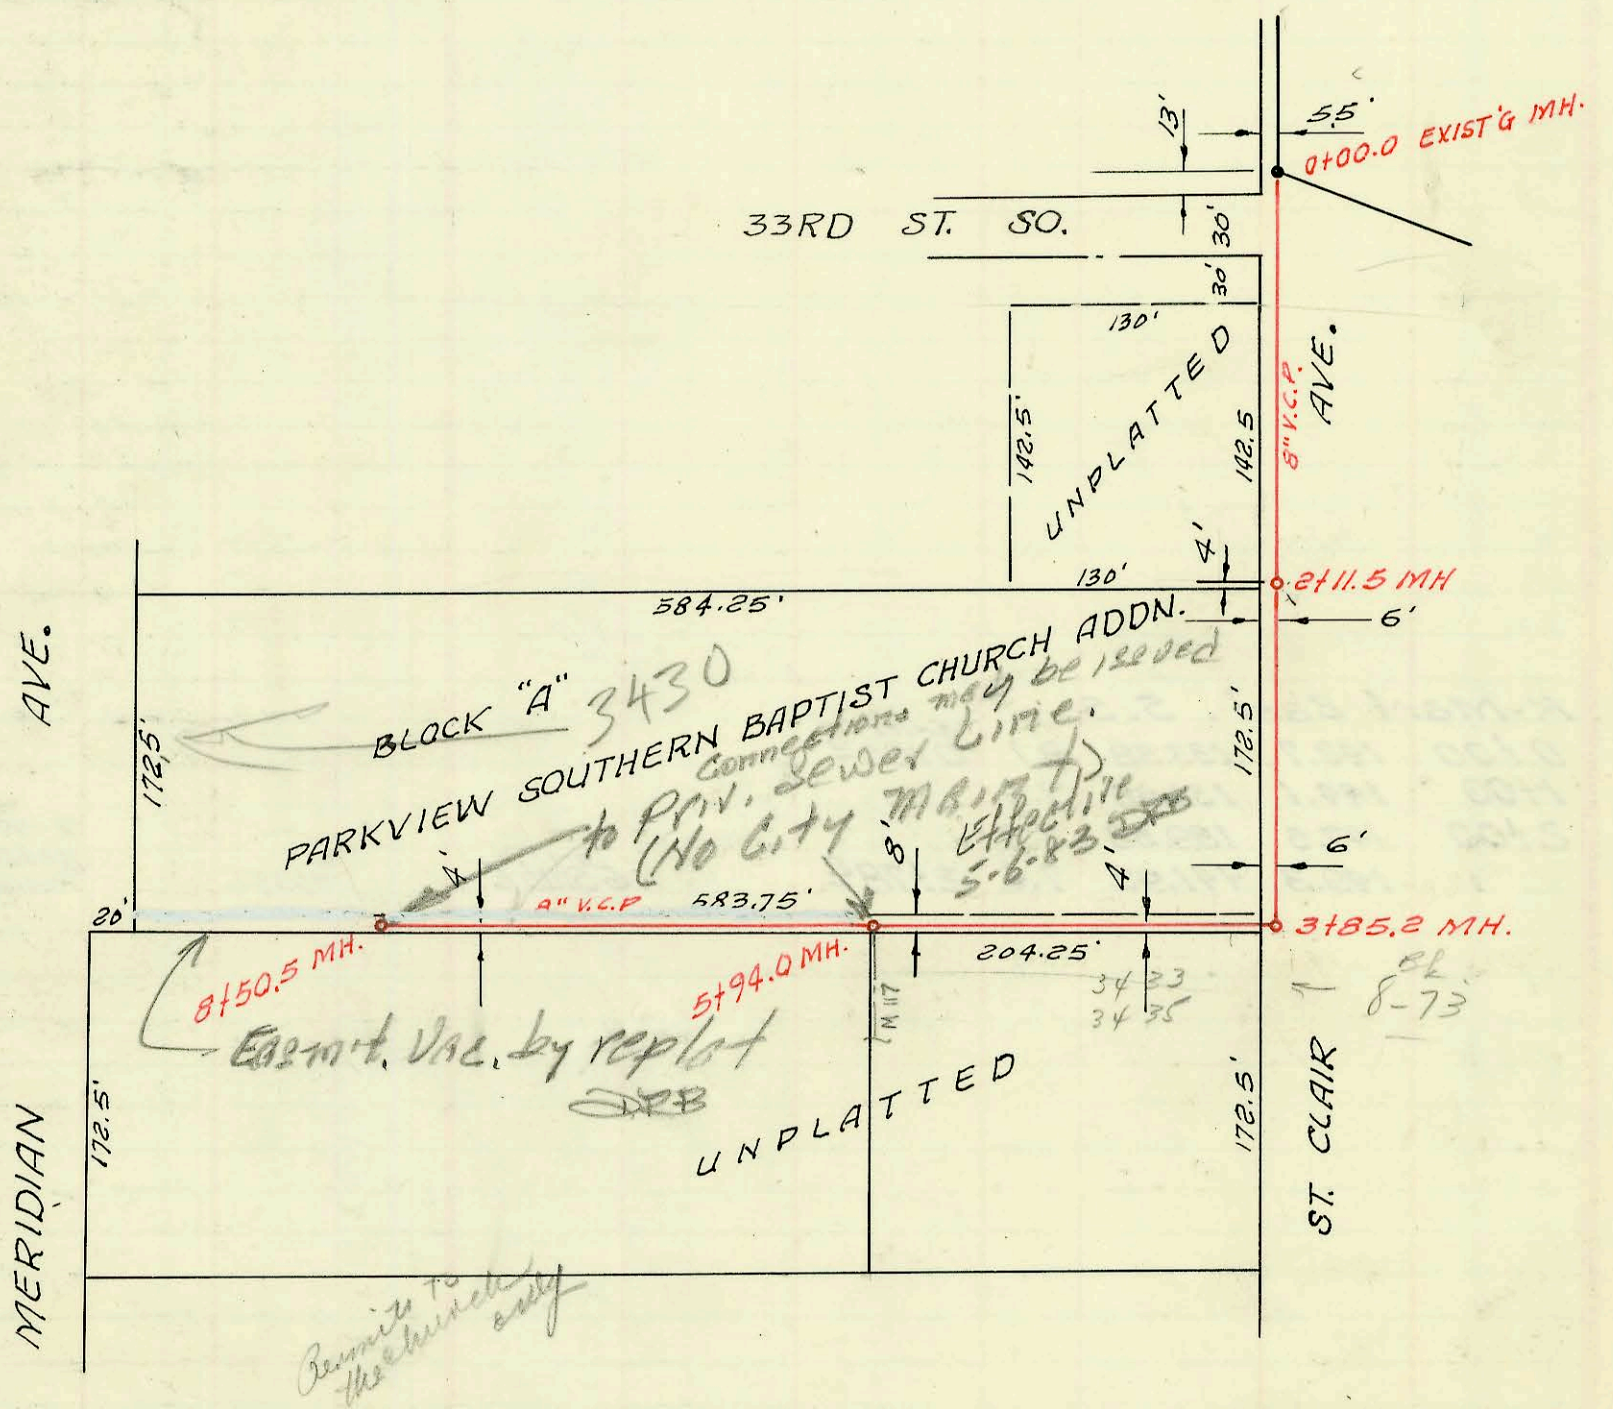

LAT. 29, SUB. 3, S. S. NO. 22  
 UTILITY CONTRACTORS INC.  
 PROJ. NO. C26-21, BOOK #K-87  
 10-5-66

CONSTRUCTION RECORD

SERVICE RECORD

STATION	ELEVATION		Depth	MANHOLE	4-INCH "Y" BRANCHES		No. of Permit		House Number		DATE OF PERMITS	
	Ground	Grade			North West	South East	North West	South East	North West	South East	North West	South East
0+00	125.8	118.46	7.3	0+00.0 Exist'g MH								
0+60 <sup>9</sup>		Beq. proj.										
1+00	125.2	118.66	6.5		1+16 <sup>5</sup>	1+21 <sup>5</sup>	C22649	C14102	2818 Cornelison	2101 Hyacinth	1-21-71	5-15-69
2+00	127.3	118.85 out 118.95 in	8.4 8.3	1+96 <sup>4</sup>	1+42.1		C51473		2107 Hyacinth			9-23-75
3+00	125.9	119.16	6.7		2+25 <sup>8</sup>	3+27 <sup>6</sup>						
					3+16 <sup>9</sup>	3+94 <sup>9</sup>		C32288 C39981	2818 Cornelison	2902 Cornelison		5-15-72 5-14-73
4+00	126.3 126.4	119.36 119.50	6.9 6.9	4+70 <sup>8</sup>	4+60 <sup>8</sup>	4+79 <sup>8</sup>		C25187	2910 Cornelison			6-30-71
5+00	126.8	119.61	7.2		4+95 <sup>5</sup>			C6328	2930 Cornelison		9-12-66	
	127.2	119.90	7.3	5+78 <sup>9</sup>	5+58 <sup>9</sup>			C8333	2921 Cornelison			5-17-68
0+00	127.3	118.85	8.4	0+00.0 = 11964 LINE NO. 1				C49956	2117 Hyacinth			6-17-75
1+00	124.8	119.25	5.5					C49955	2125 Hyacinth			6-17-75
	125.2	119.37	5.8	1+28 <sup>7</sup>								
LAT. 29, SUB. 3, S. S. NO. 22												
0+00	96.2	87.15	9.0	0+00 Exist'g MH								
1+00	95.9	87.35	8.5									
2+00	95.5	87.55	8.0		1+17 <sup>5</sup>							
	95.6	87.57	8.0	2+11 <sup>5</sup>								
3+00	95.5	87.75 87.62 out 88.03 in	7.7 7.6	3+85 <sup>5</sup>								
4+00	95.6											
5+00	96.9	88.25	8.6		5+51 <sup>9</sup>							
6+00	97.3	88.44	8.9	5+94 <sup>9</sup>								
7+00	96.6	88.65	8.0		7+26 <sup>9</sup>			9125 C-687	3430 S R Meridian		5-14-83 11/3/66	
8+00	97.3	88.85	8.4	8+50 <sup>5</sup>	top in MH			C688	3430 J Meridian			11-3-66