


LAT. 11, WESTLINK SEWER  
 W. B. CARTER CONST. CO. INC.  
 PROJ. NO. 24-29, BK NO. 250-Y  
 May 16, 1967

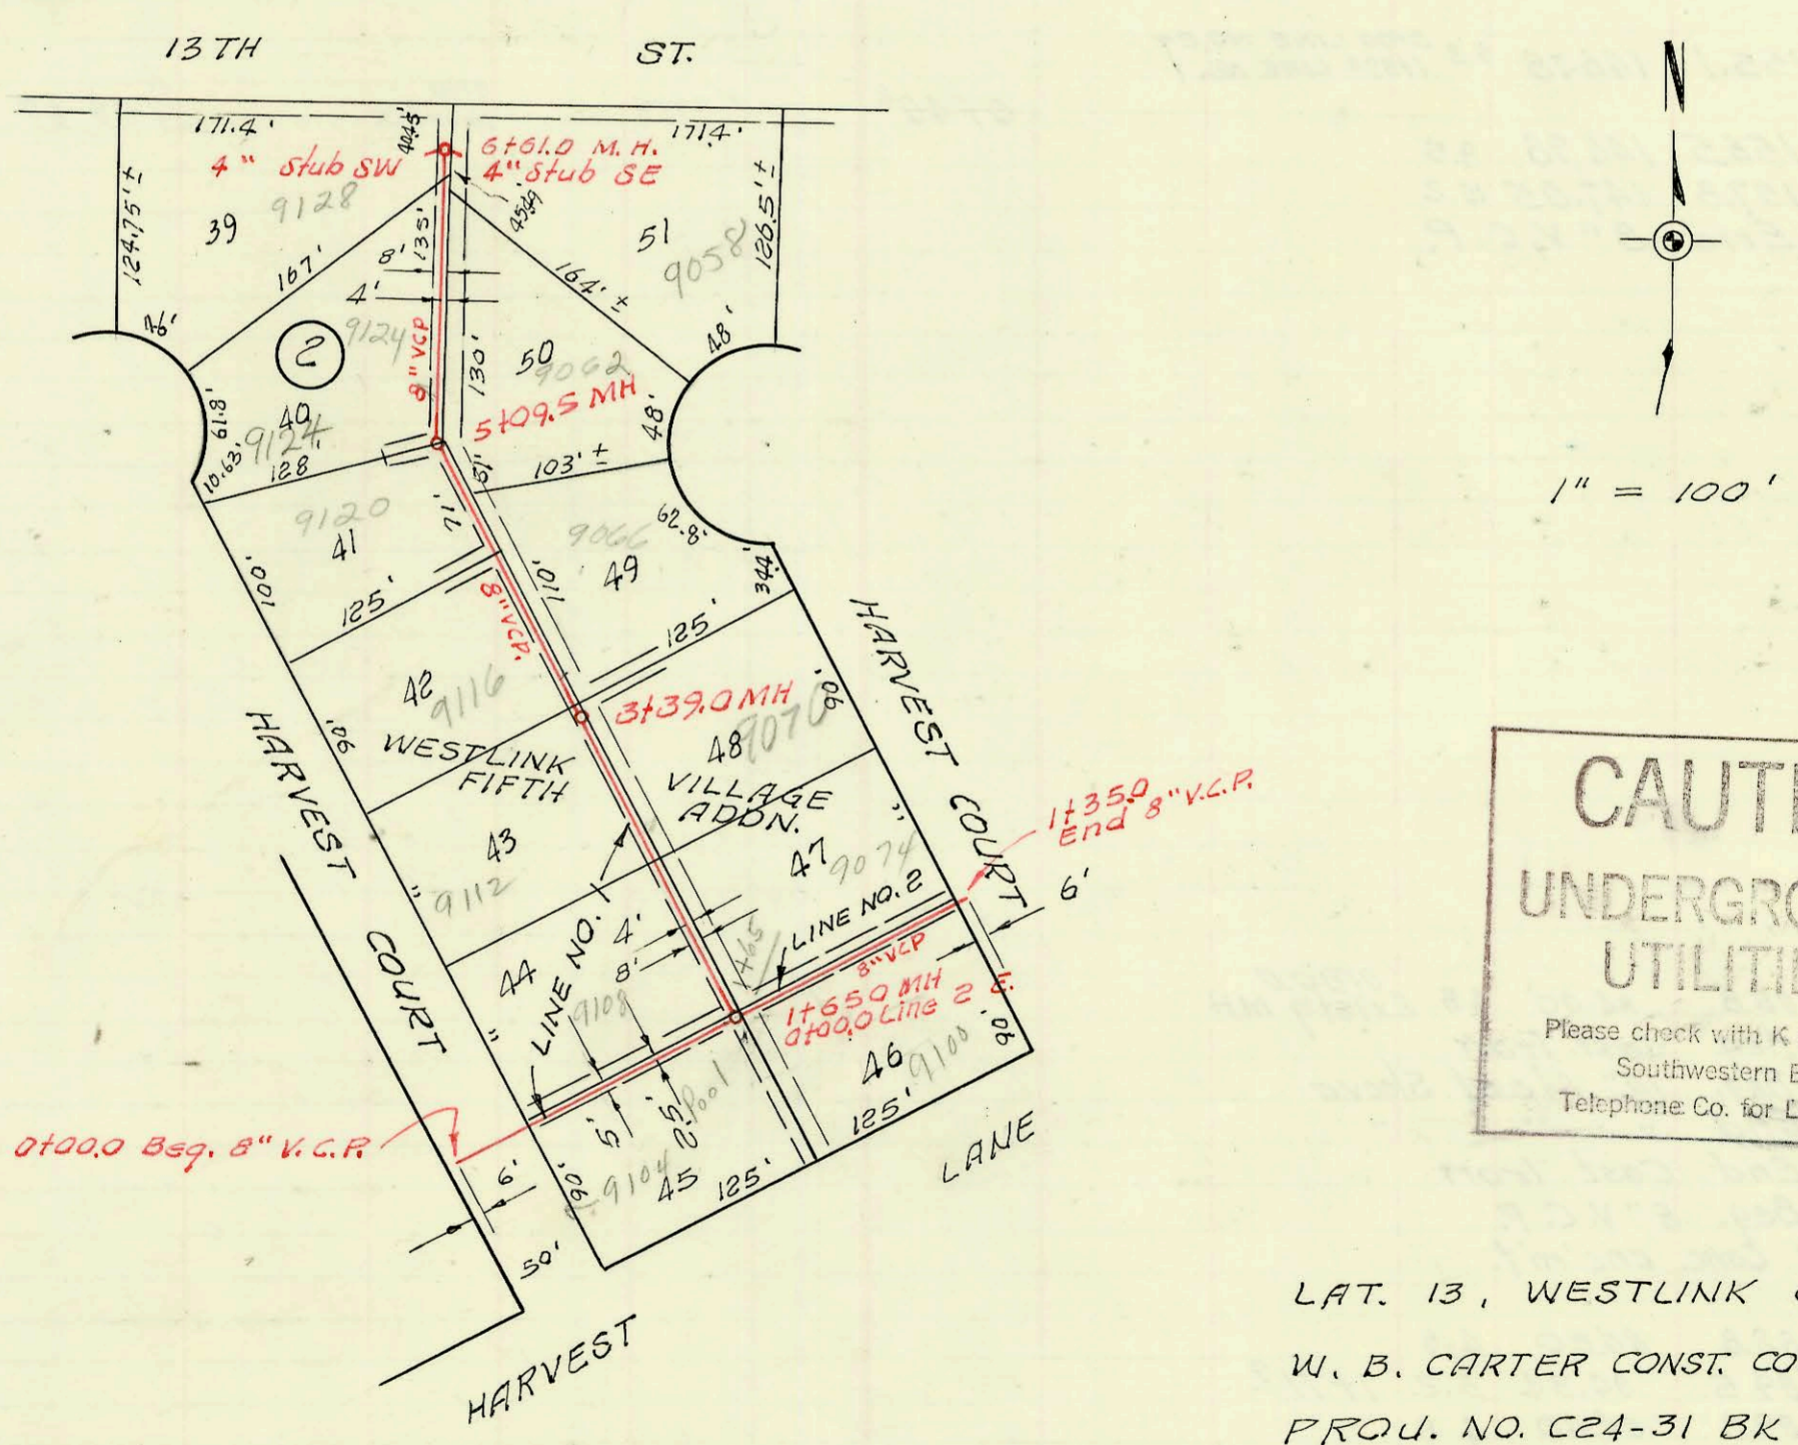

**CAUTION**  
 UNDERGROUND  
 UTILITIES

Please check with K G & E or  
 Southwestern Bell  
 Telephone Co. for Location

LAT. 13, WESTLINK SEWER  
 W. B. CARTER CONST. CO. INC.  
 PROJ. NO. C24-31 BK 250-Y  
 MAY 17, 1967

CONSTRUCTION RECORD

SERVICE RECORD

LINE NO. 1

STATION	ELEVATION		Depth	MANHOLE	4-INCH "Y" BRANCHES		No. of Permit		House Number		DATE OF PERMITS	
	Ground	Grade			North West	South East	North West	South East	North West	South East	North West	South East
0+00.0	Beq.	8" V.C.P.										
0+00.0	156.3	147.89	7.4									
1+00	157.2	148.19	9.0									
	158.0	148.37 out 148.47 in	9.6 9.5	1+60°	1+16°	1+18°						
2+00	158.0	148.58	9.4		1+96°	1+47°	C4625 C5864	9038 9030 R			9-7-67 11-27-67	
3+00	158.0	148.89	9.1		2+79°	2+77°	C5614	9042 R 9046			5-25-67 11-6-67	7-20-67
	158.1	149.01 out 149.11 in	9.1 9.0	3+42°								
4+00	158.2	149.29	8.9		3+69°	4+50°	C5613	9050 R 9054			6-9-67 11-6-67	8-4-67
						4+106°						
5+00	158.5	149.59	8.9		4+77°	4+79°	C5616				11-6-67	
	159.5	149.63 out 151.25 in	9.9 8.2	5+16°								
6+00	160.2	152.10	8.1									
	160.5	152.50	8.0	6+40°		4" stub S. E.		C4451	9018	Harvest Ct.		8-16-67

LINE NO. 2

0+00	158.0	150.50	7.5	0+00 LINE NO. 2 = 1+60° Line No. 1	0+33°	0+35°						
1+00	159.8	150.90	8.9									
2+00	161.0	151.30	9.7		2+46°	2+48°	C1395	9010	9006	Harvest Ct.	3-20-68	11-13-67
	161.2	151.60 out 151.70 in	9.6 9.5	2+74°								
3+00	161.1	151.80	9.3		3+78°	3+64°	C5720	9014	9004 R	Harvest Ct.		3-17-67 11-13-67
	160.7	152.20	8.5	3+99°		4" stub East		C4452	9000 R	Harvest Ct.		8-16-67 9-6-67

LAT. 13

WESTLINK SEWER

LINE NO. 1

0+00	Beq.	8" V.C.P.										
0+00	156.7	147.05	9.6									
1+00	156.6	147.25	9.3									
	156.2	147.38 out 147.48 in	8.8 8.7	1+65°	1+24°	1+26°	C3147	9108	9104	Harvest Ct.	5-18-67	5-18-67
2+00	156.3	147.55	8.7		2+75°	2+73°	C3146	9112	9070	Harvest Ct.	5-18-67	7-20-67
3+00	156.5	147.75	8.7		3+74°	3+72°	C3244	9116	9066	Harvest Ct.	5-24-67	8-25-67
	156.5	147.83	8.7	3+39°								
4+00	156.3	147.95	8.3		4+60°	4+82°	C8334	9120		Harvest Ct.	5-17-68	
5+00	155.8	148.17	7.6	5+09°								
6+00	155.7	148.53	7.2		5+18°	5+20°	C3318	9124	9062	Harvest Ct.	5-29-67	11-6-67
	156.0	148.77	8.2	6+61°	4" stub SW	4" stub SE	C4691	9128	9058	Harvest Ct.	8-31-67	8-25-67

LINE NO. 2

0+00	156.2	147.48	8.7	0+00 LINE NO. 2 = 1+65° Line No. 1	0+24°	0+26°	C3508	9074	9100	Harvest Ct.	6-13-67	7-18-67
1+00	156.2	147.78	8.4									
1+35°	156.3	147.89	8.4									
1+35°	End	8" V.C.P.										

2000-20711-9004 W Harvest Ln - 317100 - Padgett - 4" SCH 40, 2V22, 2H45 - City Repair

9000 W Harvest Lane (93-7487-7) 4.14-73 - Repair 12" - 4" SDR 40, PVC, 1-4" C.O. (41 house)