



SERVICE RECORD

CONSTRUCTION RECORD

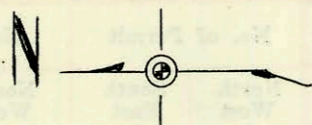

1" = 100'

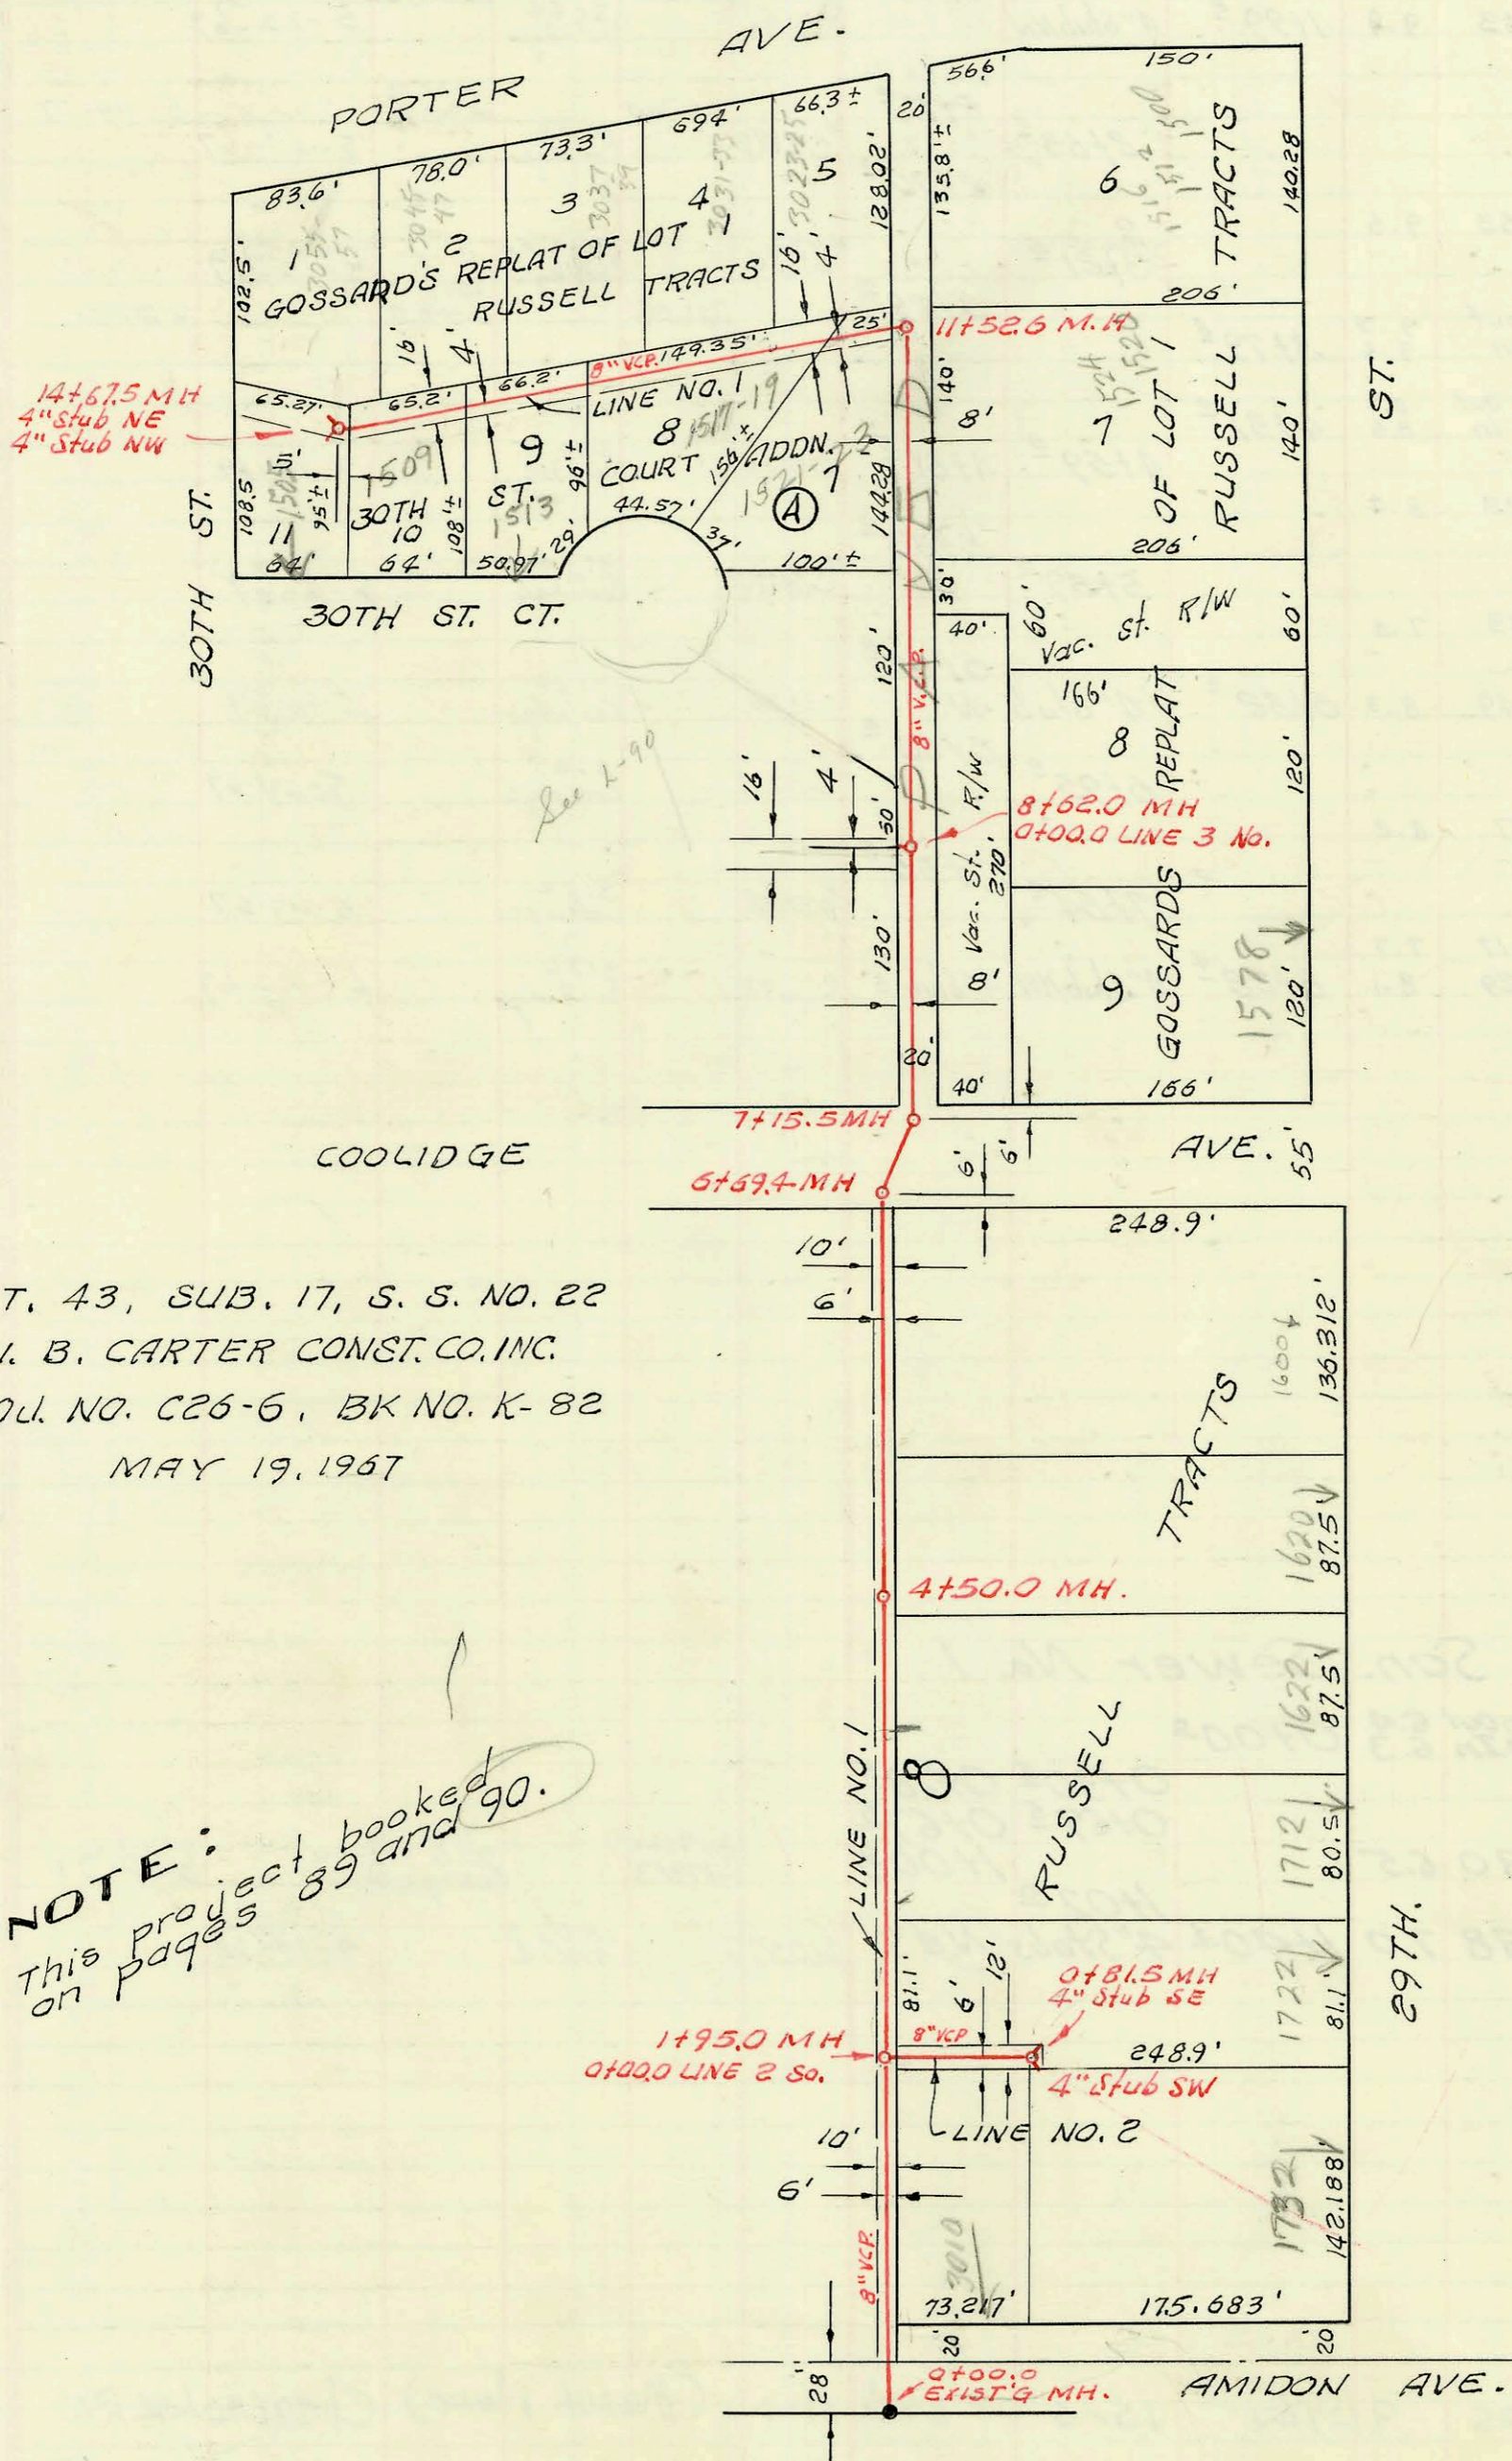

LAT. 43, SUB. 17, S. S. NO. 22
 W. B. CARTER CONST. CO. INC.
 PROJ. NO. C26-6, BK NO. K-82
 MAY 19, 1967

NOTE:
 This project booked
 on pages 89 and 90.

