
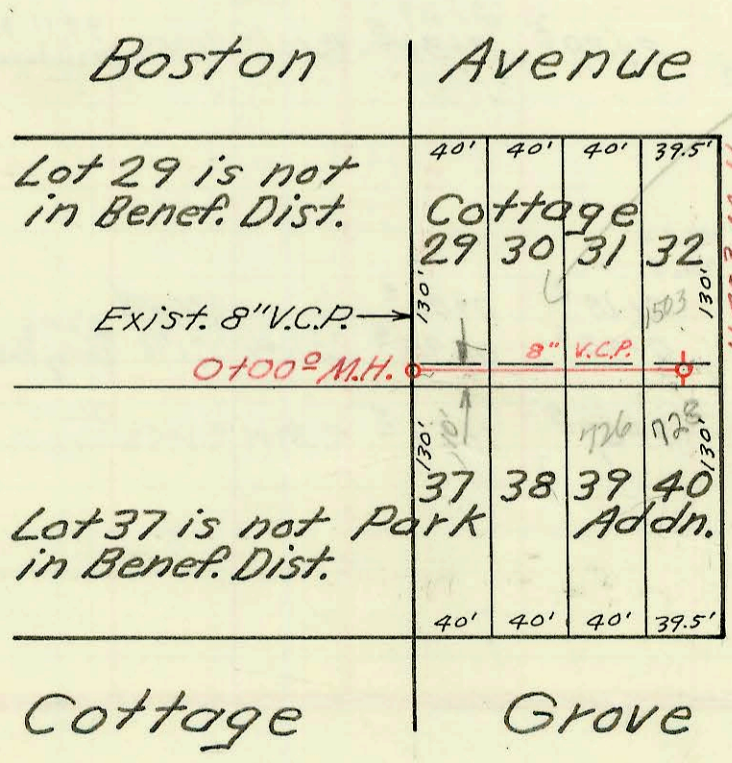


LAT. 43, SUB. 17, S.S. NO. 22
 PROJ. NO. C26-6

1525 W 30th
 Manuf house
 Trap req'd

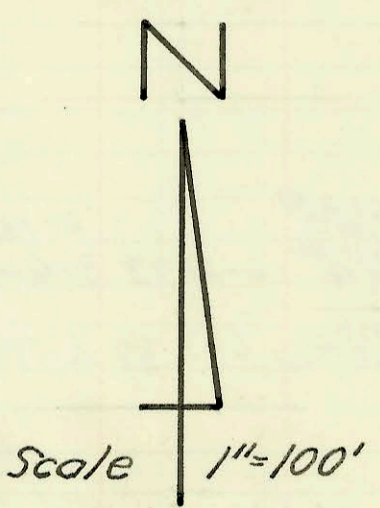

1440² M.H. 4' STUBS N. & S.
 A-213
 Mead Ave.

Lateral 11, S.S. No. 1
 Mid-States Const. Co., Inc. June 26, 1968
 Proj. No. C 27-45, Booked 7-1-68, Bk. IH-6

CONSTRUCTION RECORD

SERVICE RECORD

STATION	ELEVATION		Depth	MANHOLE	4-INCH "Y" BRANCHES		No. of Permit		House Number		DATE OF PERMITS	
	Ground	Grade			North West	South East	North West	South East	North West	South East	North West	South East
0+00	127.8	118.03	9.8	0+00.0 LINE NO. 3 = 8+62.0 LINE NO. 1	0+26°		C3079		3026		5-15-67	
					0+83°	0+33°	C3080	3032	5-15-67			
1+00	127.9	118.23	9.7		1+38°	1+62.3°	#C3911	3038	1523-35	1523 St	7-12-67	5-16-77
2+00	128.3	118.43	9.9	1+99°	4" Stub NW	2+31.2°	#C3190	3044			5-22-67	
					2+63°	2+11°	C61295	3050	1537-39	1537 St	5-22-67	5-24-77
3+00	128.2	118.63	9.6		3+21°	3+29°	#C3189	3056			1-22-92	5-22-67
					4+59°	4+61°	C15032	3100	1545	1530 St	7-22-69	2-24-89
4+00	128.3	118.79 out	9.5	3+79°								
		118.89 in			9.4							
5+00	127.6	118.99 out	8.7	4+31°								
		119.09 in			8.6							
6+00	127.2	119.23	8.4		5+59°	5+33°	C3428	3110			6-6-67	
					6+08°	6+108°	C3050	3120			5-11-67	
7+00	127.8	119.49	8.3	6+32°	4" Stub W.	6+88°	C3257	3128			5-24-67	
					6+95°	7+56°	C3258	3132			5-24-67	
8+00	127.9	120.17	7.7	8+28°								
		120.29			8.1	4" Stub NW	4" Stub E	C3678	3136			6-22-67

Lateral 1 1/2 San. Sewer No. 1

0+00	103.4	97.00 out 97.10 in	6.4 6.3	0+00°	0+30°	0+28°						
1+00	103.8	97.30	6.5	1+02°	0+69°	0+67°	72-73267	726-31			5-19-77	2-9-70
					1+40°	4" Stubs N&S	C17913	1503	meat	9-19-68		

Sept 2004-02625 9/27/04 1525 W 30th St N (Manuf Home) Clearwater FL