




WICHITA VALLEY CENTER FLOOD CONTROL R/W

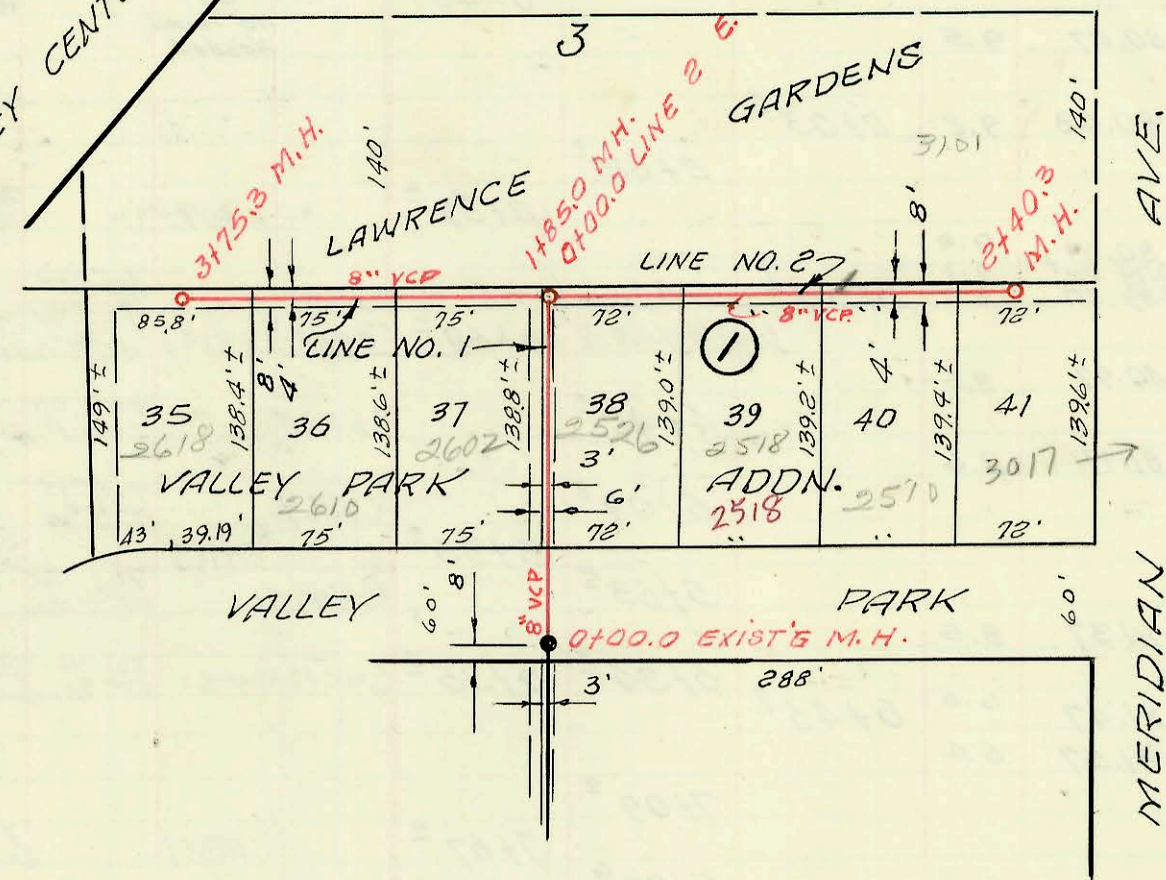

LAT. 33, SUB. 17, S. S. NO. 22
 UTILITIES CONTRACTORS INC.
 PROJ. NO. C23-123, BK. # K-77
 MAY 29, 1967

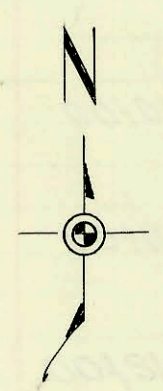

1" = 100'

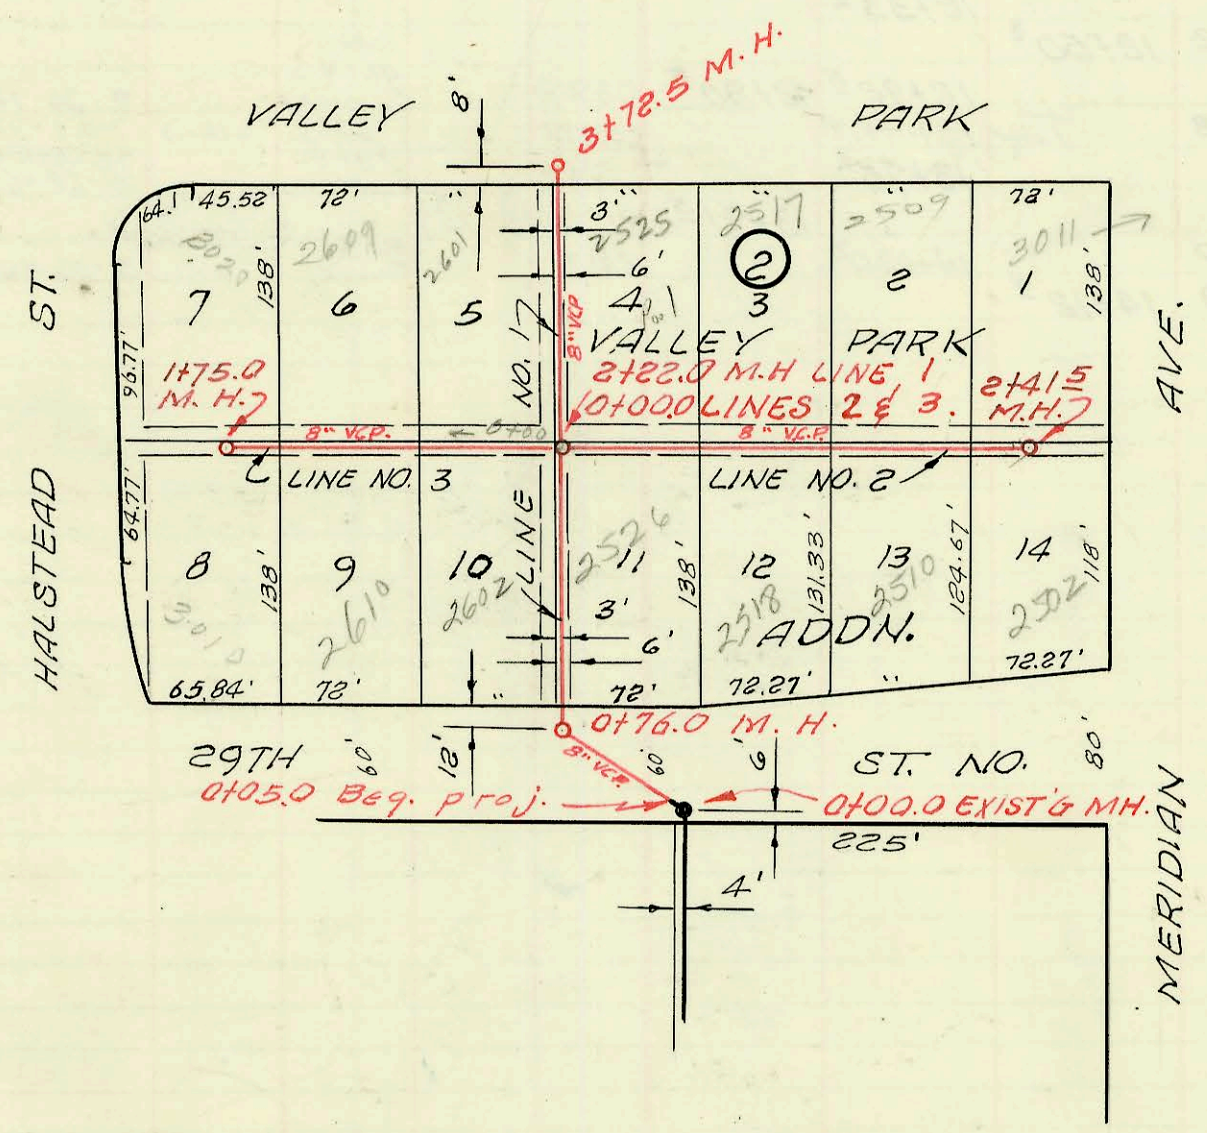

LAT. 34, SUB. 17, S. S. NO. 22
 UTILITIES CONTRACTORS INC.
 PROJ. NO. C23-124, BK. NO. K-77
 MAY 29, 1967

