


CENTRAL AVE.


L 100. A

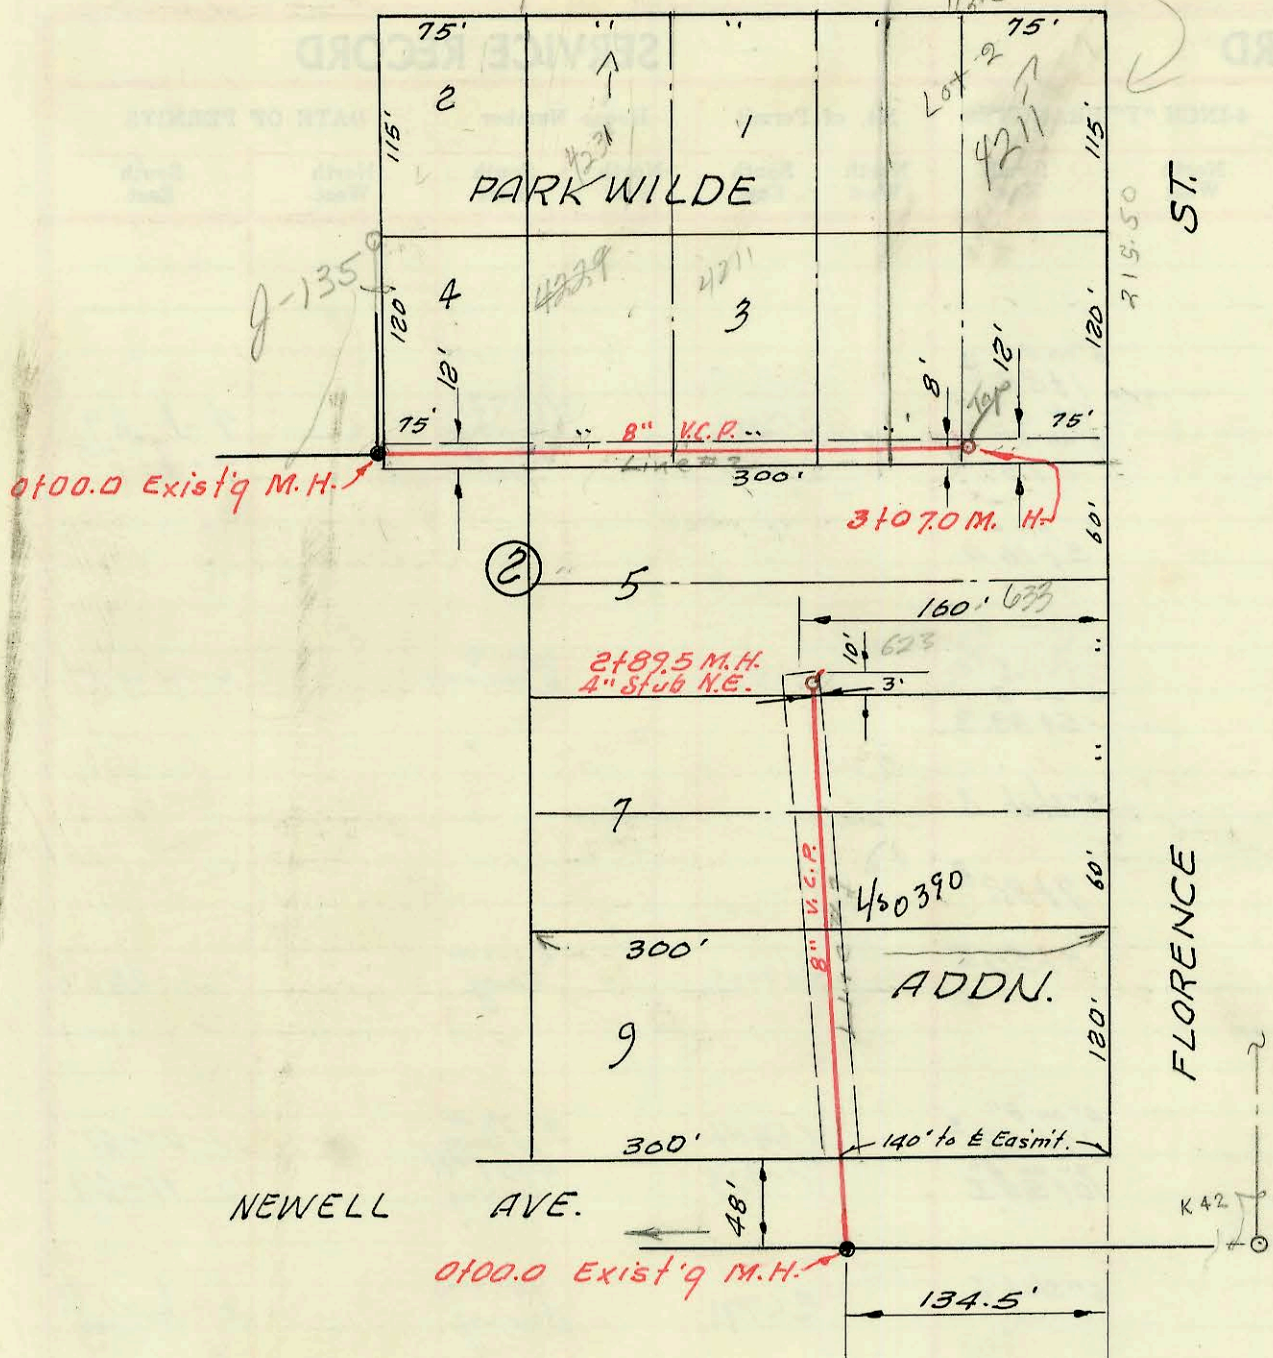

LAT. 178, SUB. 5, S. S. NO. 22
 MID-STATES CONST. CO. INC.
 PROJ. NO. C24-5 BK. J. K. # 4
 7-13-67

NEWELL AVE.

500 K-42

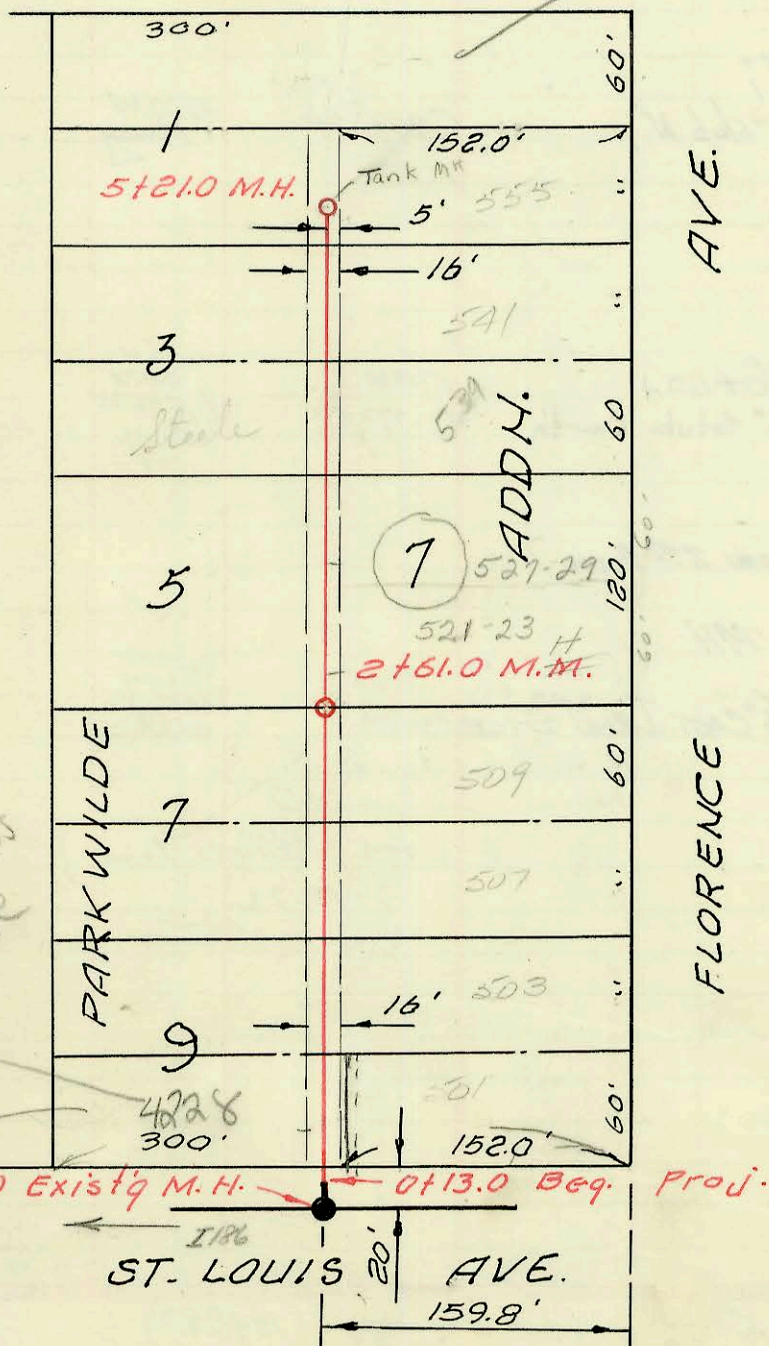

4228 W. ST. LOUIS
 Manuf. House
 Trapage
 Lot Split
 ADD L for SMT
 5/22/60
 6/11/64

LAT. 152, SUB. 5, S. S. NO. 22
 MID-STATES CONST. CO. INC.
 PROJ. NO. C20-39 BK. J. K. # 4
 7-13-67

CONSTRUCTION RECORD

SERVICE RECORD

LINE NO. 1

LINE NO. 2

STATION	ELEVATION		Depth	MANHOLE	4-INCH "Y" BRANCHES		No. of Permit		House Number		DATE OF PERMITS	
	Ground	Grade			North West	South East	North West	South East	North West	South East	North West	South East
0+00	121.5	115.06	6.4	0+00.0 Exist'g M.H.								
1+00	121.6	116.02	5.6		0+69 ²	0+67 ²						
2+00	122.0	116.98	5.0		1+19 ²	1+17 ²						
					1+94 ²							
					2+02.9							
					2+47 ²	2+45 ²						
	120.9	117.84	3.1	2+89 ⁵	4" stub NE							
0+00	120.7	115.63	5.1	0+00.0 Exist'g M.H.								
1+00	119.9	115.83	4.1		0+31 ²	0+33 ²						
					0+81 ²	0+86 ²						
					1+31.0 ^{TAP}							
					1+59 ²	1+61 ²						
2+00	120.2	116.03	4.2		2+39 ²							
					2+61.0 ^{TAP}	2+67 ⁵						
					2+96 ⁵							
3+00	120.9	116.24	4.7	3+07 ²								
0+00	119.7	112.79	6.9	0+00.0 Exist'g M.H.								
0+13.0	Beq. proj.				0+40 ²	0+57 ²						
1+00	118.6	113.09	5.5		1+04 ²	1+06 ²						
					1+59 ²	1+59 ²						
2+00	119.1	113.39	5.7		2+19 ²							
					2+46 ²							
	119.2	113.57	5.6	2+61 ²	2+81 ²	2+79 ²						
3+00	119.1	113.69	5.4		3+39 ²	3+37 ²						
4+00	119.8	113.99	5.8		4+10 ²	4+08 ²						
					4+51 ⁵	4+53 ⁵						
5+00	120.3	114.29	6.0		5+10 ²	5+08 ⁵						
	120.5	114.35	6.1	5+21 ²								

