
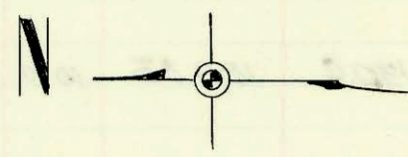


INTERSTATE HIGHWAY NO. 235

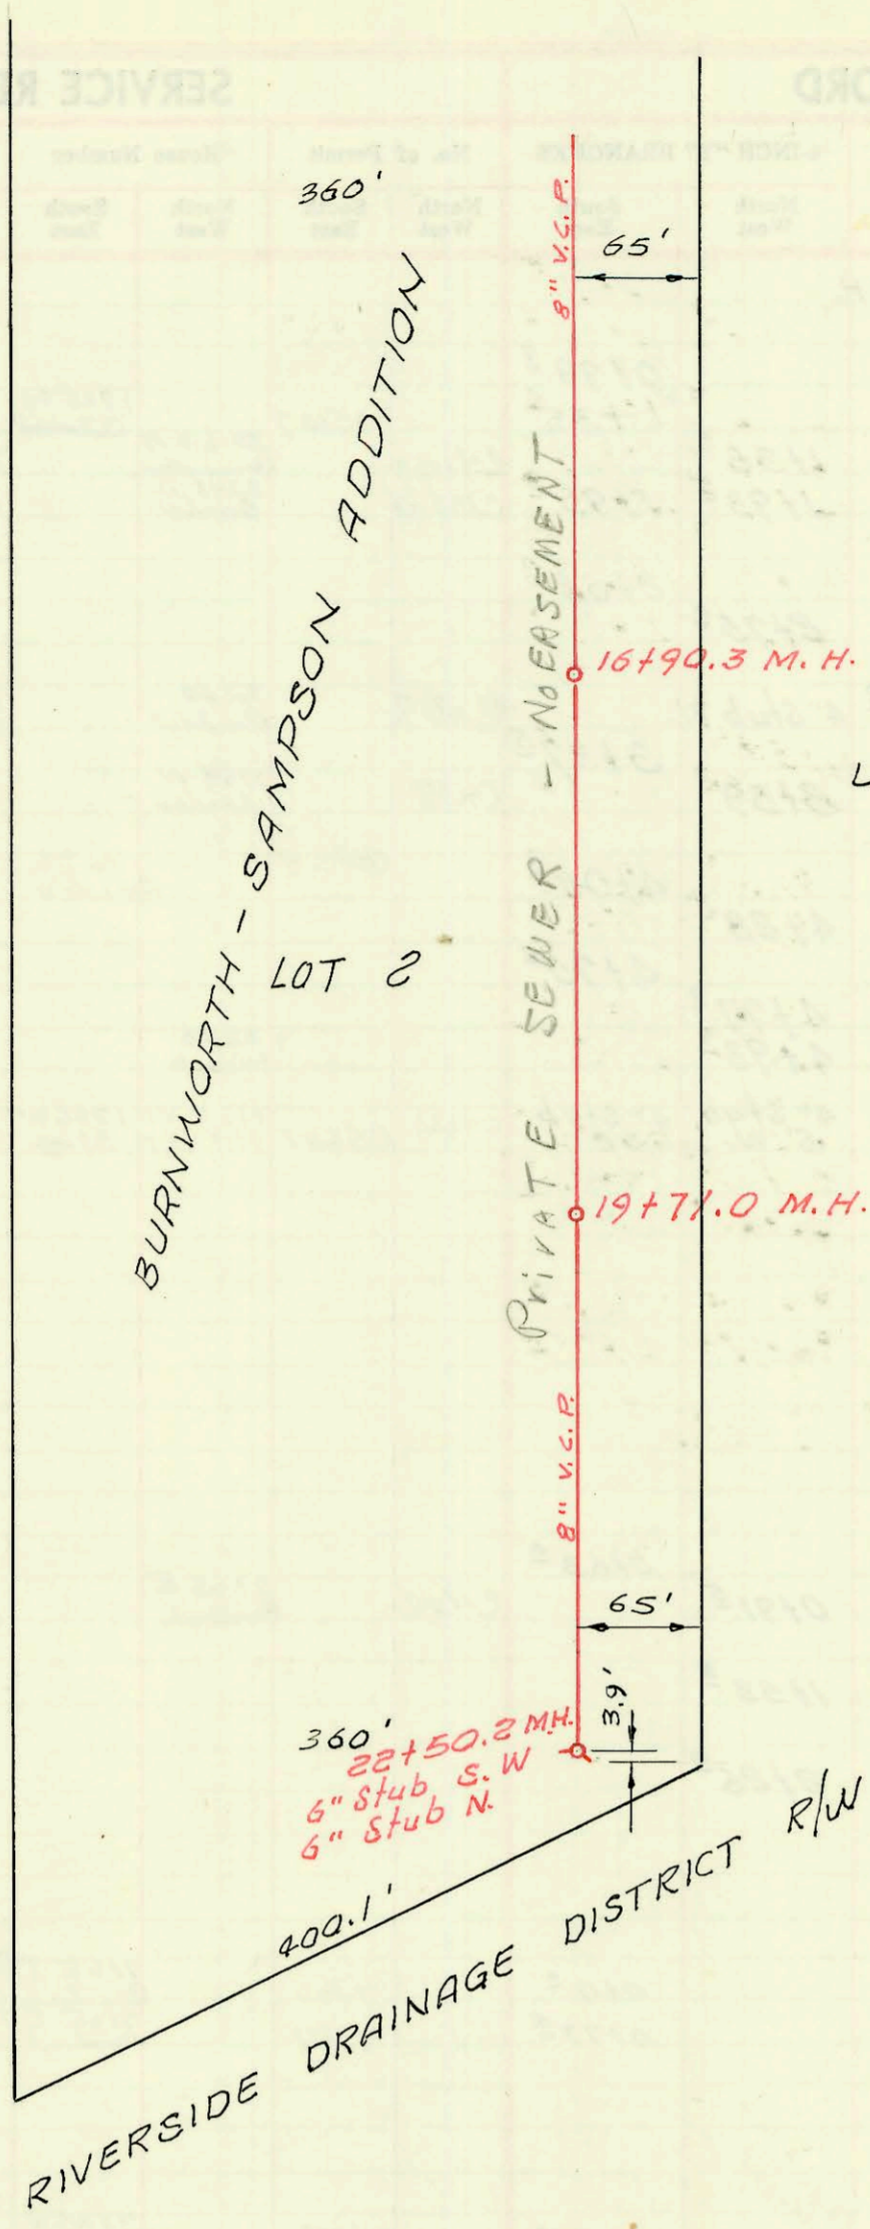

LAT. 2, SUB. 1, GLENVILLE SEWER

NOTE: All 6" "Y" Branches.

MAC ARTHUR RD.

SENECA ST.

RIVERSIDE DRAINAGE DISTRICT R/W

BURNWORTH - SAMPSON ADDITION  
LOT 2

360'  
22+50.2 M.H.  
6" Stub S.W  
6" Stub N.

8" V.S.P.  
65'  
16+90.3 M.H.  
19+71.0 M.H.  
8" V.S.P.  
65'  
3.9'

SERVICE RECORD

CONSTRUCTION RECORD

SERVICE RECORD		CONSTRUCTION RECORD			
DATE OF PERMIT	ISSUE NUMBER	STATION	ELEVATION	DIAMETER	REMARKS
		0+00			
		0+10			
		0+20			
103

CONSTRUCTION RECORD						SERVICE RECORD						
STATION	ELEVATION		Depth	MANHOLE	6-INCH "Y" BRANCHES		No. of Permit		House Number		DATE OF PERMITS	
	Ground	Grade			North West	South East	North West	South East	North West	South East	North West	South East
15+00	89.7	86.74	3.0		14+62 <sup>o</sup>	14+15 <sup>s</sup> 14+64 <sup>o</sup>						
16+00	89.8	86.89	2.9		15+05 <sup>s</sup> 15+49 <sup>o</sup> 15+87 <sup>s</sup>	15+07 <sup>s</sup> 15+51 <sup>o</sup> 15+89 <sup>s</sup>						
17+00	90.2	87.03	3.2	16+90 <sup>z</sup>	16+41 <sup>o</sup> 16+75 <sup>o</sup>	16+43 <sup>o</sup> 16+77 <sup>o</sup>						
18+00	90.0	87.19	2.8		17+28 <sup>s</sup> 17+72 <sup>s</sup>	17+30 <sup>s</sup> 17+74 <sup>s</sup>						
19+00	90.1	87.34	2.8		18+16 <sup>o</sup> 18+64 <sup>s</sup>	18+18 <sup>o</sup> 18+66 <sup>s</sup>						
20+00	90.5 90.5	87.45 87.49	3.1 3.0	19+71 <sup>a</sup>	19+08 <sup>s</sup> 19+51 <sup>s</sup>	19+10 <sup>s</sup> 19+53 <sup>s</sup>						
21+00	90.9	87.64	3.3		20+00 <sup>o</sup> 20+43 <sup>s</sup> 20+82 <sup>o</sup>	20+02 <sup>o</sup> 20+45 <sup>s</sup> 20+84 <sup>o</sup>						
22+00	91.3 91.4	87.79 87.87	3.5 3.5	22+50 <sup>o</sup>	21+31 <sup>o</sup> 21+75 <sup>o</sup>	21+33 <sup>o</sup> 21+77 <sup>o</sup>						
						6" stub S.W. 6" stub N.						

L