

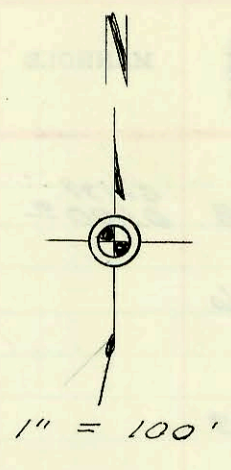


8" stub North
SUNNYBROOK
13103± M.H.

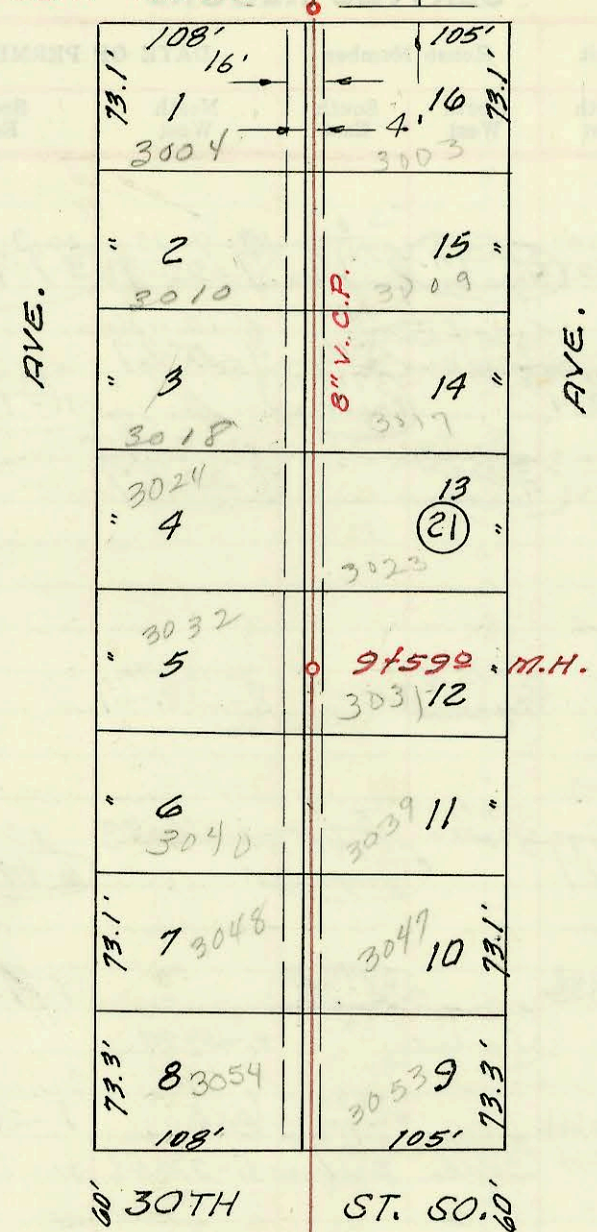

LAT. 69, S. S. NO. 22
 UTILITY CONTRACTORS INC.
 PROJ. NO. C29-41 BK. J.K. #4
 AUG. 11, 1967

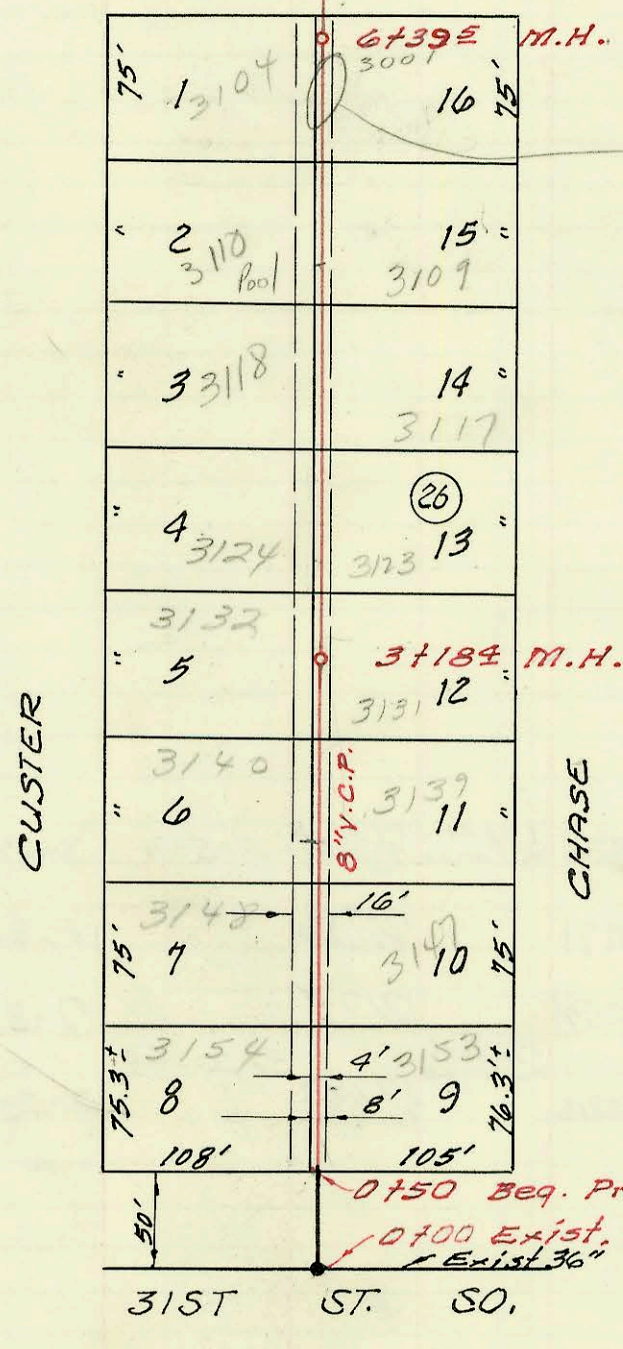

See
sewer Agreement

0150 Req. Proj.
 0100 Exist. M.H.
 Exist 36"

31ST ST. SO.

