


CONSTRUCTION RECORD



Scale 1" = 100'

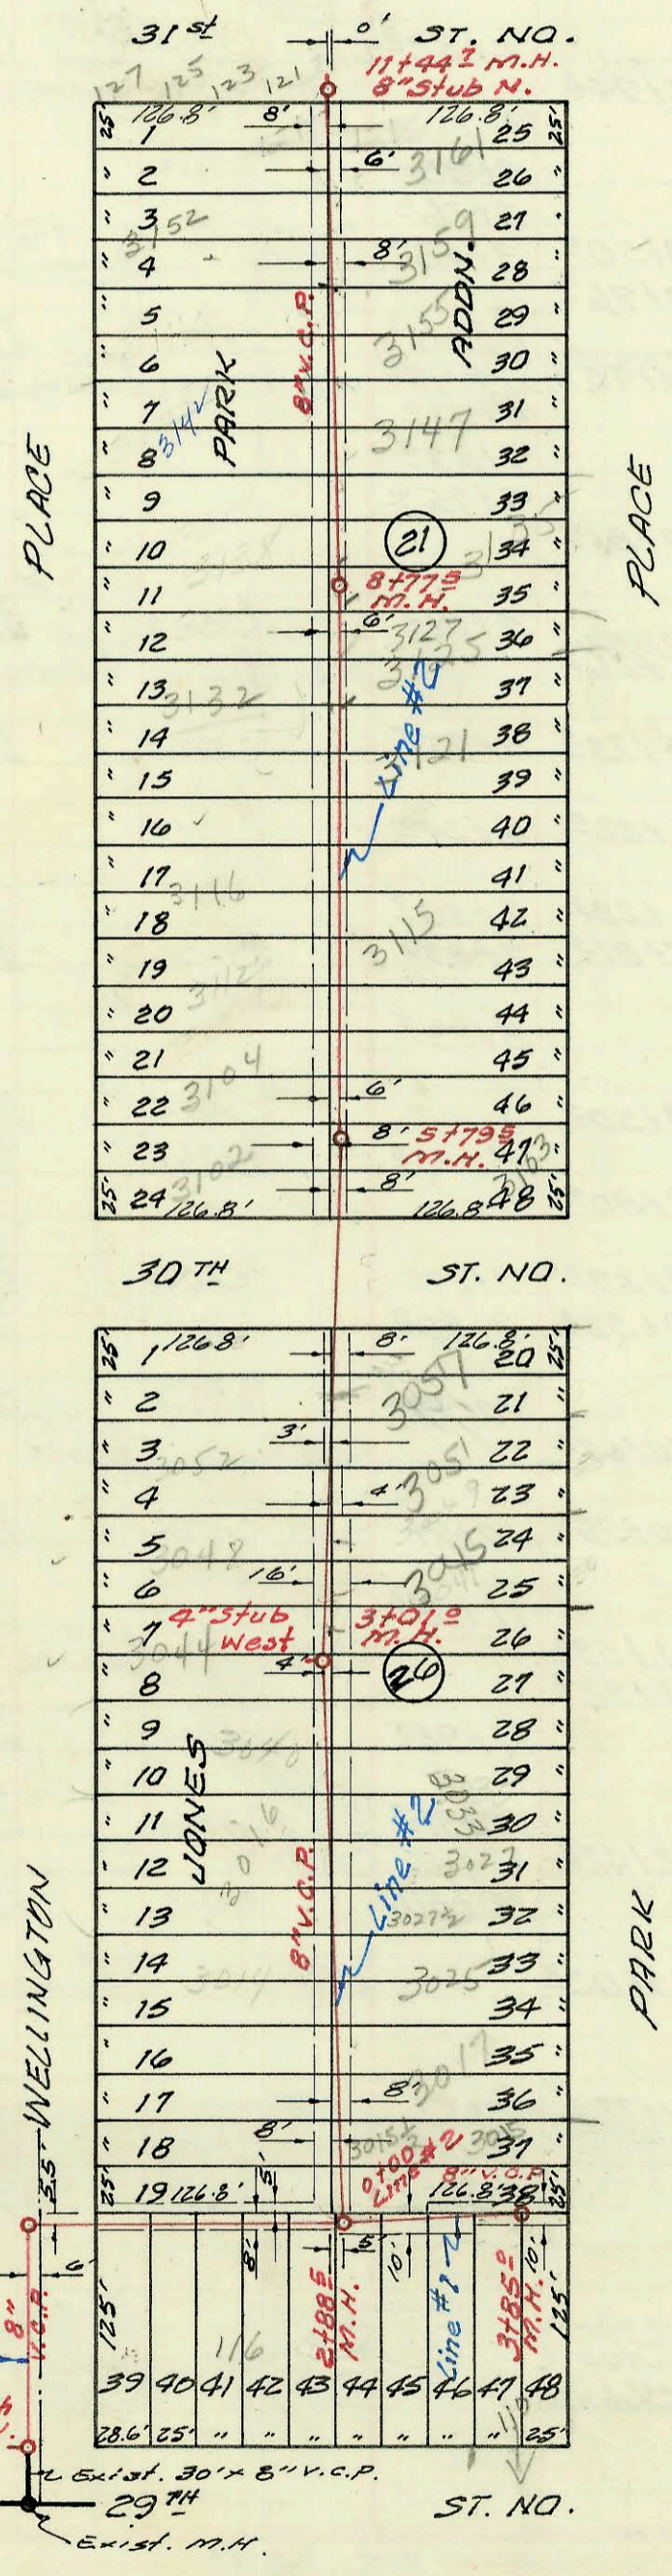

LAT. 29, DIST. T., S.S. 20
 W. B. CARTER CONST. CO. 8-11-67
 PROJ. NO. C22-32 K-76-A BOOKED 8-17-67
 THIS PROJ. COMPLETED 8-11-67

26.53
 95.0

