


SERVICE RECORD CONSTRUCTION RECORD

STATION	ELEVATION	MANHOLE	PIPE #	DIAMETER	LENGTH	DATE OF RECORD
---------	-----------	---------	--------	----------	--------	----------------



Scale 1" = 100'

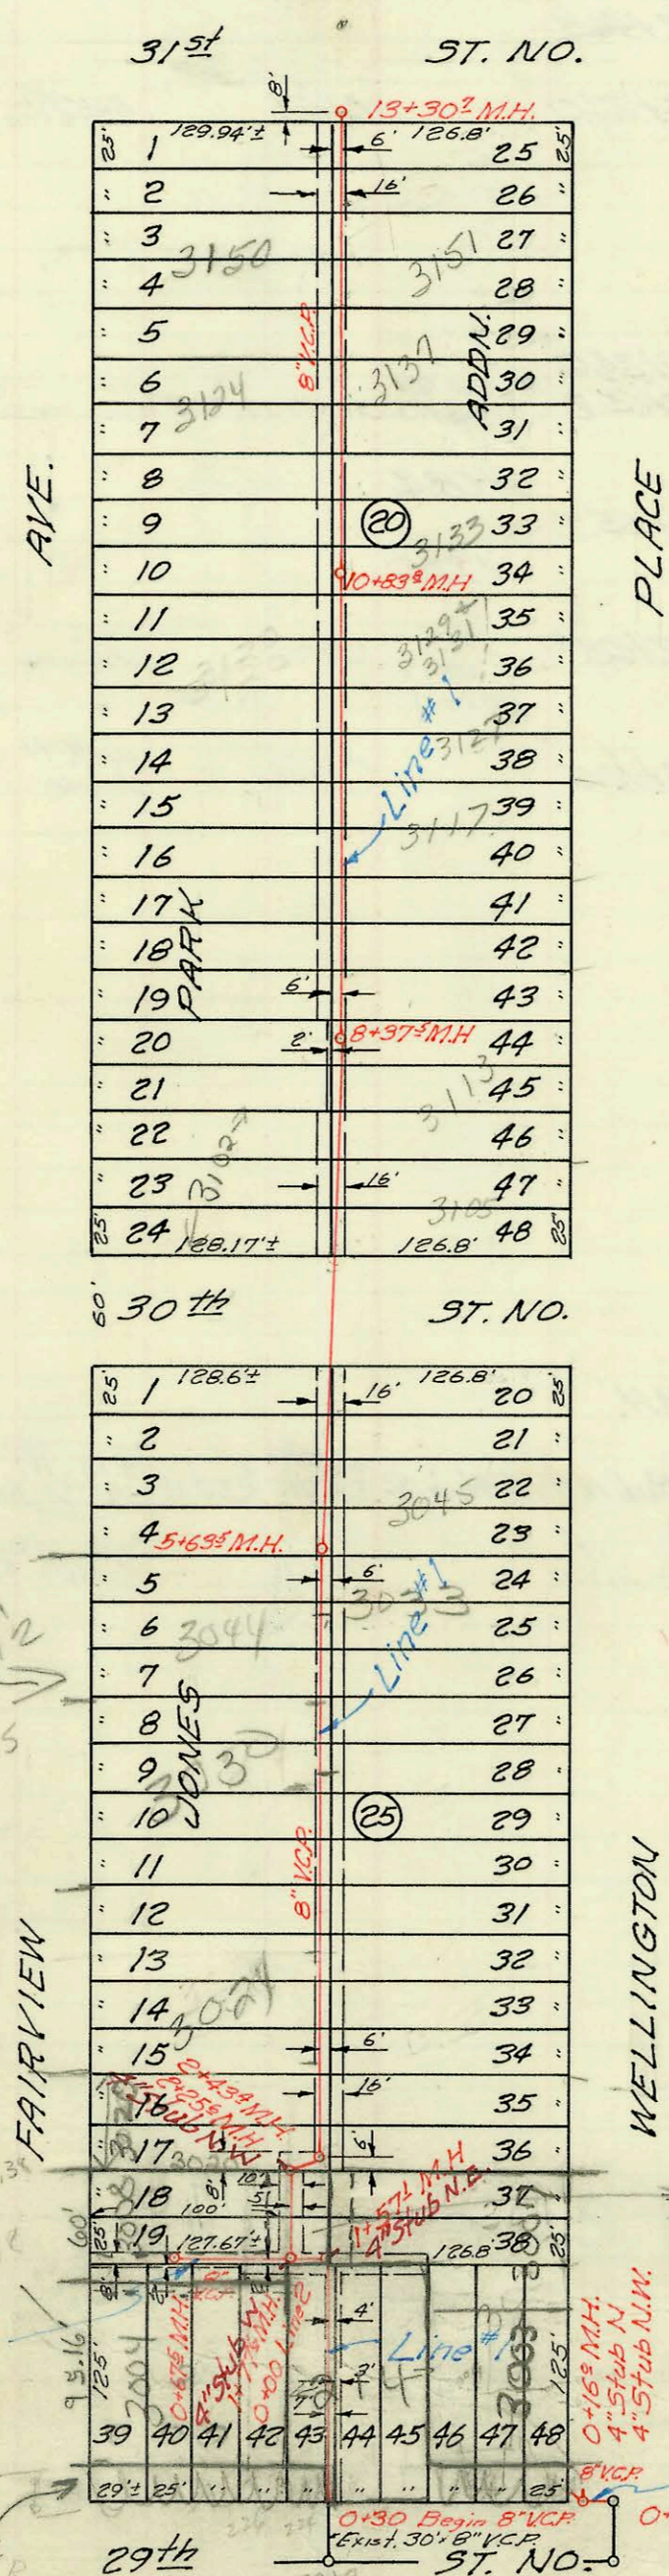

LAT. 30, DIST. T., S. 5. 20
 UTILITY CONTRACTORS INC. AUG. 1967
 PROJ. NO. C22-33 K-83A BOOKED 8-18-67

9-28
 Replat
 Trachtman
 Add
 Covers
 Lots 5-15

9-26
 Trachtman Add
 Lot 3 covers
 Lots 18, 19, 37, 38
 39-43 and
 46-48

43' Util. Easement
 33' on Trachtman 2nd
 and 10' on Jones Park Add

20' Right of Way
 Dedicated
 by Trachtman Add

