



LAT. 197, SUB. 5, S. S. NO. 22  
 W. B. CARTER CONST. CO. INC.  
 PROJ. NO. C27-38, BK. J. K# 6  
 5-9-68

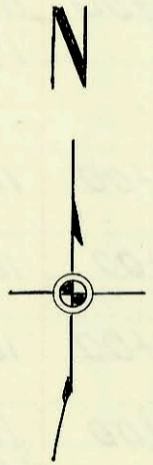

1" = 100'

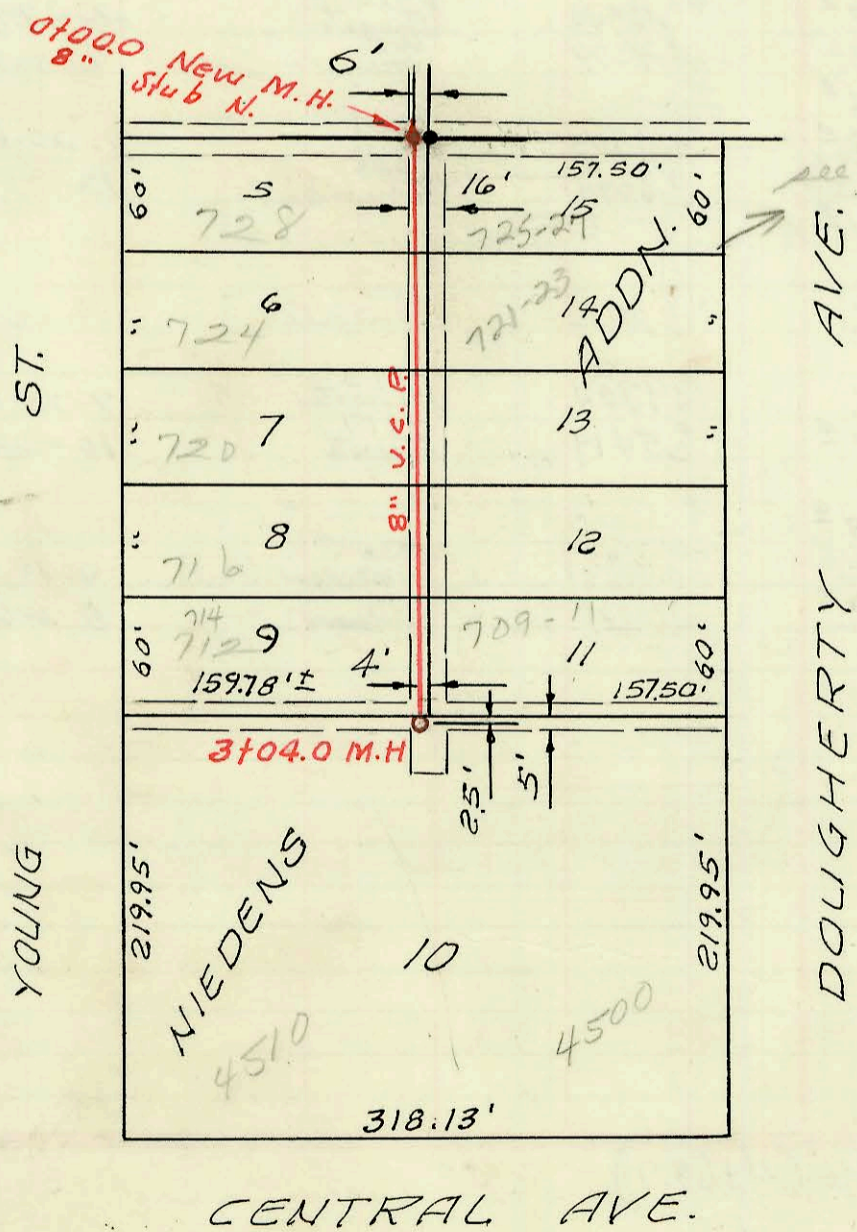

LAT. 196, SUB. 5, S. S. NO. 22  
 UTILITY CONTRACTORS INC.  
 PROJ. NO. C27-37, BK. J. K# 9  
 NOV. 3 1967

CONSTRUCTION RECORD						SERVICE RECORD						
STATION	ELEVATION		Depth	MANHOLE	4-INCH "Y" BRANCHES		No. of Permit		House Number		DATE OF PERMITS	
	Ground	Grade			North West	South East	North West	South East	North West	South East	North West	South East
0+00 0+02°	122.4	112.62	9.8	0+00.0 EXIST'G M.H.								
	Beq.	Proj.			0+36 <sup>s</sup> 0+83 <sup>s</sup>	0+34 <sup>s</sup>	C9167 C9168		7327 Young 7367 Young		6-18-68 6-18-68	
1+00	121.7	113.02	8.7			1+30 <sup>e</sup> 1+68 <sup>e</sup>	C9169		7407 Young		6-18-68	
2+00	121.4	113.42	8.0			1+90 <sup>e</sup> 2+33 <sup>e</sup>	C12918		7447 Young		2-26-69	
	121.5	113.62	7.9	2+54 <sup>e</sup>								
0+00	122.1	113.84'	8.3	0+00.0 NEW M.H.	8" Stub N.							
					0+07 <sup>e</sup> 0+62 <sup>e</sup>	0+09 <sup>e</sup> 0+64 <sup>e</sup>	C7177 C5602		7287 Young 784		3-6-68 11-3-67	
1+00	122.3	114.24	8.1		1+26 <sup>e</sup> 1+85 <sup>e</sup>	1+28 <sup>e</sup> 1+87 <sup>e</sup>	C5605 C5604	C36453 C24875	730 Young 710 Young	721-23 Dougherty 717-19 Dougherty	12-26-72 11-3-67 11-3-67	6-11-71
2+00	122.8	114.64	8.2		2+44 <sup>e</sup>	2+46 <sup>e</sup>	C182480	C24875	712-14 N. Young 4510 <sup>W</sup> Central	713-15 Dougherty	3-4-70 5-19-71	6-11-71
3+00	123.3	115.05	8.2	3+04 <sup>e</sup>	M.H. Tap		C24449 C18802		4500 W. Central		4-14-70	

C 53282 - 709-11 71. Dougherty - Danell Hill - 1-20-76 Tap (2+93)