


Lateral 43, War Industries Sewer  
 Utility Contractors, Inc. 6-28-68  
 Proj. No. C 27-66, Booked 7-2-68, Bk. I.H. 3



Lateral 15, Sub. 12, War Industries Sewer  
 W.B. Carter Const. Co., Inc. Sept. 1968  
 Private Contract Bk. I.H. 62 9-18-68

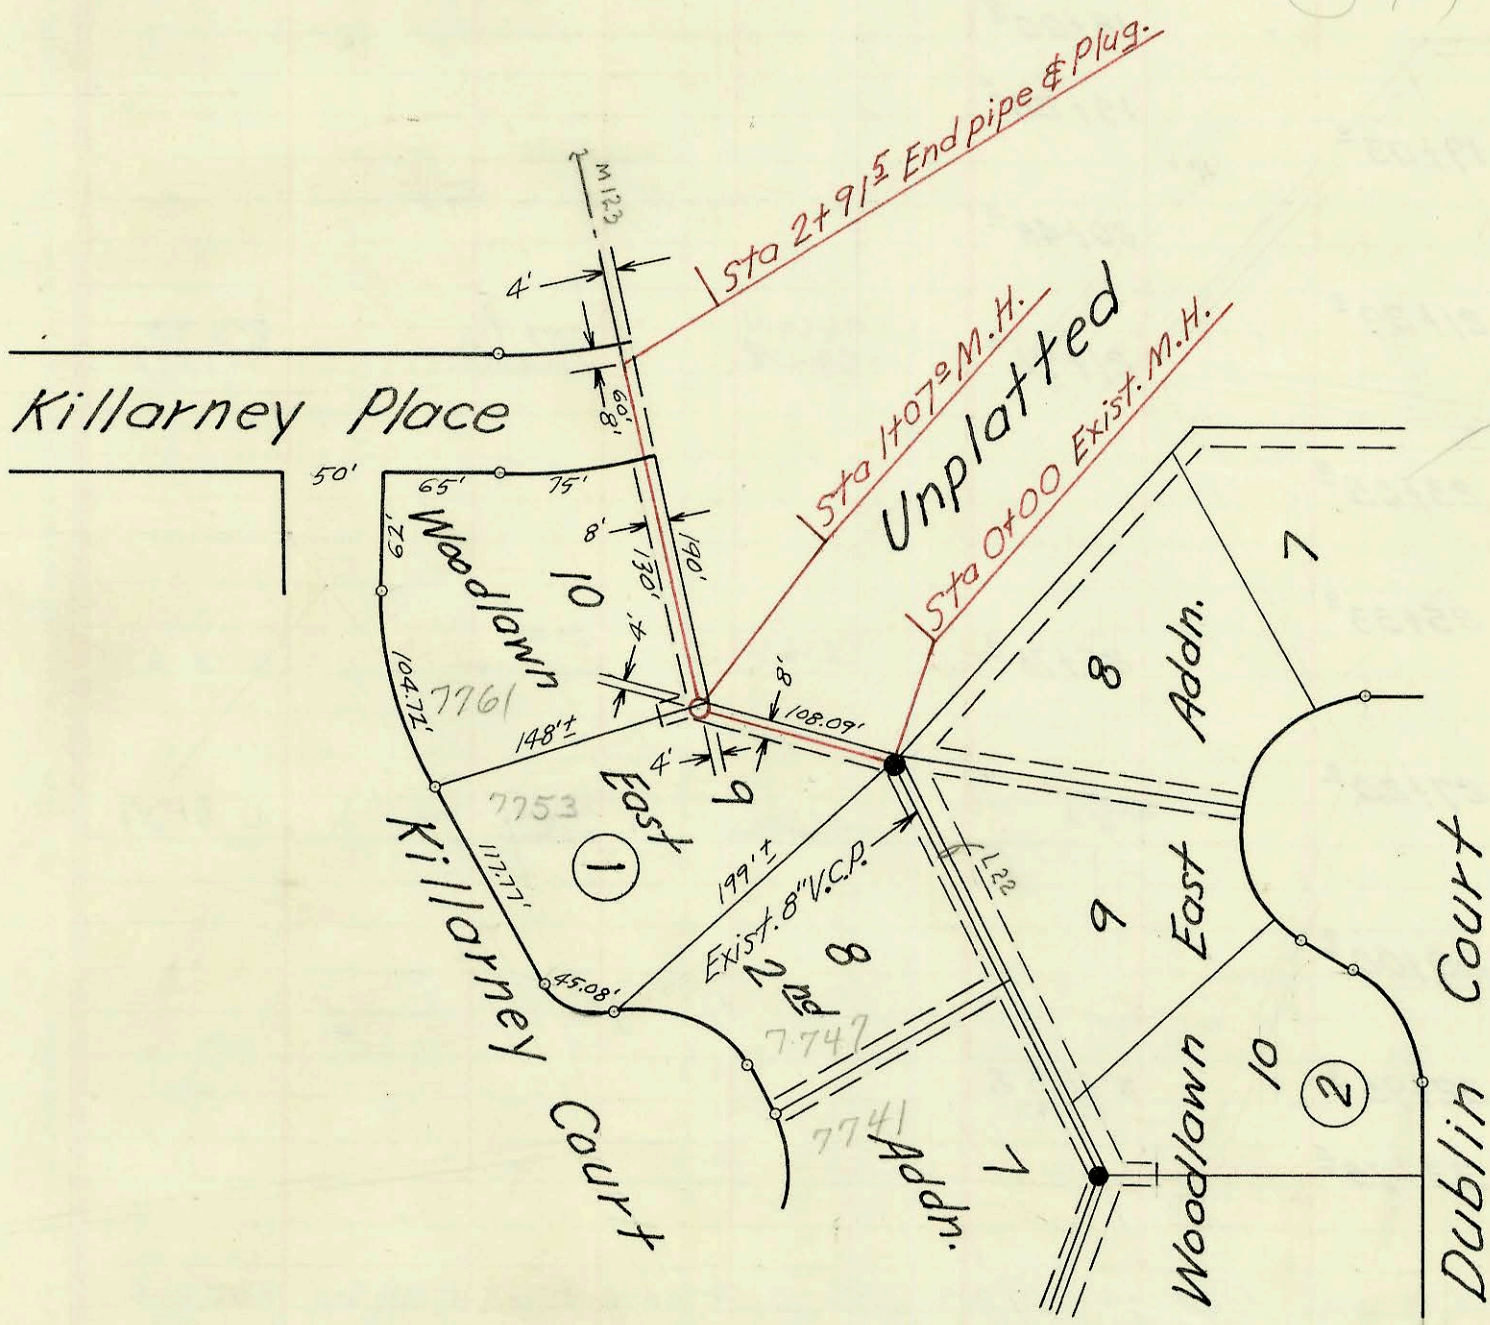