


LAT. 28, SUB. 10, S. S. NO. 22
 UTILITY CONTRACTOR INC.
 PROJ. NO. C 26-54, BK. J.A.K. 10
 Nov. 15, 1967

Alley West of Lot 37 Thru 60 INC. Vacated.
 PUE Retained. Vac Ord #33-231

S.S. Abandonment in Lots 1+2
 Case 1 2nd Addn. (Autozone)
 Proj. No. 770PPS
 Built By Mies Const.
 5/18/98 from As-Built Plan

Date with W.B. Carter
 advised me on 3/27/98 that
 this title has been abandoned
 back to MH str 2799.6.
 waiting on Release that
 City Eng. is sufficient
 price to issue permit
 for Autozone
 BK
 3-27-97

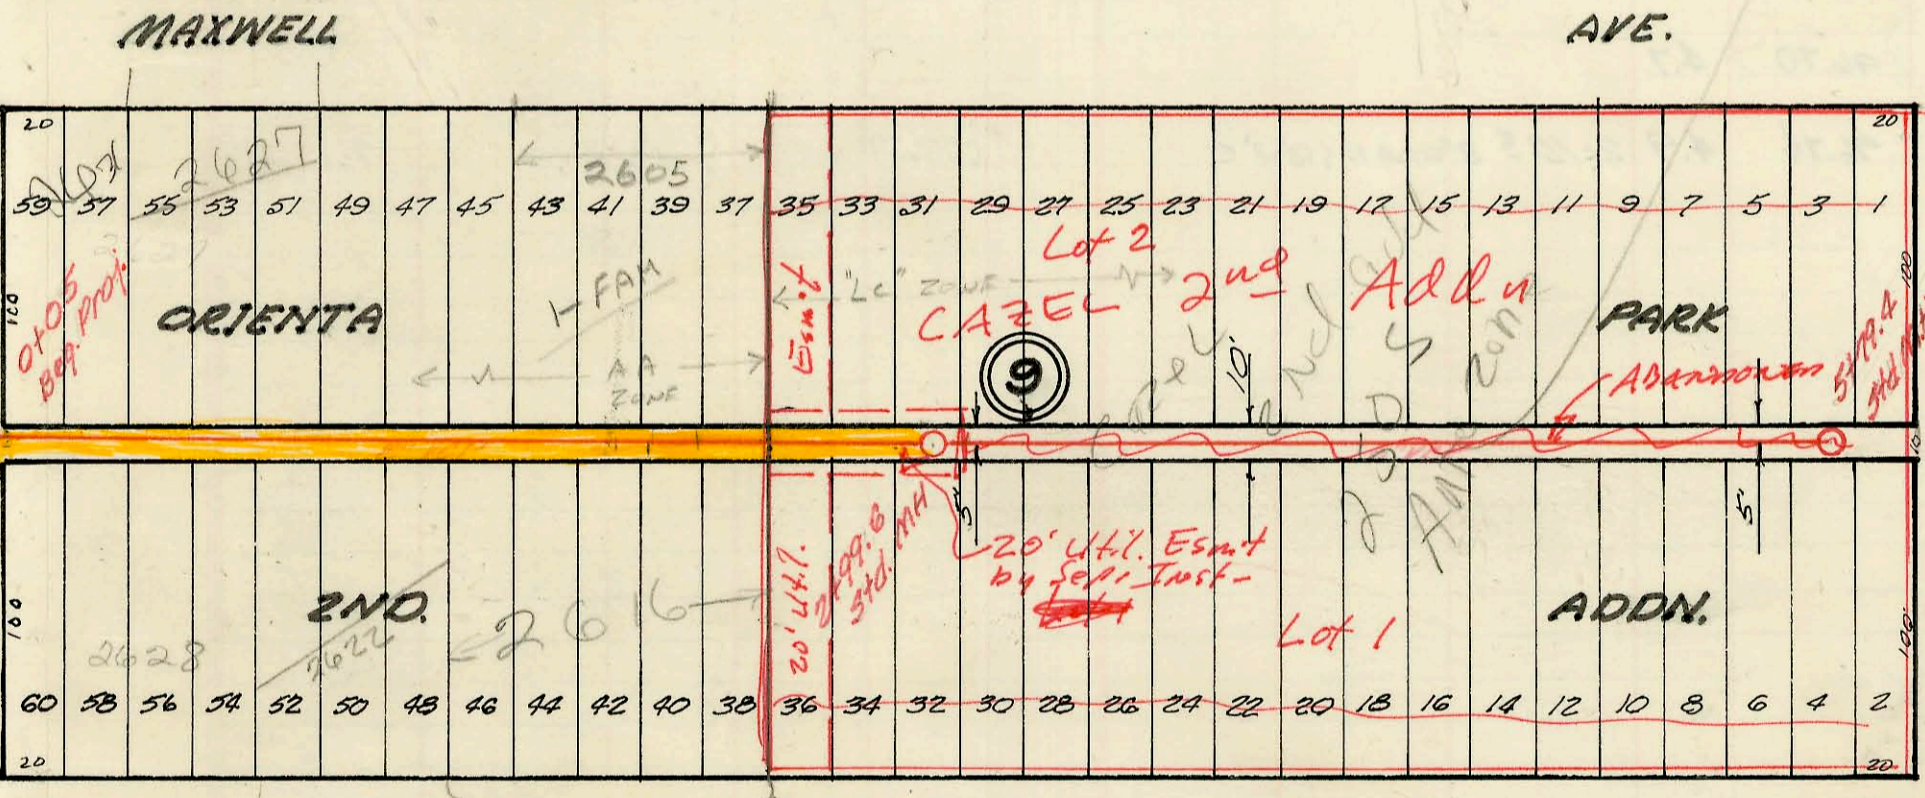

LAT. 5 SUB. 18 S.S. 22
 W.B. CARTER CONSTR. CO.
 NOV. 1967 Booked Nov 17, 1967
 Proj. C 27-41 S.S. JK 49

