


COLONIAL PARK MOBILE HOME COURT
 SANITARY SEWER
 F. H. A. PROJECT #102-00031-M
 FILE NO 9-13-1-5
 BOOKED "PER PLAN"
 12-21-67
 PRIVATE

NOTE: This project page
 booked on 143
 141 to 143 incl.



NOTE:
 Private system - City maintains
 only those lines shown in dedicated
 easements

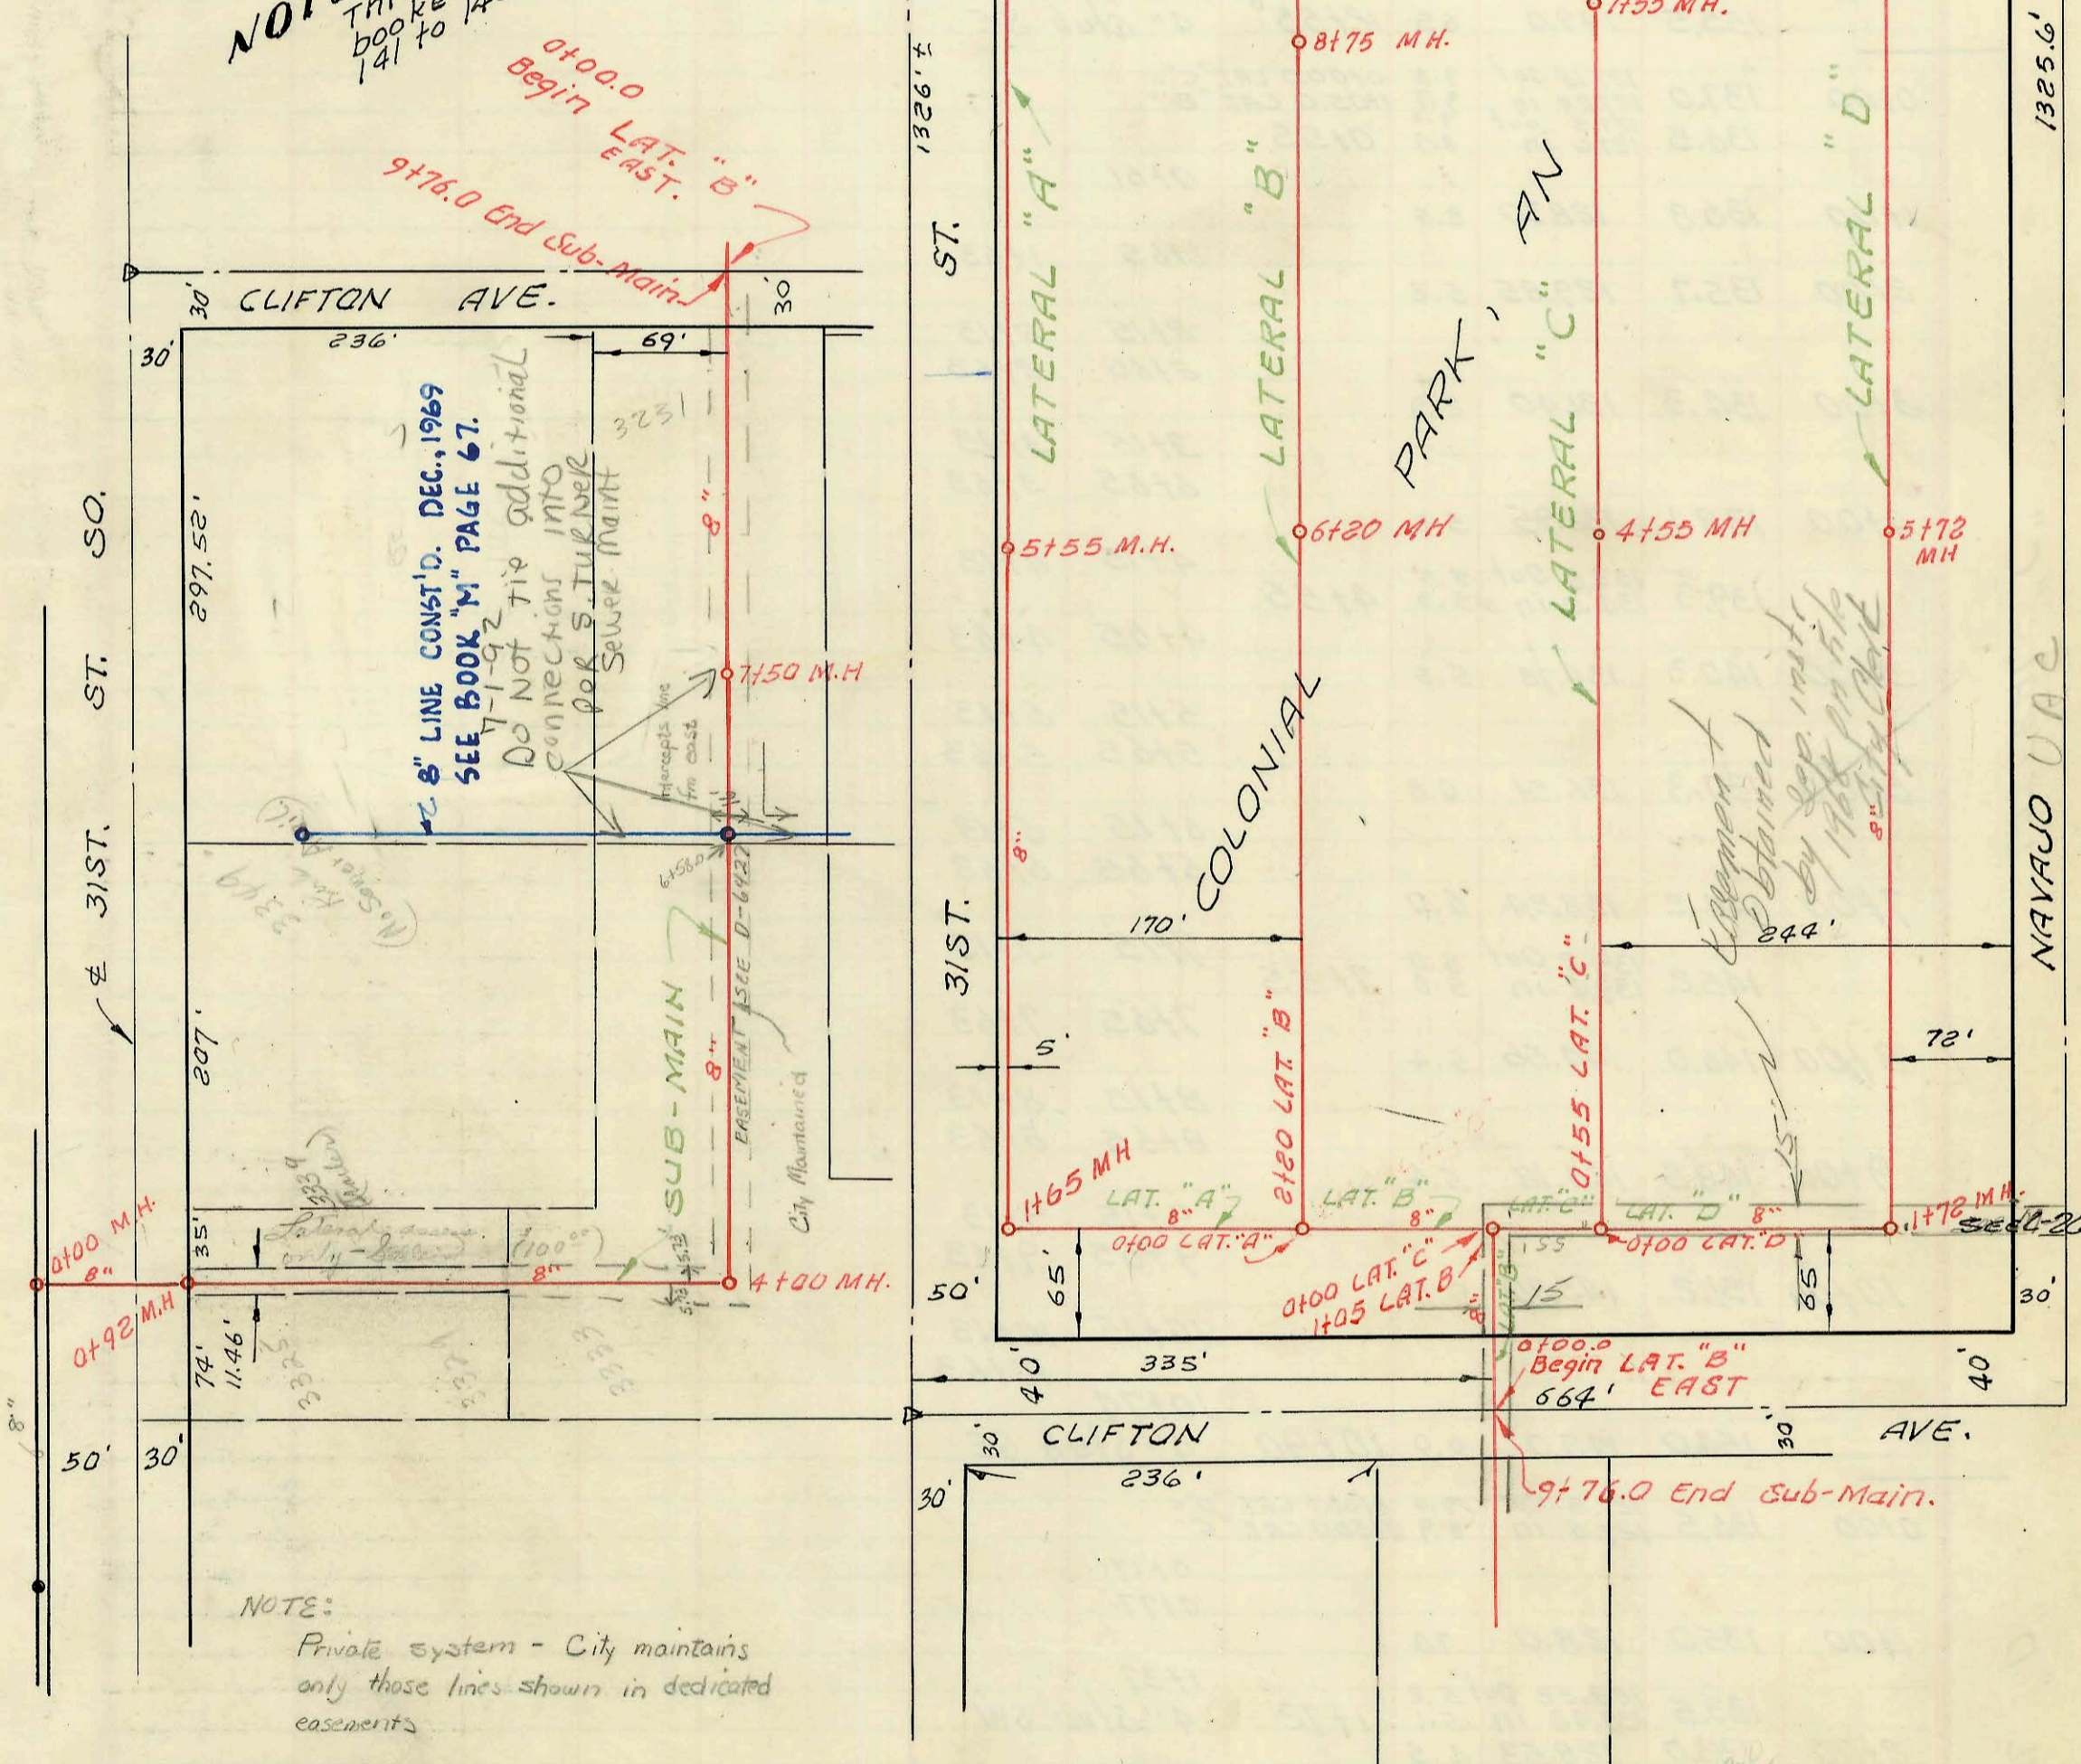