
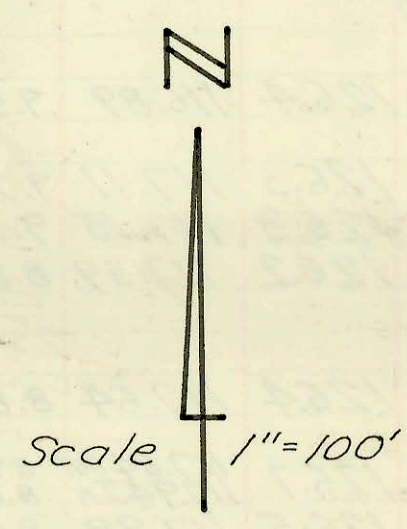




21st Street North
L156
Exist. 8" V.C.P. 0+00 Exist. M.H. 8" Stub S.
0+05 Begin Project

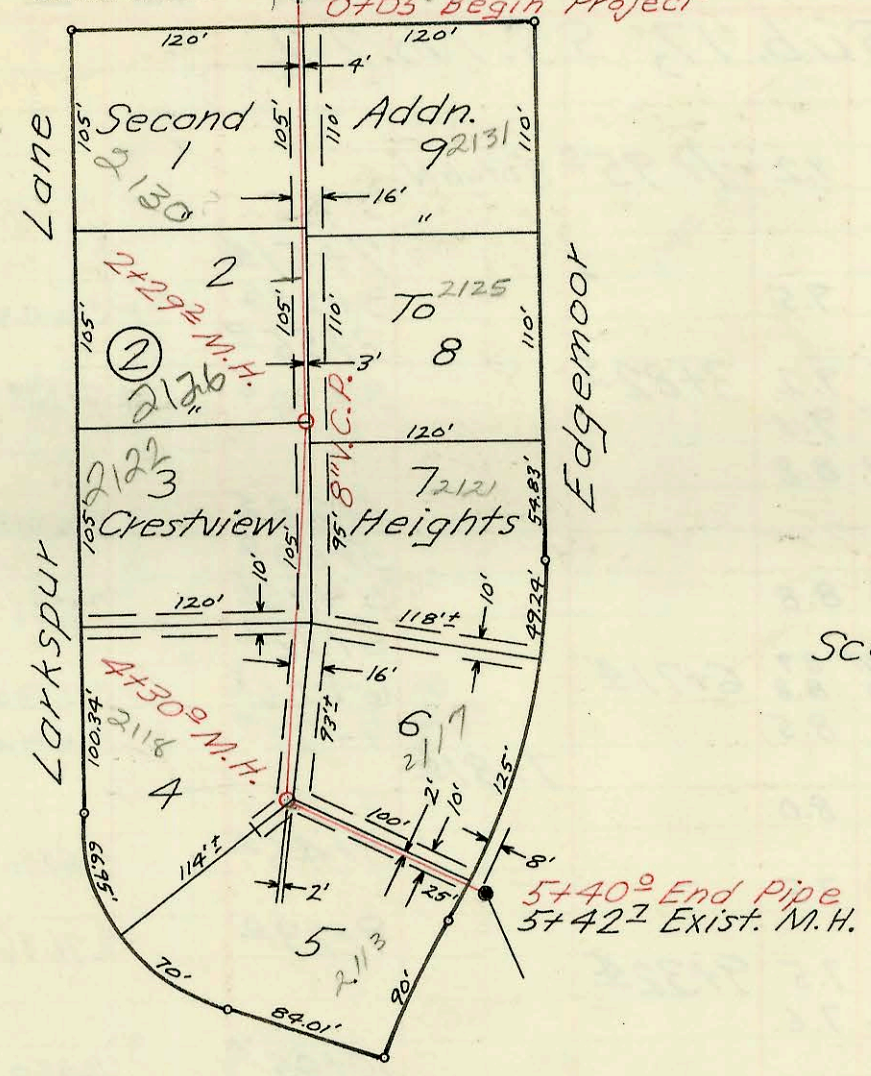

Lateral 10, Sub. 5, S.S. No. 23
 Utility Contractors, Inc. Nov. 1967
 Proj. No. C 26-39 Bk. K-83 Booked 2-15-68

ON MAP

19th Street North

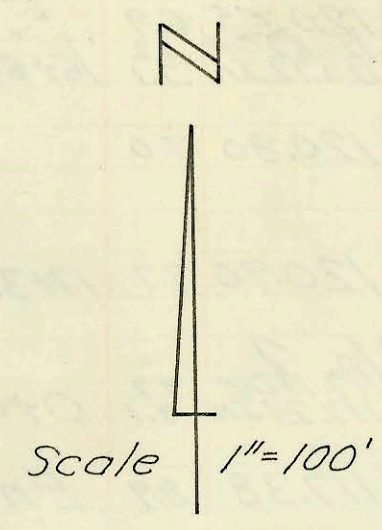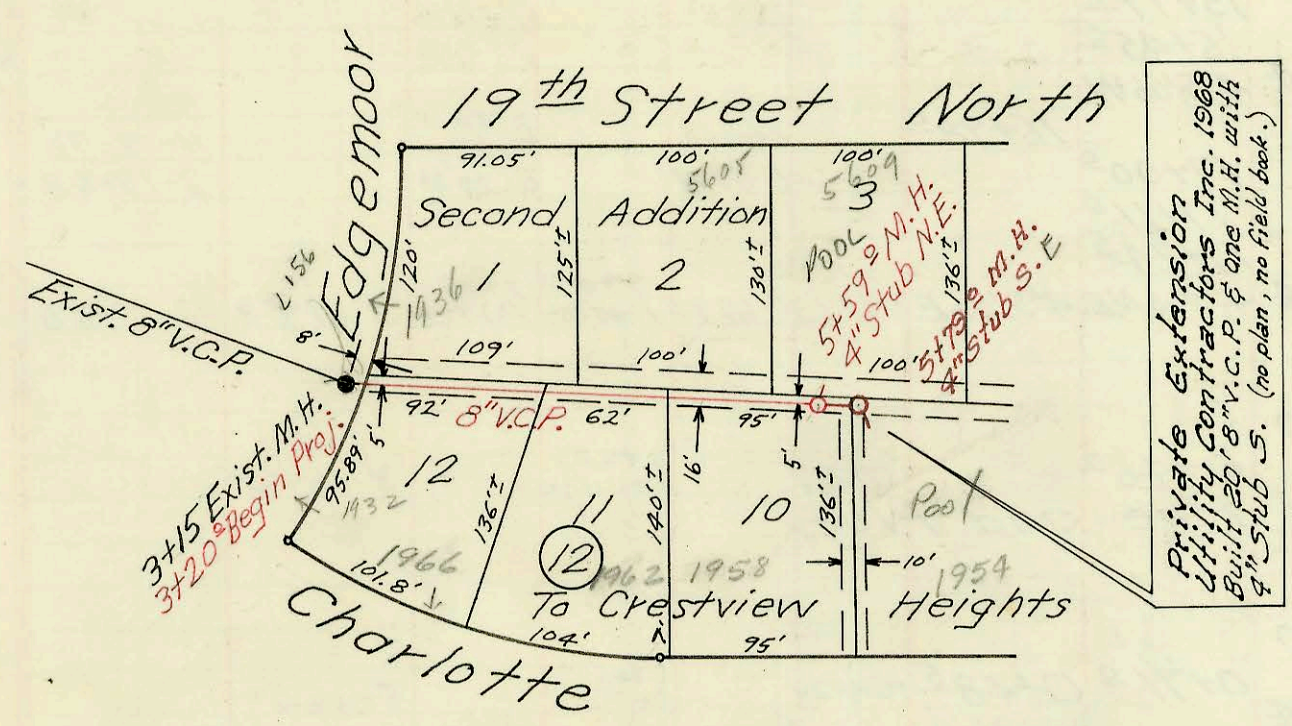

Lateral 23, Sub. 5, S.S. No. 23
 Utility Contractors, Inc. Feb. 1968
 Proj. No. C 26-67 Bk. K-83 Booked 2-20-68

ON MAP

CONSTRUCTION RECORD						SERVICE RECORD							
STATION	ELEVATION		Depth	MANHOLE	4-INCH "Y" BRANCHES		No. of Permit		House Number		DATE OF PERMITS		
	Ground	Grade			North West	South East	North West	South East	North West	South East	North West	South East	
Lateral 10, Sub. 5, S.S. No. 23													
0+00	203.3	194.90 Out 195.00 In	8.4 8.3	0+00 EXIST. M.H.	8" Stub S.	0+55°	0+53°	0+05 Begin Project					
1+00	205.0	195.50	9.5		0+82.0°	1+53°	1+51°	4157 C66945 C57390	2130 Larkspur Edgemont	2131 N. Edgemont 2125 N. Edgemont	9-22-81	7-6-78 8-25-76	
2+00	205.6 206.3	196.00 196.15	9.6 10.2	2+292	2+59°	2+61°		18586 C57389	2122 N LARKSPUR	2121 N. Edgemont	6-22-87	8-25-76	
3+00	206.8	196.50	10.3		3+60°	3+58°		4200 280	56533 211P Larkspur	2117 N. Edgemont		6-21-76	
4+00	207.1 207.5	197.00 197.14 Out 197.24 In	10.1 10.4 10.3	4+30°	4+47°			C55713		2113 N. Edgemont	5-12-80	6-7-76	
5+00	206.3	197.60	8.7		5+40 End Pipe and Plug								
Lateral 23, Sub. 5, S.S. No. 23													
3+15	215.7	206.12	9.6	3+15° EXIST. M.H.	8" Stub E.	3+20	Begin Project						
4+00	216.6	206.97	9.6		3+86°	3+46°	4+65°	4+27°	4+96°	C6956 C45691 C24163	1936 N. Edgemont 5605 E. 19th 1958 Charlotte	2-21-68	9-5-74 7-12-74 5-6-71
5+00	218.2 218.8 219.0	207.97 208.57 208.97	10.2 10.2 10.0	5+59° 5+79°	4" Stub NE. 4" Stub S.E.			C6955 C11799		5609 E. 19th 1954 Charlotte		2-20-68 12-4-68	