


LAT. 27, WESTLINK S.S.
W. B. CARTER CONST. CO. INC. 2-29-68
PROJ. NO. C27-39, J.K.#6, BOOKED 3-15-68

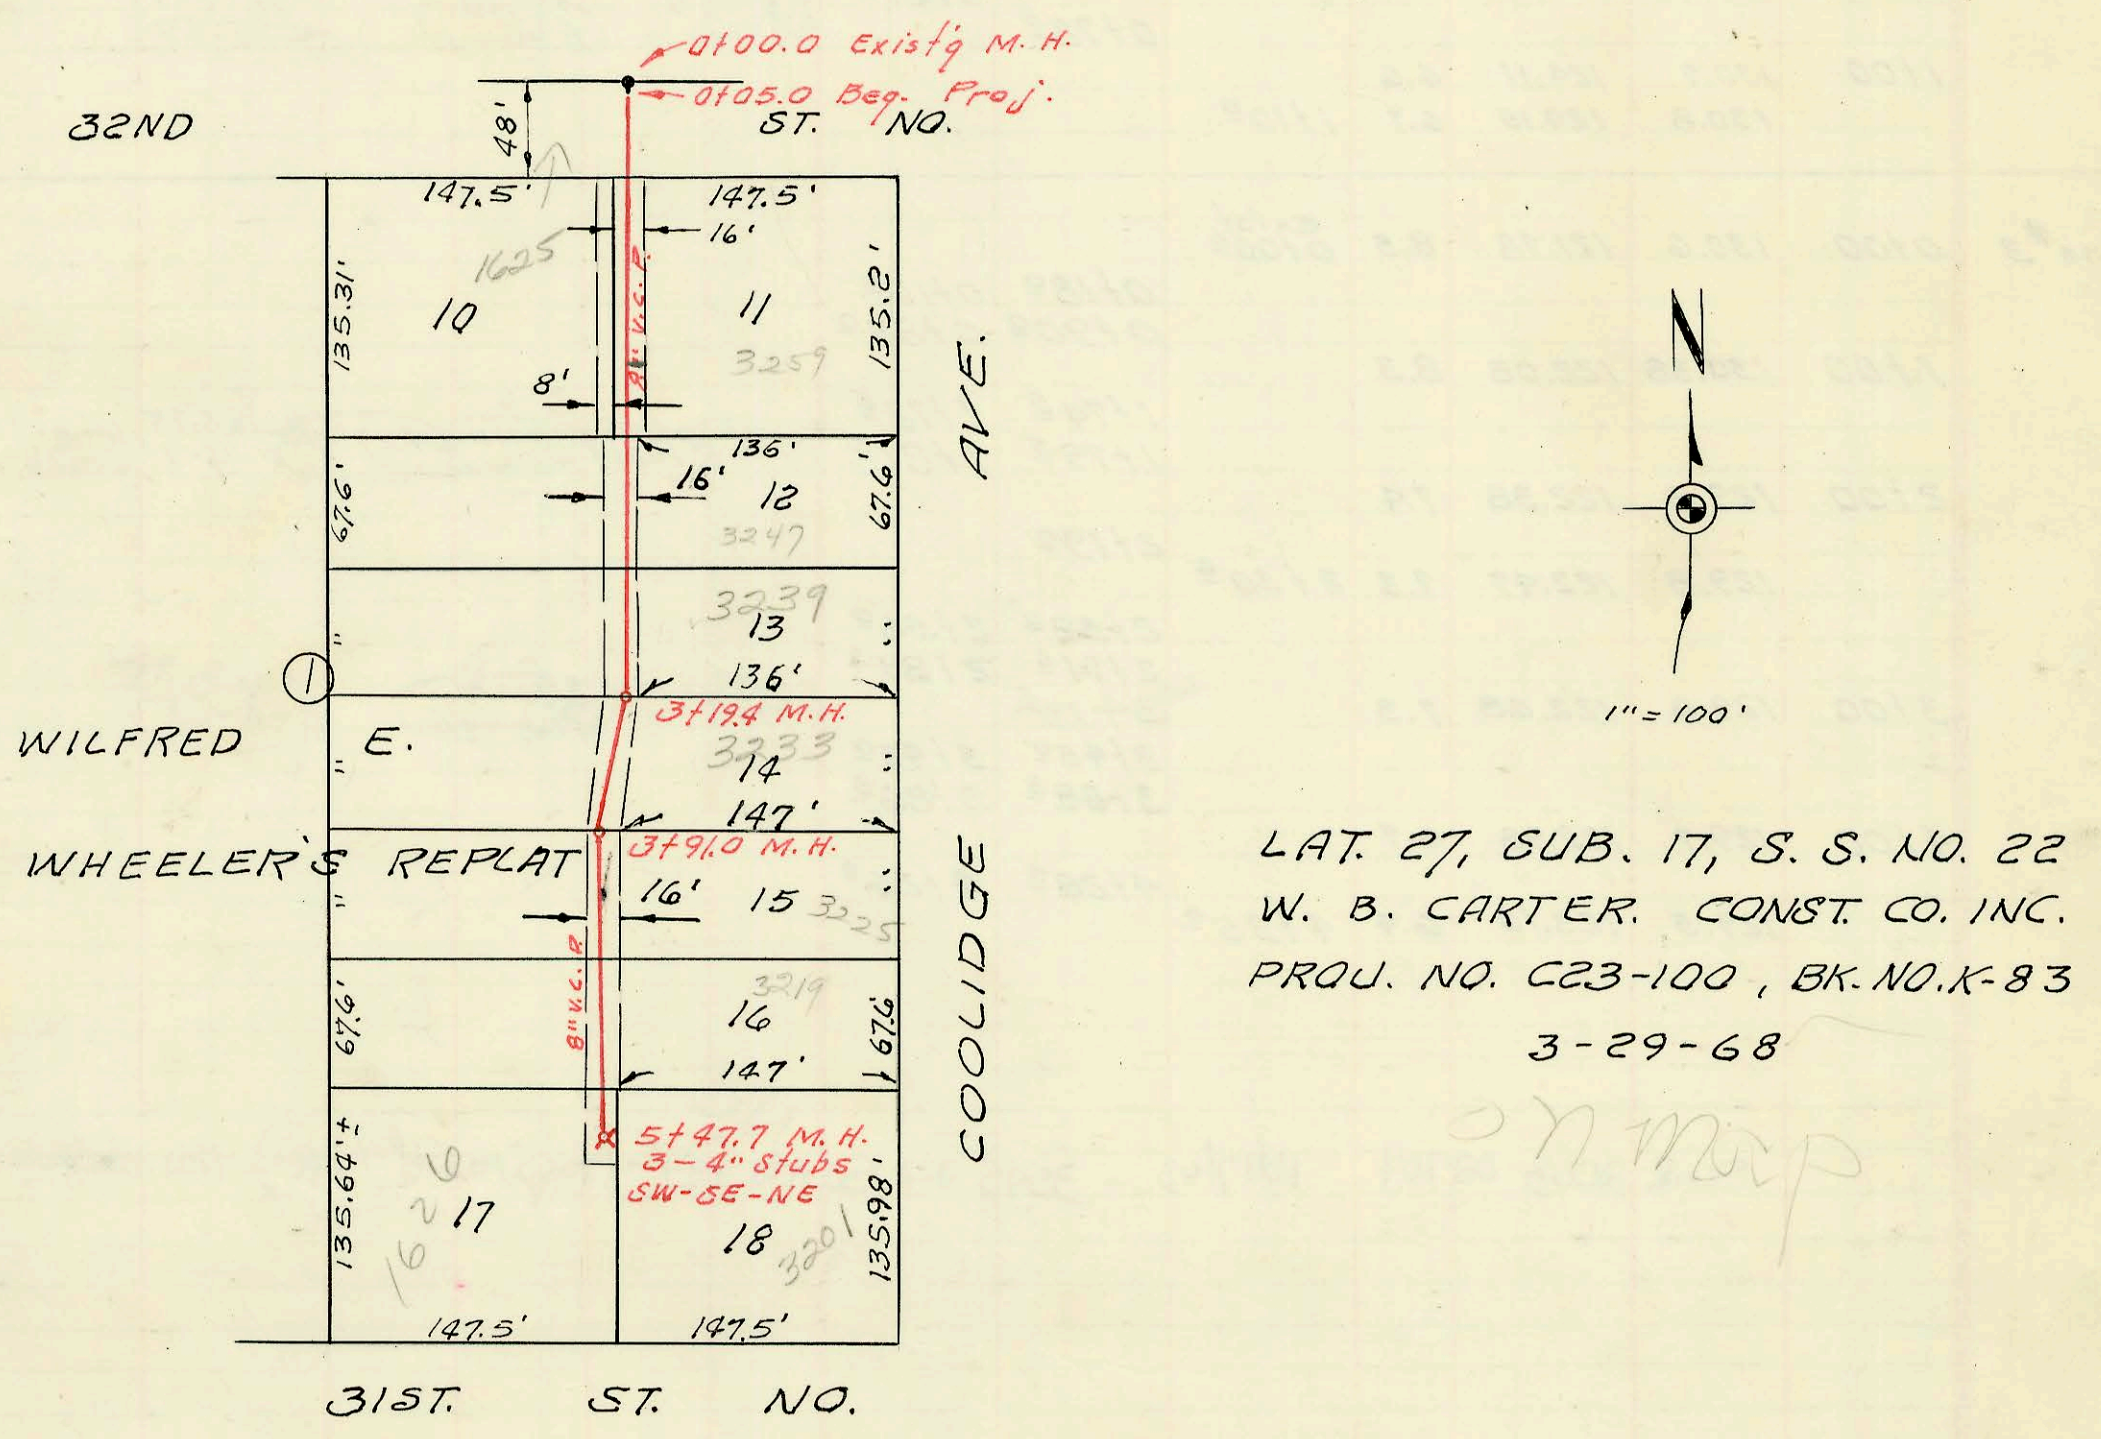

LAT. 27, SUB. 17, S. S. NO. 22
W. B. CARTER. CONST. CO. INC.
PROJ. NO. C23-100, BK. NO. K-83
3-29-68

on map

| CONSTRUCTION RECORD | | | | | | SERVICE RECORD | | | | | | |
|------------------------|-----------|--------|-------|--------------------|---------------------|----------------|---------------|------------|--------------|------------|-----------------|------------|
| STATION | ELEVATION | | Depth | MANHOLE | 4-INCH "Y" BRANCHES | | No. of Permit | | House Number | | DATE OF PERMITS | |
| | Ground | Grade | | | North West | South East | North West | South East | North West | South East | North West | South East |
| LAT. 27, WESTLINK S.S. | | | | | | | | | | | | |
| 0+00 | 149.7 | 133.54 | 11.2 | | | | | | | | | |
| 1+00 | 141.1 | 133.74 | 7.4 | | | | | | | | | |
| | 140.7 | 133.79 | 6.9 | 1+24° | | | | | | | | |
| 2+00 | 139.2 | 133.94 | 5.3 | | 1+53° | 1+51° | | | | | | |
| | | | | | 2+22° | 2+30° | | | | | | |
| | | | | | 2+63° | | | | | | | |
| 3+00 | 138.8 | 134.12 | 4.7 | 2+93° | 2+79° | | | | | | | |
| | 138.8 | 134.14 | 4.7 | | | | | | | | | |
| | | | | | 3+14° | | | | | | | |
| | | | | | 3+52° | | | | | | | |
| 4+00 | 142.1 | 134.34 | 7.8 | | 3+87° | 3+83° | | | | | | |
| | | | | | 4+46° | 4+48° | | | | | | |
| 5+00 | 142.8 | 134.54 | 8.3 | | 5+19° | 5+21° | | | | | | |
| | | | | | 5+63° | | | | | | | |
| 6+00 | 142.5 | 134.74 | 7.8 | 6+00° | 4" stub N.E. | | | | | | | |
| | 142.5 | 134.74 | 7.8 | | | | | | | | | |
| 0+00 | 131.0 | 120.60 | 10.4 | 0+00.0 EXIST'G MH. | | | | | | | | |
| 0+05° | 1300 | 120.80 | 9.2 | | | | | | | | | |
| 1+00 | | | | | 1+26° | | | | | | | |
| | | | | | 1+95° | 1+93° | | | | | | |
| 2+00 | 130.0 | 121.00 | 9.0 | | 2+30° | 2+71° | | | | | | |
| | | | | | 2+78° | | | | | | | |
| 3+00 | 131.0 | 121.2 | 9.8 | | 3+32° | 3+30° | | | | | | |
| | 131.0 | 121.24 | 9.8 | 3+19° | | | | | | | | |
| 4+00 | 130.6 | 121.38 | 9.2 | 3+91° | | | | | | | | |
| | 130.5 | 121.40 | 9.1 | | 4+16° | 4+14° | | | | | | |
| | | | | | 4+76° | 4+74° | | | | | | |
| 5+00 | 130.2 | 121.60 | 8.6 | | 3-4" stubs | | | | | | | |
| | 129.6 | 121.70 | 7.9 | 5+47° | SW-SE-NE | | | | | | | |

LAT. 27, SUB. 17, S.S. NO. 22

2001-03224 1219101 3259 Coolidge - Reddi - 4" sch 40 Ferroc to clay 20' from main, 3 Kickouts, 8 Ferro @ house, 2 Wyes, 4H22, 122V, 2H45, 1V45, 2TW 20 (Full Replacement)