


SERVICE RECORD CONSTRUCTION RECORD

See 156

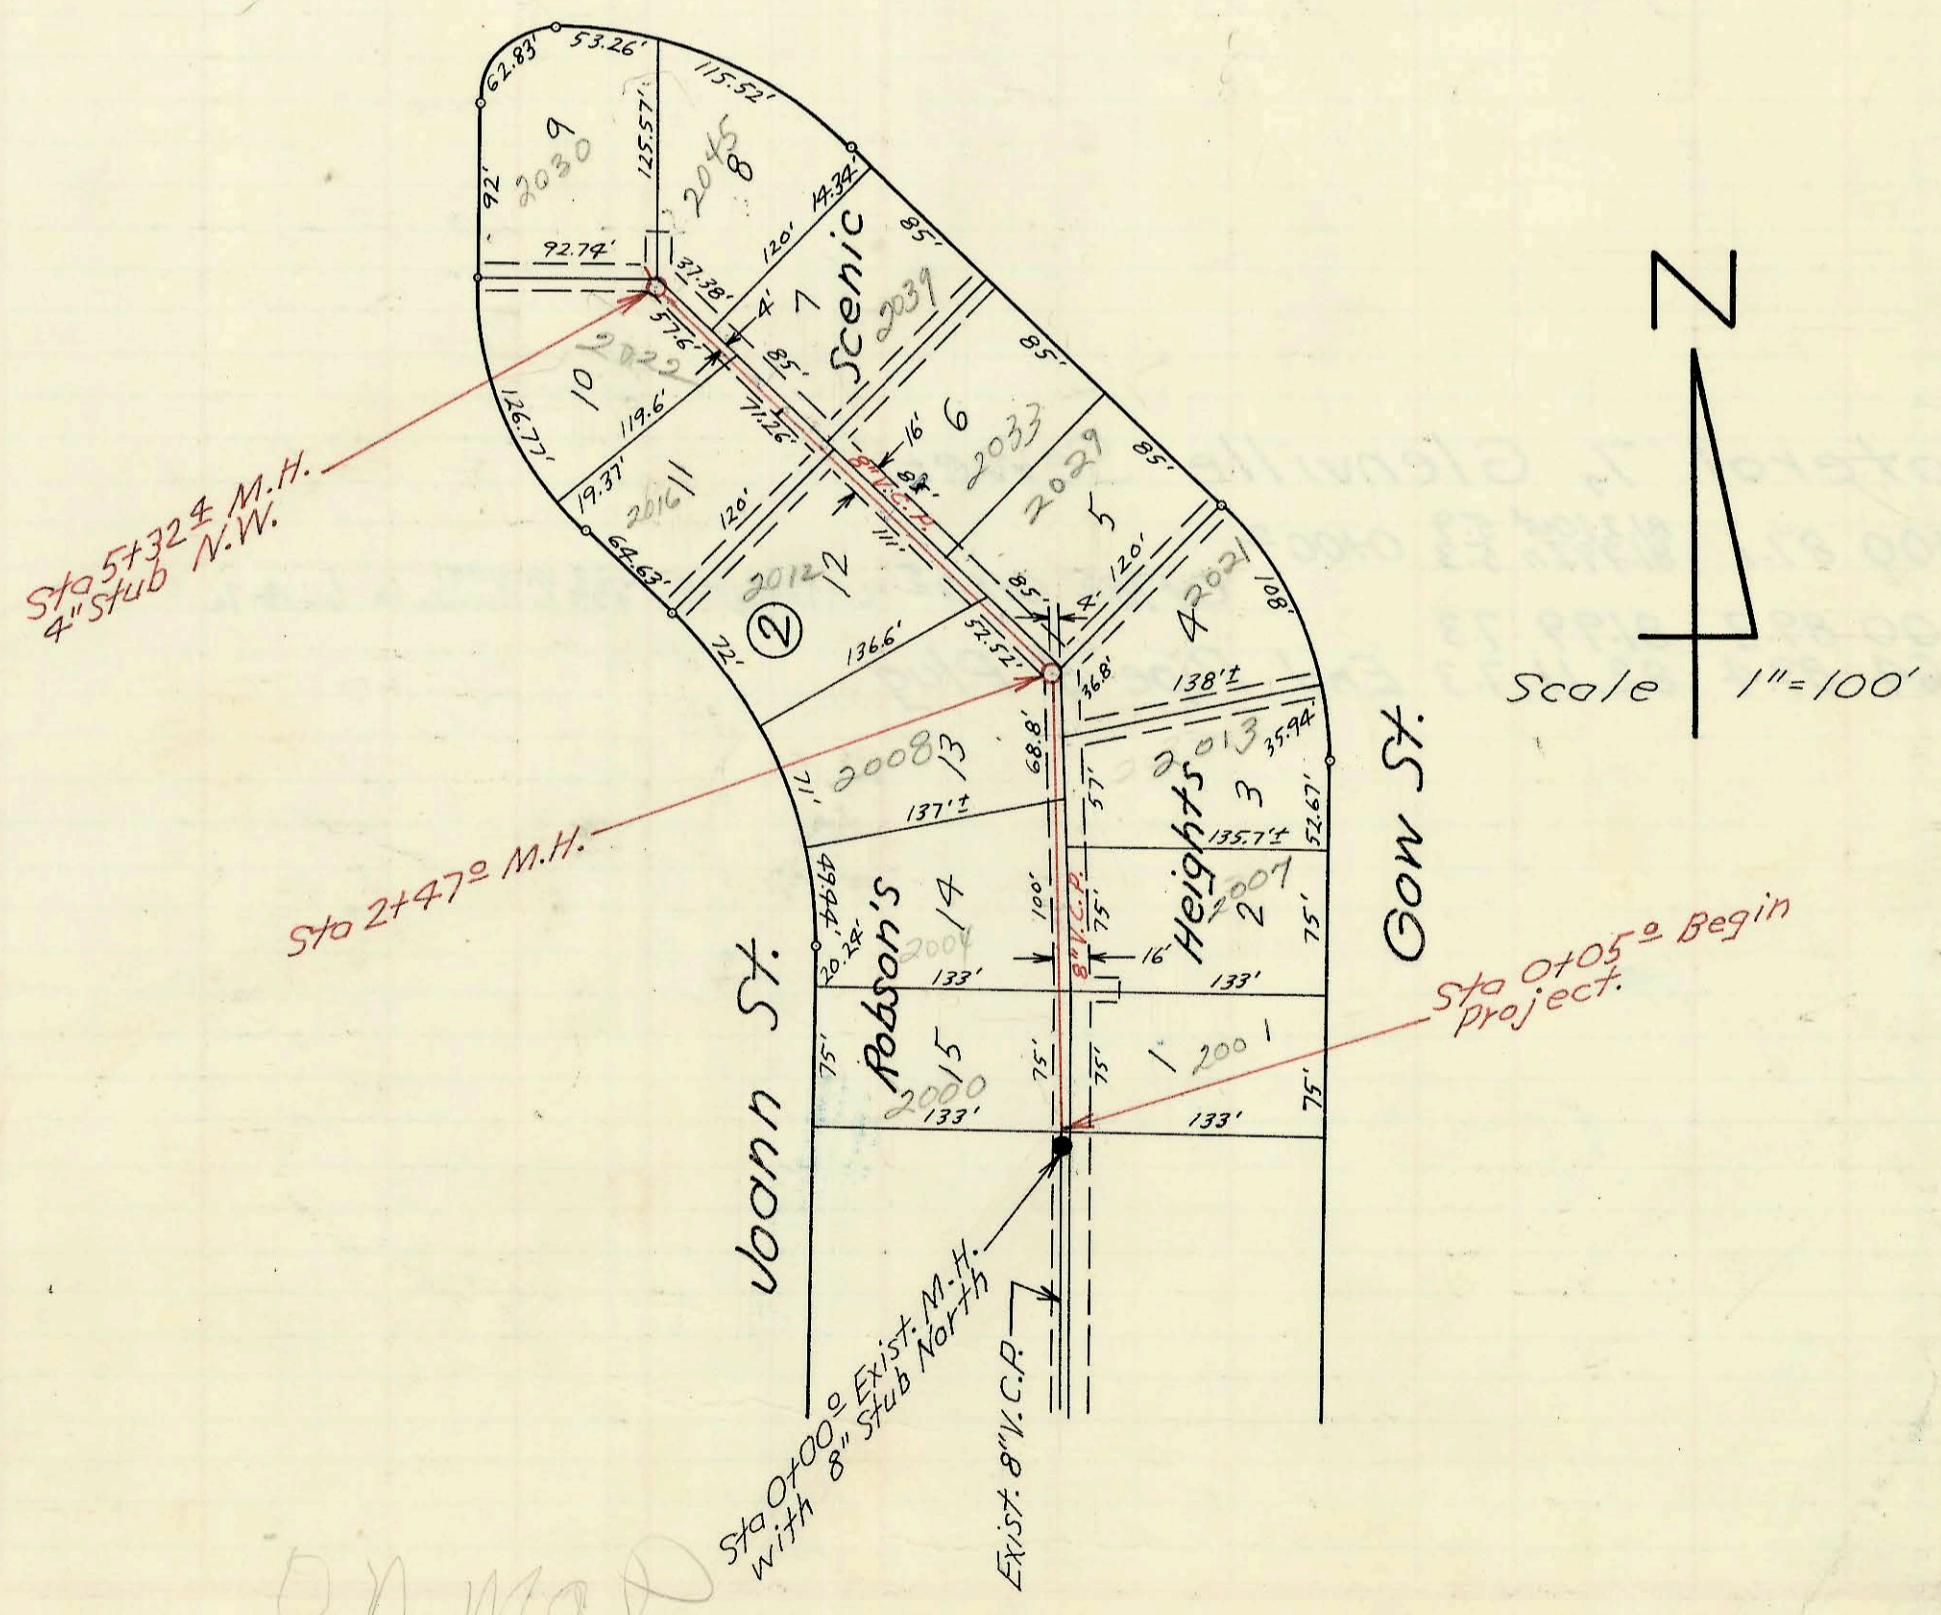

Lateral 30, Sub. 10, S.S. No. 22  
 W. B. Carter Const. Co., Inc. November 1968  
 Proj. No. C 27-33 Bk. J.K.#4 Booked 11-19-68

CONSTRUCTION RECORD						SERVICE RECORD						
STATION	ELEVATION		Depth	MANHOLE	4-INCH "Y" BRANCHES		No. of Permit		House Number		DATE OF PERMITS	
	Ground	Grade			North West	South East	North West	South East	North West	South East	North West	South East
Line # 5												
	205.1	197.90	7.2	0+00	8" stub	N.W.						
1+00	205.4	198.40	7.0									
	208.0	198.87	9.1	1+91°								
2+00	207.9	201.08	6.8									
	207.4	201.58	7.8	2+99°								
3+00	-	-	-									
4+00	212.0	202.08	9.9									
5+00	213.0	202.58	10.4									
	212.7	202.60	10.1	5+03°	8" stub	East						
6+00	212.7	204.56	8.1									
	213.0	204.64	8.4	6+16°								
7+00	214.1	205.00	9.1									
	214.5	205.31	9.2	7+48°								
8+00	215.1	205.56	9.5									
	215.6	205.80	9.9	8+26°	8" stub	West						
	215.9	206.02	9.9	8+68°	8" stub	East						
Lateral 30, Sub. 10, S.S. No. 22												
0+00	127.7	119.28	8.4	Exist. M.H. 0+00°								
					TAP 0+28.7							
					0+52°	0+50°	C18844	2000 Joann	2001 N. How		9-8-77	
1+00	127.7	119.48	8.2									
					1+14°	1+12°	C59050	C62056	2004 Joann	2007 How	12-13-76	7-14-77
						1+85°	C44936	2013 N. How			5-20-74	
2+00	127.9	119.68	8.2									
	127.7	119.77	7.9		2+11°	2+30°	C44937	2008 Joann	2021 N. How		9-20-73	
		119.87	7.8	2+47°	2+67.0	2+95.6	C41354	2009 Joann	2029 N. How	5-20-74	9-20-73	
						2+73°	C34437	2012 Joann	2033 N. How		8-22-72	
3+00	127.8	120.08	7.7									
					3+38°	3+55.5	C43465	2012 Joann			2-13-74	
					3+57°							
4+00	128.1	120.48	7.6									
					4+42°	4+40°	C53967	2016 R Joann		10-29-87	2-27-74	
					4+87°	4+87.4	C50174	2022 Joann	2039 N. How	7-3-75	10-5-72	
5+00	128.1	120.88	7.2									
					5+20°		C40158	2030 Joann	2045 N. How		7-20-73	
	128.2	121.02	7.2	5732±	4" stub	N.W.	C37091				2-7-73	