




scale 1"=40'

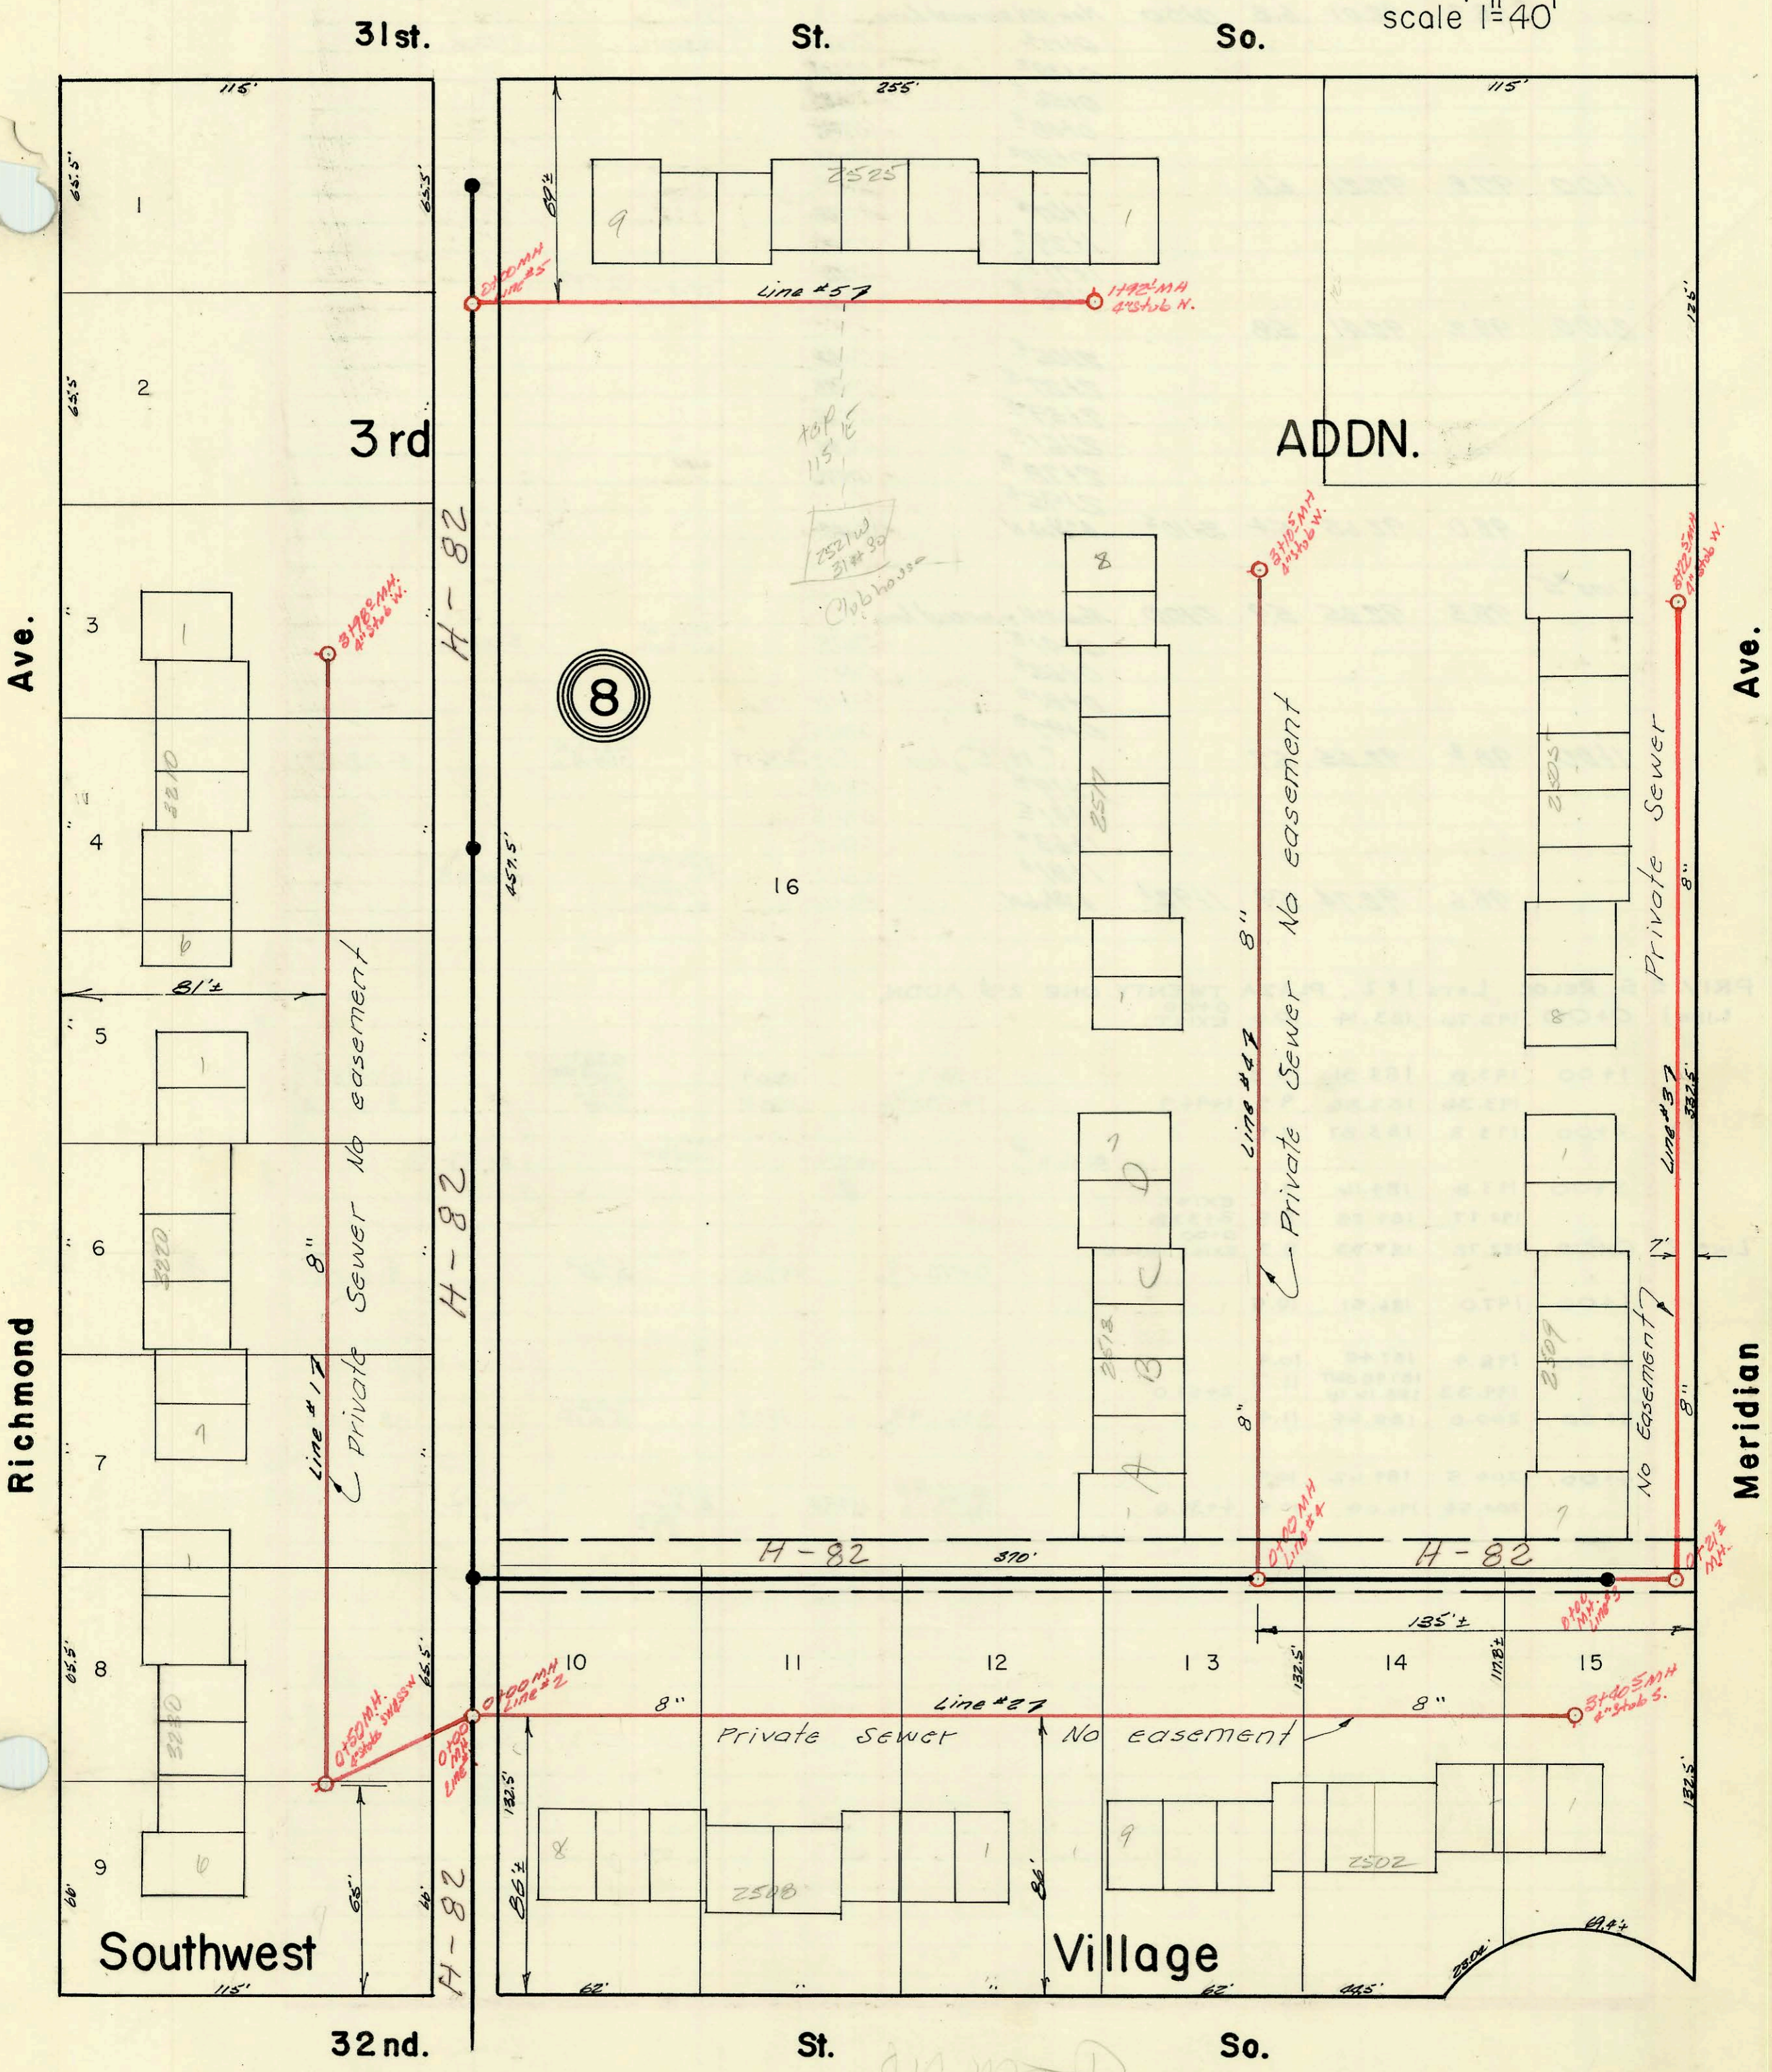

EXT. LAT. 13, S. S. 22
 Allied Utility Constr. Co.
 May, 1968 - Booked Apr. 1968 J.A.K. 2,
 Private Proj.

9-14-2-13

CONSTRUCTION RECORD						SERVICE RECORD						
STATION	ELEVATION		Depth	MANHOLE	4-INCH "Y" BRANCHES		No. of Permit		House Number		DATE OF PERMITS	
	Ground	Grade			North West	South East	North West	South East	North West	South East	North West	South East
LINE # 1												
0+00	98.2	91.46	6.7	Exist M.H.	0+00	Line #2	C7487		3230 S Richmond		3-25-68	
	98.3	91.66 in 91.56 out	6.7	0+50°	4" Sub 3 W	4" Sub 2 W	C7488		"		"	
					0+63°		C7487		"		"	
					0+75°		C7486		"		"	
					0+90°		C7485		"		"	
1+00	98.1	91.76	6.3		1+09°		C7484		3230 S Richmond		"	
					1+50°		C7483		3230 S Richmond		3-25-68	
					1+68°		C7482		"		"	
					1+85°		C7481		"		"	
2+00	97.9	91.96	5.9		2+07°		C7480		"		"	
					2+29°		C7479		"		"	
					2+51°		C7478		"		"	
					2+67°		C7477		"		"	
3+00	98.3	92.16	6.1		3+04°		C7476		3210 S Richmond		3-25-68	
					3+26°		C7475		"		"	
					3+47°		C7474		"		"	
					3+65°		C7473		"		"	
					3+80°		C7472		"		"	
	98.6	92.36	6.2	3+98°	4" Sub 4 W		C7471		3210 S Richmond		3-25-68	
LINE # 2												
0+00	98.2	91.46	6.7	Exist M.H.	Line #1	4" Sub 4 W	2001-01447		2506 W R 32nd St.		6-13-01	3-26-68
					0+18°		C7527		"		"	
					0+35°		C7526		"		"	
					0+57°		C7525		"		"	
					0+74°		C7524		"		"	
					0+96°		C7523		"		"	
1+00	98.2	91.66	6.5		1+18°		C7522		"		"	
					1+35°		C7521		"		"	
					1+53°		C7520		"		"	
					1+94°		C7519		2502 W 32nd St.		"	
2+00	98.1	91.86	6.2		2+16°		C7518		"		"	
					2+38°		C7517		"		"	
					2+45°		C7516		"		"	
					2+67°		C7515		"		"	
					2+79°		C7514		"		"	
3+00	97.7	92.06	5.6		3+08°		C7513		"		"	
					3+19°		C7512		"		"	
	97.4	92.14	5.3	3+40°	4" Sub 2 S		C7511		"		"	
LINE # 3												
0+00	97.6	92.41	5.2	Exist M.H.					2509 W 31st South		3-27-68	
	97.6	92.45	5.1	0+21.3	0+40°		C7562		"		"	
					0+64°		C7561		"		"	
					0+87°		C7560		"		"	
					0+98°		C7559		"		"	
1+00	97.4	92.60	4.8		1+15°		C7558		"		"	
					1+37°		C7557		"		"	
					1+59°		C7556		"		"	
					1+96°		C7555		2505 W 31st South		3-27-68	
2+00	97.2	92.80	4.4		2+19°		C7554		"		"	
					2+40°		C7553		"		"	
					2+58°		C7552		"		"	
					2+75°		C7551		"		"	
					2+91°		C7550		"		"	
3+00	97.5	93.00	4.5		3+09°		C7549		"		"	
	97.4	93.05	4.3	3+20°	4" Sub 4 W		C7548		"		"	

Cont'd Page 164