
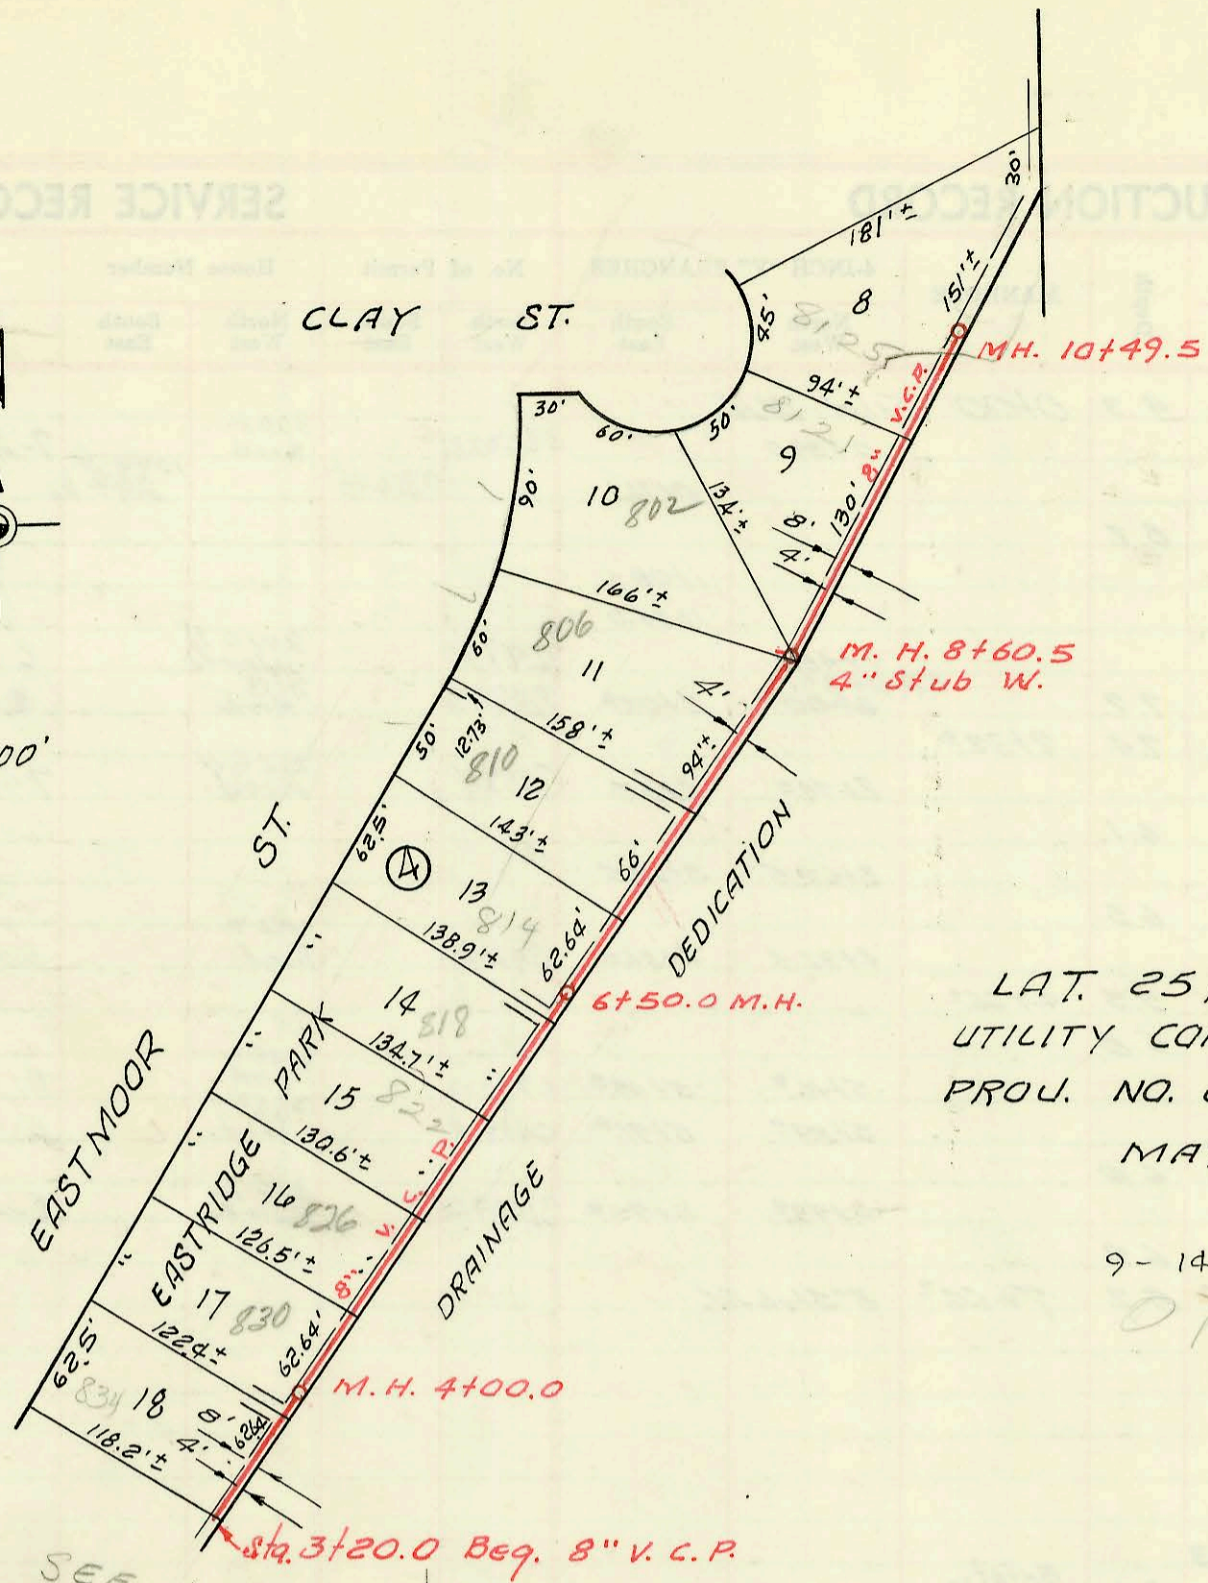


SERVICE RECORD

1" = 100'


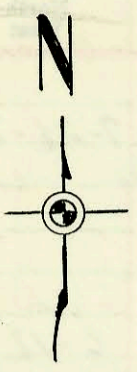


LAT. 25, W. I. S.
 UTILITY CONTRACTORS INC.
 PROJ. NO. C29-17, BK I. H. 5
 MAY 21, 1968

9-14-3-3

ON MAP

SEE J-96
 EXIST'g MH
 24+54.2

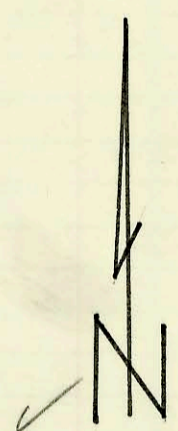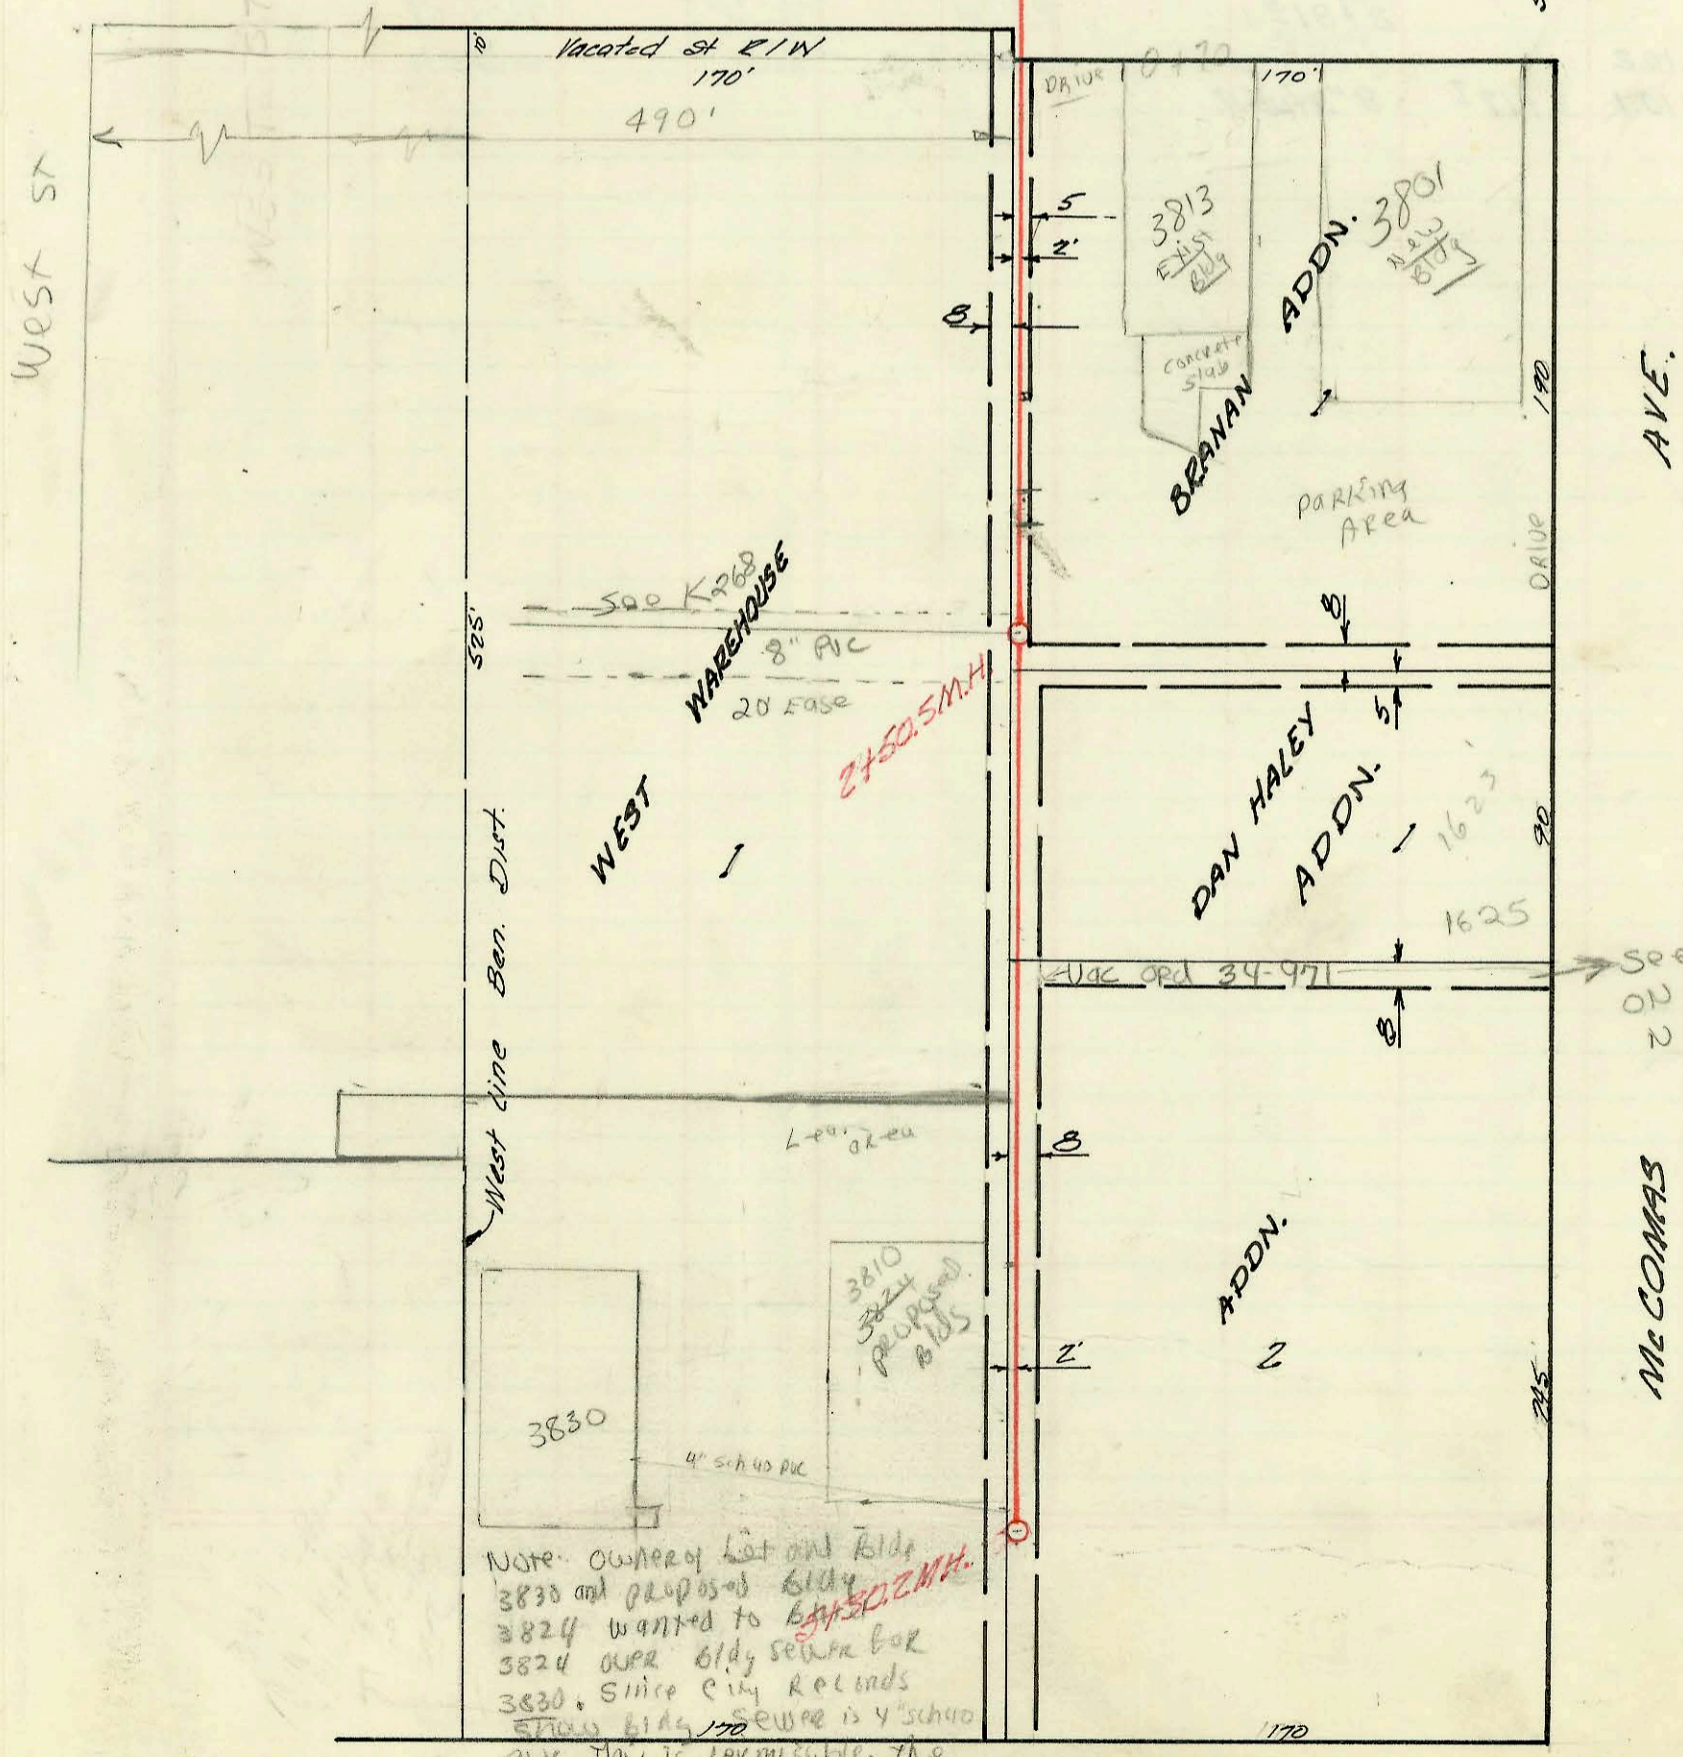

SCALE 1" = 60'

See enclosed Notice
 of vac of 8' EASE along
 lot 2 Block 1
 West warehouse add.
 4990
 BL

Note: Owners of lot and bldg
 3830 and proposed bldg
 3824 wanted to have
 3824 over bldg sewer for
 3830. Since city records
 show bldg 170 sewer is 4\"/>

BOUNOUS
 2/5/68 - B. R. COURT
 Sewer permit clerk

LAT. 111 S. 3 # 22
 W.B. CARTER CONSTR CO.
 LET 4-16-68 BOOKED 5-24-68
 PROJ. C28 22 S.S. JAK # 3

CONSTRUCTION RECORD						SERVICE RECORD						
STATION	ELEVATION		Depth	MANHOLE	4-INCH "Y" BRANCHES		No. of Permit		House Number		DATE OF PERMITS	
	Ground	Grade			North West	South East	North West	South East	North West	South East	North West	South East
3+00												
3+20°	Beq.	Proj.										
3+20°	135.8	130.38	5.4									
4+00	136.1	130.70	5.4	4+00°	3+40°		210341		834 Eastman		9-4-68	
					4+13°		C8424		830 Eastman		5-22-68	
					4+73°		C8989		836 Eastman		6-6-68	
5+00	137.4	131.10	6.3		5+36°		C10338		822 Eastman		9-4-68	
					5+87°		C11809		818 Eastman		12-4-68	
6+00	138.8	131.50	7.3		6+50°							
	139.8	131.70	8.1	6+50°	4" sch. 40		C13007		814 B Eastman		8-17-65	
					6+59°		C9722				7-22-68	
7+00	140.7	131.90	8.8		7+26°		C8425		810 Eastman		5-22-68	
					7+88°		C8426		806 Eastman		5-22-68	
8+00	140.2	132.30	7.9		8+60°	4" sch. 40 W	C8427		802 Eastman		5-22-68	
9+00	140.7	132.54	8.2		9+16°		C114245		81212 clay		5-27-69	
10+00	140.2	133.10	7.1		10+37°		C12847		81256 clay		2-19-69	
	140.1	133.30	6.8	10+49°								
Lat. 111 S.S. #22												
	111.2	104.16	7.0	0+00								
1+00	111.2	104.36	6.8		0+88.7							
					1+21.5°		C8326		3845 W. Harry		5-16-68	
					1+75°							
2+00	110.5	104.56	5.9		2+06.0°		19390		3813 Harry		10-26-89	
	109.7	104.66	5.0	2+50.5	2+14.5°		947917-7		3801 Harry		5-25-74	
					2+81.3							
3+00	110.5	104.76	5.7		3+49.2		C10761		16238 McComas		10-1-68	
					3+54.9							
4+00	110.3	104.96	5.3		4+01.2	4+22.8	H4142		16235 McComas (trailer)		6-4-80	
					4+48.1							
5+00	111.0	105.16	5.8		5+04.2 TAP		98-54097		3810 W BOUNOUS		4-8-98	
	111.3	105.22	6.1	5+30.2	5+25.2 TAP		17539	C3730	3830 W BOUNOUS	3617	12-29-86	2-20-73
					4" sch. 40							

98-5535-7 3830 W. BOUNOUS 4/8/98 DRAIN LAYER REROUTED DRAINAGE SENER OUT FROM UNDER NEW BLOC KNOWN AS 3810 W. BOUNOUS 3-45 H/1-45 V/15 TWIN CO.