




LAT. 13, SUB. 2, S.S. # 23.
W.B. CARTER CONSTR. CO
LET 5-14-68 BOOKED 5-31-68
PROJ C20-22 K79 & K90

ON map

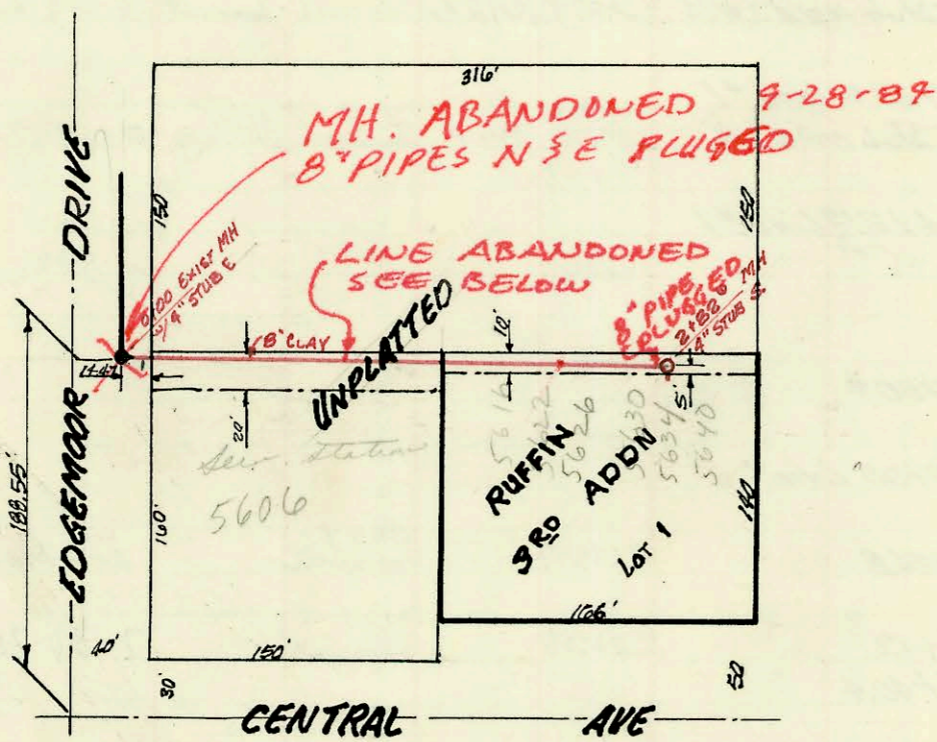

Lot 69, Dry Creek Main SS #12
BUILT BY: UTILITY CONTRACTORS
BOOKED: 14 SEPT 71 FROM
PRIVATE PROJECT

ON map

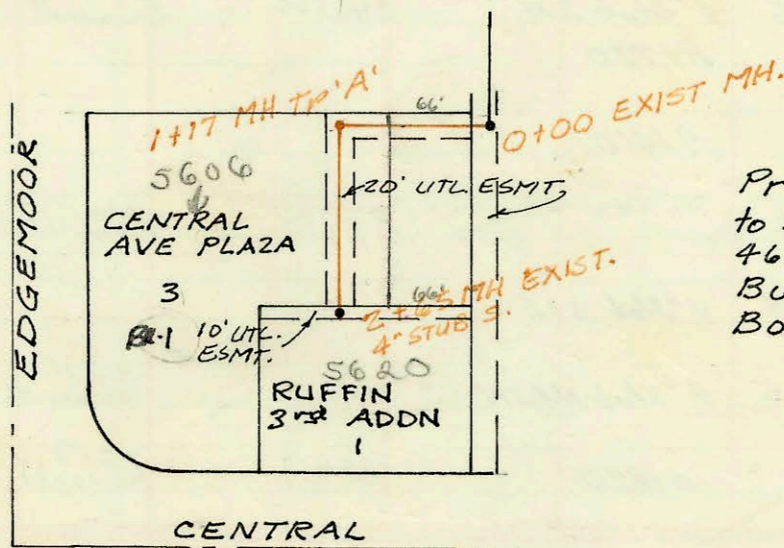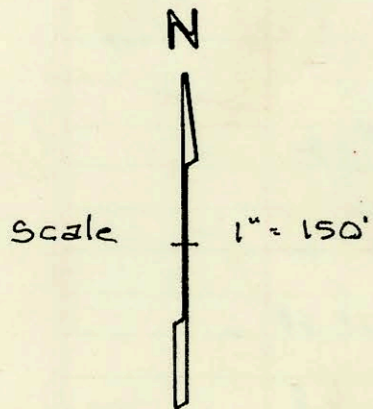

Private Sanitary Sewer Relocation
to Serve Lot 3, Blk 1, Central Ave Plaza
468-76-245-80000-000-000-008
Built By Utility Contractors, Inc.
Booked 1-21-84 From 13-E

CONSTRUCTION RECORD

SERVICE RECORD

STATION	ELEVATION		Depth	MANHOLE	4-INCH "Y" BRANCHES		No. of Permit		House Number		DATE OF PERMITS	
	Ground	Grade			North West	South East	North West	South East	North West	South East	North West	South East
	164.1	153.60	10.5	0+00	Exist. M.H.							
					0+19°		C45344		4425 W. 27th St.		6-14-74	
					0+51°		C9969		4502 Greenbush		8-7-68	
1+00	163.9	154.00	9.9	Top	1+05.4	11	C52504		4417 E. 27th		11-19-75	
					1+36°		C9949		4506 Greenbush		8-6-68	
					1+97°							
2+00	161.6	154.00	7.2						4401 E. 27th St.		11-20-75	
	161.2	154.52 OUT 154.62 IN	6.7	2+30°	Top 2+55.5		C52498		4502 Greenbush		6-21-68	
					2+65°							
3+00	159.6	154.90	4.7		Top 2+13		C52499		4409 E. 27th St.		11-20-75	
	159.3	155.00	4.3	3+24°								
4+00	160.1	155.86	4.2									
5+00	162.7	156.86	5.8									
6+00	165.6	157.76	7.8	5+89°								
	166.4	157.86	8.5									
7+00	167.9	158.86	9.0									
8+00	169.4	159.86	9.5									
	170.2	160.46	9.7	8+61°								
LAT 69, DRY CREEK MAIN, SS#12												
0+00	187.2	184.00	3.2	0+00	EXIST 1/4" STUB E							
1+00	187.7	184.40	3.3					7687	3606 E Central		3-16-83	
2+00	188.2	184.80	3.4									
	188.3	184.92	3.4	2+28°	4" STUB S.			C28120	3606 E Central		9-22-71	
Private San. Sew. Relocation to serve Lot 3, Blk 1, Central Ave Plaza												
0+00	189.0	179.08	9.9	0+00	EXIST.							
1+00	189.5	179.48	10.0									
	189.5	179.55 OUT 183.55 IN	6.0	1+17								
2+00	188.8	184.32	4.5									
	188.5	184.94	3.6	2+65°	EXIST			12424	3606 Central		10-30-84	