


LAT. 45, WESTLINK SEWER
 W. B. CARTER CONST. CO. INC.
 BK. J. K. #2, PROJ. NO. C28-43
 SEPT. 30, 1968

LAT 44, WESTLINK SEWER
 BUILT BY: UTILITY CONTRACTORS INC.
 BACKED 21 Dec 71 FROM K-106
 PROJ. No DBKLS68042

on map

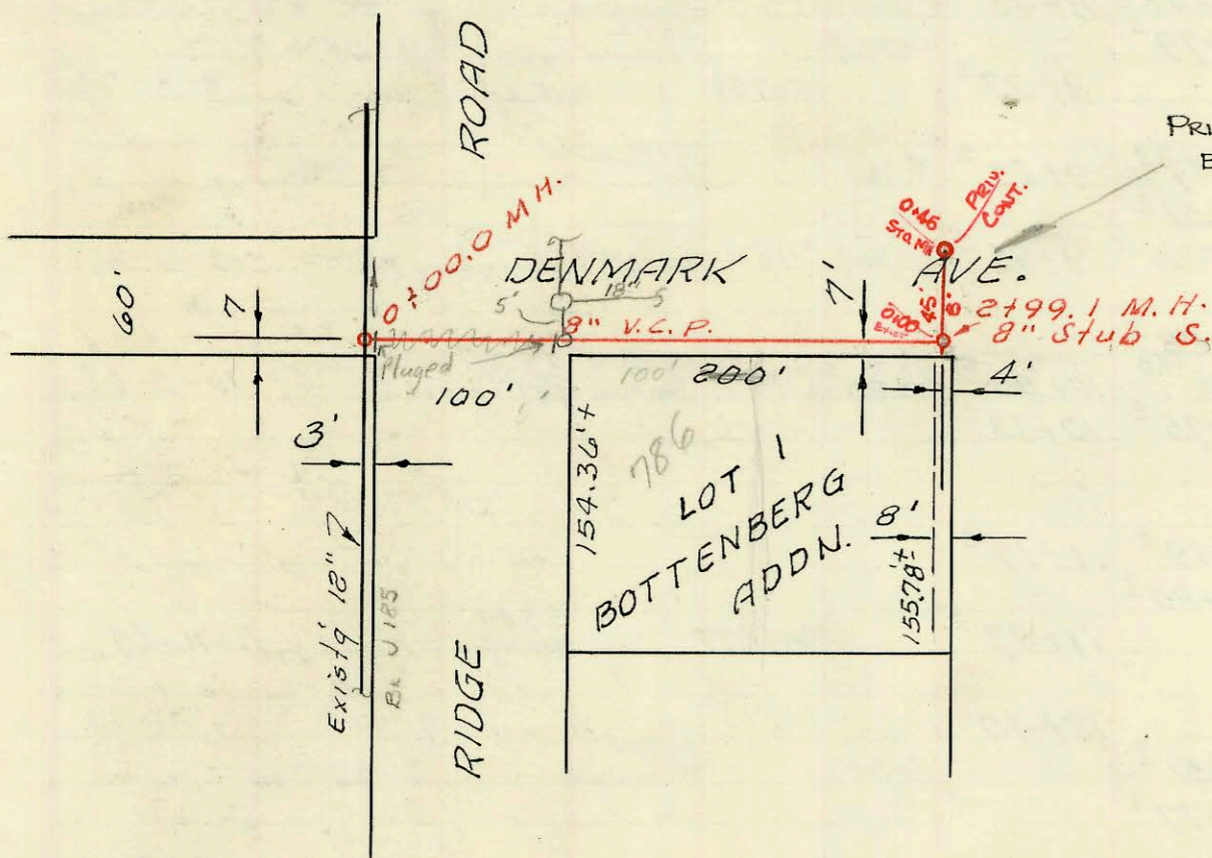

PRIVATE SEWER FOR DUTCHMAN'S WEST SIDE NURSERY
 BUILT BY: UTILITY CONTRACTORS INC. MARCH 29, 71
 PRIVATE CONTRACT.

LAT. 47, WESTLINK SEWER
 W. B. CARTER CONST. CO. INC.
 PROJ. NO. C28-67, J. K. # 1
 OCT. 1, 1968.

on map

CONSTRUCTION RECORD

SERVICE RECORD

STATION	ELEVATION		Depth	MANHOLE	4-INCH "Y" BRANCHES		No. of Permit		House Number		DATE OF PERMITS	
	Ground	Grade			North West	South East	North West	South East	North West	South East	North West	South East
LINE NO. 1 0+00	130.6	123.95	6.6	0+00.0 Exist'g M.H.								
						0+63.75 0+28 0+95 ^E		C49740	7039 School			6-2-75
1+00	129.4	124.10	5.3			Jap 1+18.2 1+62 ^E		C50288	7031 School			7-11-75
2+00	128.6	124.25	4.3			1+86 ^E 2+35 ^E		C15101 C14631	7025 School 7017 School			7-24-69 6-24-69
3+00	128.0	124.38	3.6	2+84 ^E		4" stub SE		C13555	7089 School			4-14-69
4+00	128.4	124.40	3.6									
5+00	127.9	124.55	3.8	4+01 ^E		4" stub E. 4" stub S. 4" stub 40		C10751 2000-01157 C11881	1105 Hazelwood 7001 School see below			10-1-68 12-9-68
	127.9	124.75	3.1					C10901	1104 Hazelwood			10-11-68
6+00	128.3	124.80	3.1	5+27 ^E		4" stub S.E. 5+53 ^E						
6+00	128.3	124.95	3.3			top 5+48.6		C50294	1108 Hazelwood			6-27-75
6+77.6	129.2	125.10	4.1			6+26 ^E						
6+77.6				End 8" V. C. P.		6+66 ^E		C14632	1112 Hazelwood			6-24-69
LINE NO. 2 0+00	128.0	124.38	3.6	0+00 LINE NO. 2 = 2+84.2 Line No. 1								
0+47 ^E	128.5	124.45	4.0									
0+47 ^E				End 8" V. C. P.								
LAT 44 WESTLINK SEWER												
0+00	129.6	124.45	5.2	0+00 NEW M.H. @ STA 0+47 LINE 2 (LAT 45)								
1+00	131.1	124.65	6.5			top 0+51 ^E top 1+46 ^E		C47253 C49187 C30057	1102 Sand plum 1101 Hazelwood 1108 Sand plum			11-1-74 4-23-75 1-19-72
1+00	131.3	124.70	6.6	1+20 ^L								
1+60	130.0	124.78	5.2	LINE PLUGGED								
0+00	127.5	119.54		0+00.0 New MH								
1+00	127.0	119.74						C19597	706 N. Ridge Rd.			9-27-68
2+00	127.2	119.94				1+74 ^E 1+97 ^E						
	126.0	120.14		2+99 ^L		2+24 ^E 8" stub So.		C43487 C43639	734 N. Ridge Rd. #1 734 N. Ridge Rd.			2-14-74 2-26-74
PRIVATE SEWER for DUTCHMAN'S WESTSIDE NURSERY												
0+00	126.0	120.44	5.6	0+00 EXISTING M.H. 2+99 ^L LAT 47.								
0+45	125.2	120.74	4.5	0+45		4" stub N.W.		C64629 C23536	802 N. Ridge Rd.			12-27-77 3-31-71
(B) 2000-01157-7001 W. School - Add It Up Plumb - 5/31/60 Repair 5' from house, tied into exist. cast iron C.O. 1 Twin CO 1-22 H												