

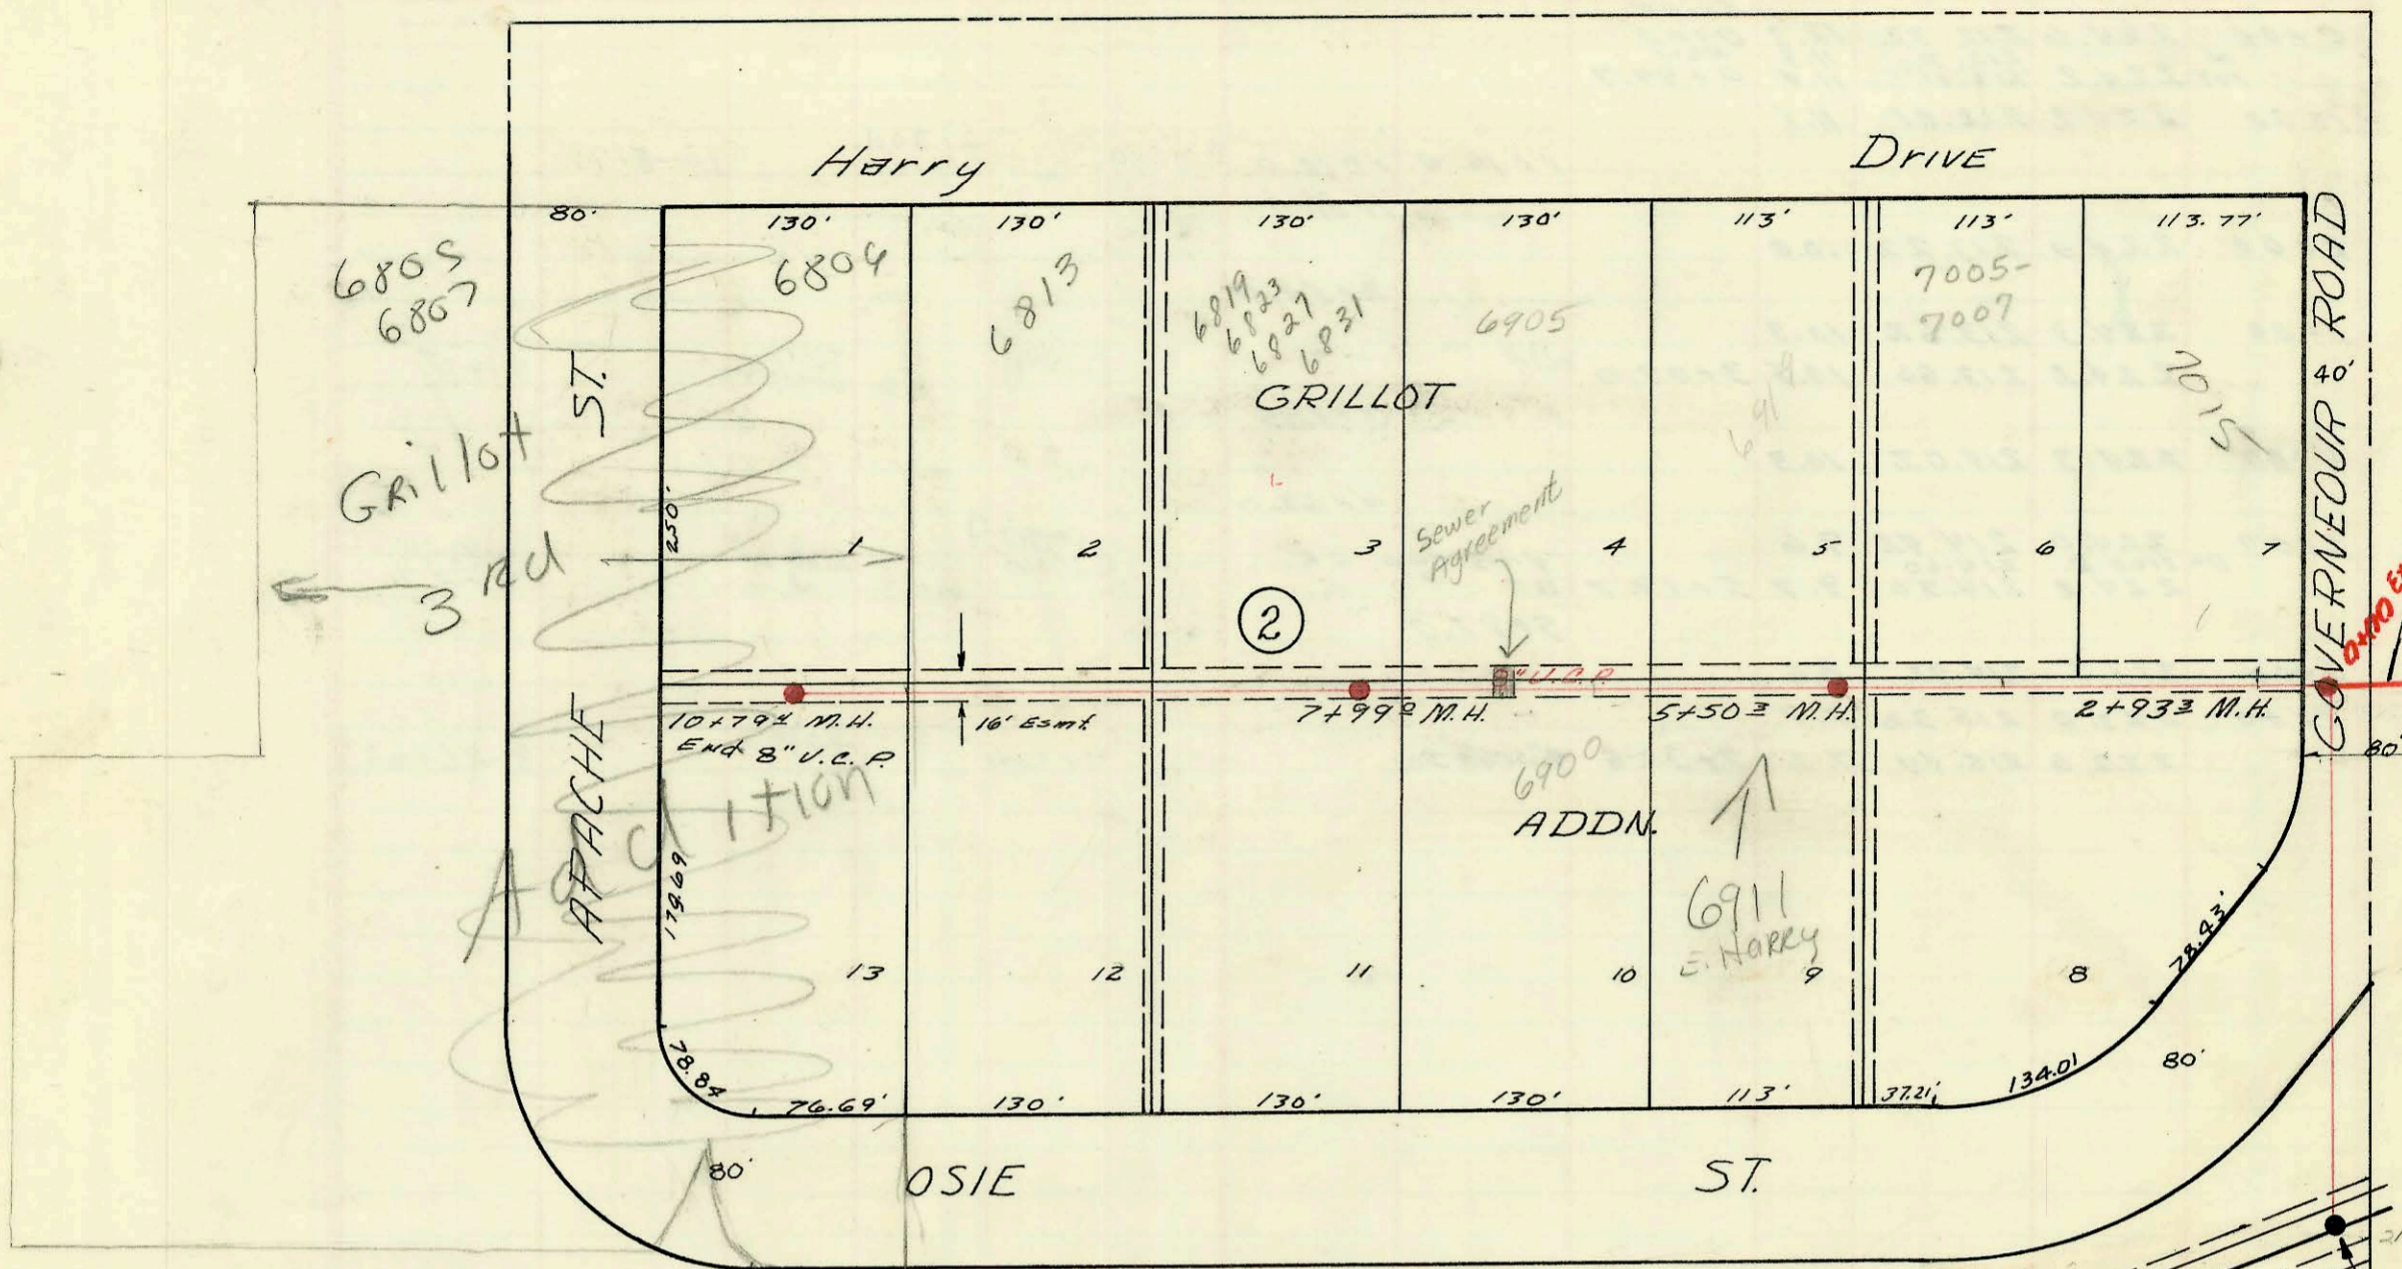


SERVICE RECORD		CONSTRUCTION RECORD	
DATE OF SERVICE	BY WHOM	DATE OF CONSTRUCTION	BY WHOM

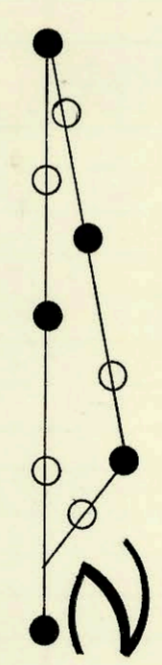

Private S.S. for TRAIL - N. S. Mill. Inc.  
 Built by: M.D. Street Contract Co.  
 Booked 2/25/69  
 at 10:55 AM  
 of 113.5000' (113.5000')

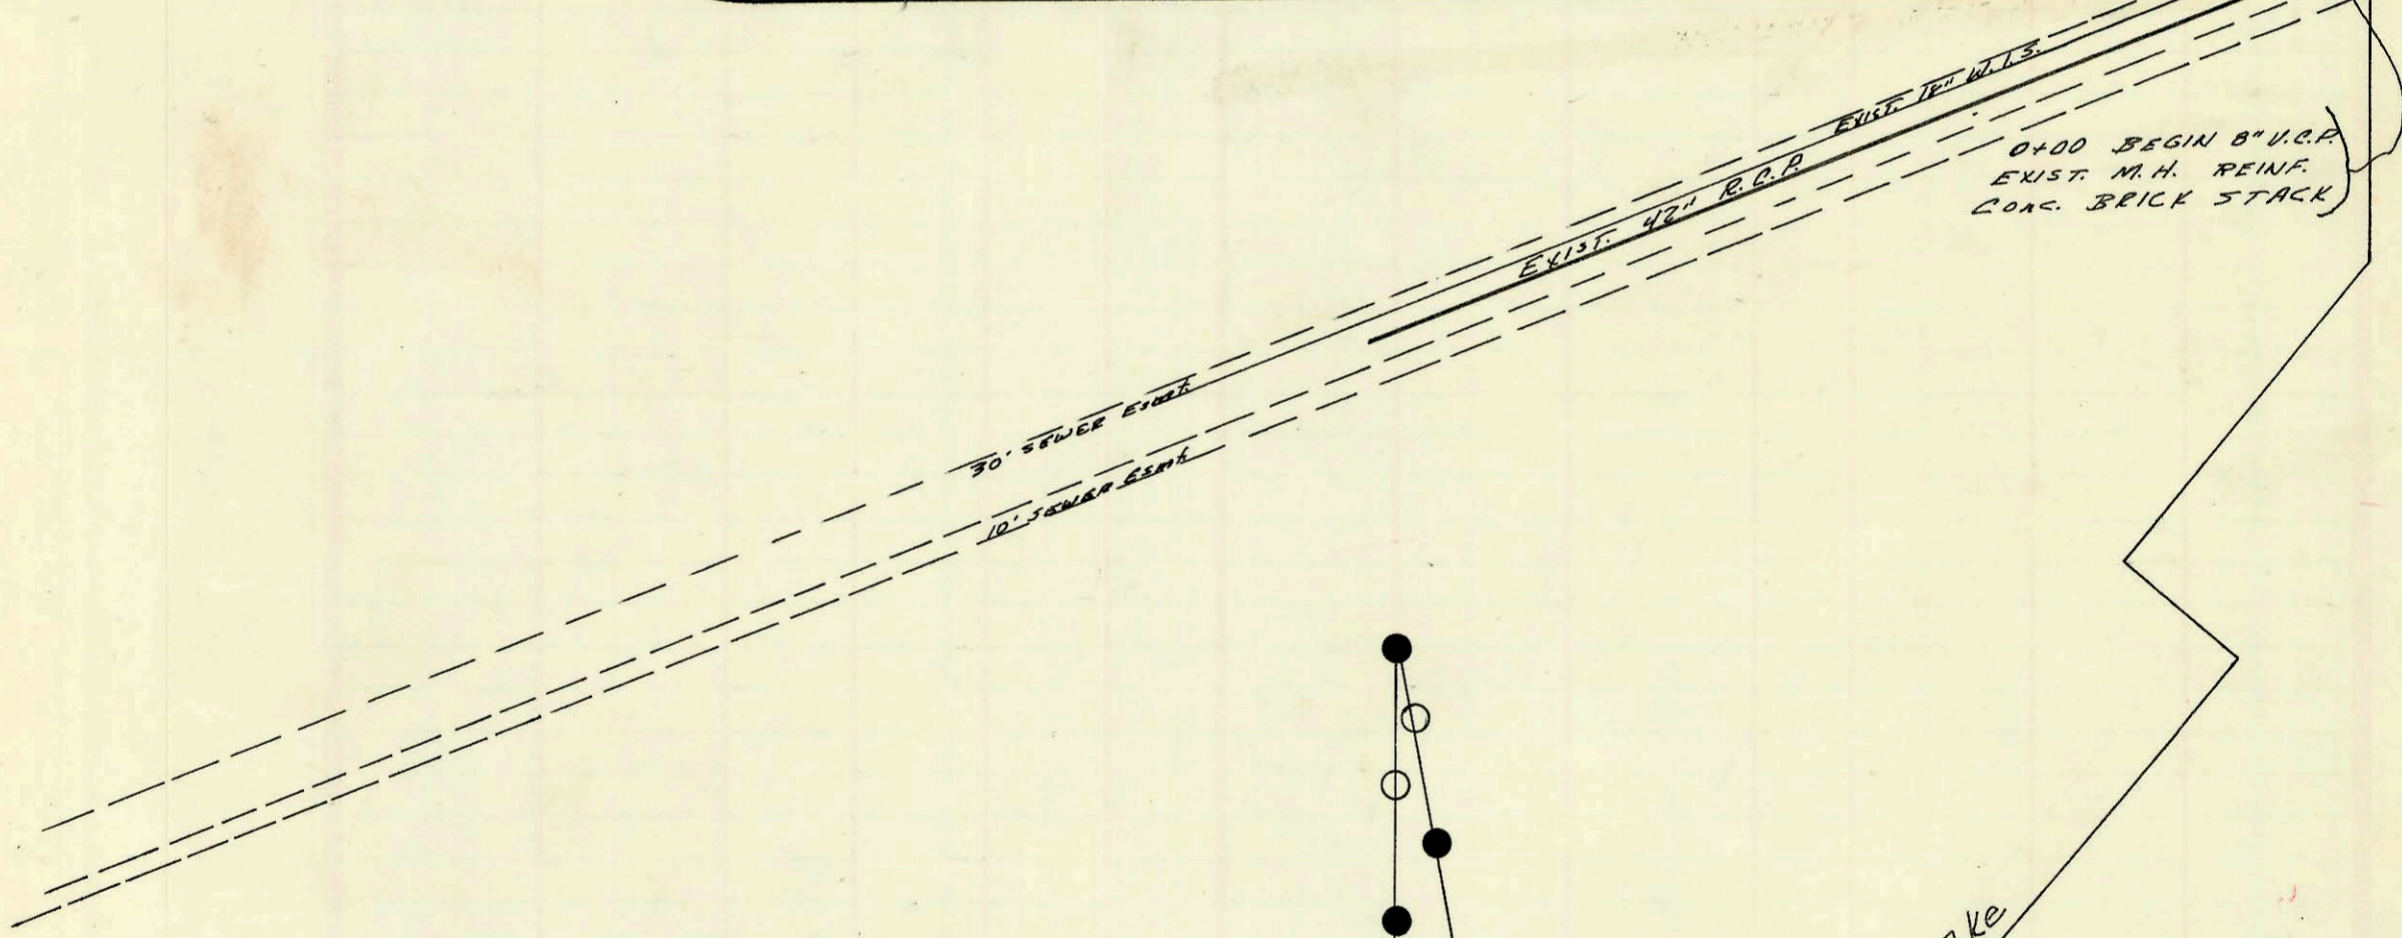

SCALE 1" = 100'

Lateral 42 W.I.S.  
 Booked 2/25/69 Proj. C27-50  
 1459 Utility Contractors

*Handwritten signature*

Kansas

**CONSTRUCTION RECORD**

**SERVICE RECORD**

STATION	ELEVATION		Depth	MANHOLE	4-INCH "Y" BRANCHES		No. of Permit		House Number		DATE OF PERMITS	
	Ground	Grade			North West	South East	North West	South East	North West	South East	North West	South East
0+00	131.7	122.60	9.1	EXIST. MH. 0+00								
1+00	132.0	124.40	7.6									
2+00	133.3	126.20	7.1									
	135.3	127.90	7.4	2+932								
3+00	135.3	127.00	8.3									
					3+30.3	3+34.0	3+36.0	6972	7015 Harry		11-3-82	
4+00	136.4	128.96	7.4									
					Tap 4+67.3	4+52.0	4+54.0	C37733	7005-07 E. Harry		3-16-73	
5+00	138.8	129.96	8.8									
	140.3	130.46	9.8	5+50.3	5+53.3	5+53.3	5+53.3	7483	6919 E. Harry	6911 E. Harry	10-19-83	
6+00	142.0	130.96	11.0		5+61.0	5+63.0	5+63.0	18269	6905 E. Harry		5-4-67	
7+00	144.8	131.96	12.8		6+74.0	6+76.0	6+76.0	C13269			3-26-69	
	144.5	132.96	11.5	7+99.2						6900 E. Dan		11-20-73
8+00	144.5	132.96	11.5									
					8+06.0	8+08.0	8+08.0	C12963	6819-23-27 E. Harry		2-28-69	
9+00	143.6	133.96	9.6									
					9+27.0	9+29.0	9+29.0	C52919		6810 E. Dan		12-24-75
10+00	144.7	134.96	9.7		Tap 10+25.4			C46087	6813 E. Harry		8-5-74	
	145.8	135.76	10.0	10+79.4	10+62.0	10+62.0	10+62.0	C57916	6807 E. Harry		9-28-76	
PRIVATE S.S. FOR TRAIL-N-SAIL, INC.												
0+00	136.5	128.60	1.9	EXISTING MH. 2+93.2								
0+56	132.2	128.82	6.4	0+56.0	NE 1/2 4" stubs	SE 1/2 4" stubs	NE 1/2 SE 1/2 6" MH tap	2428 35496	7215 E. B. Harry	7203 E. Harry	10/4/84 10-19-72	7-3-72

C33354-7203 E. Harry-trailer-trail-7-dail-7-3-73 - Jay Dooter - Spec for 500' (outside city limits) - Rec 130296 7-3-72